


GENERAL NOTE
STUDY HEIGHT OF BENCH WITH TABLE AND CHAIR

GR - IF - 120.1R
石头：葡萄牙米黄
加工：哑光面+自然边+防水
数量：9套

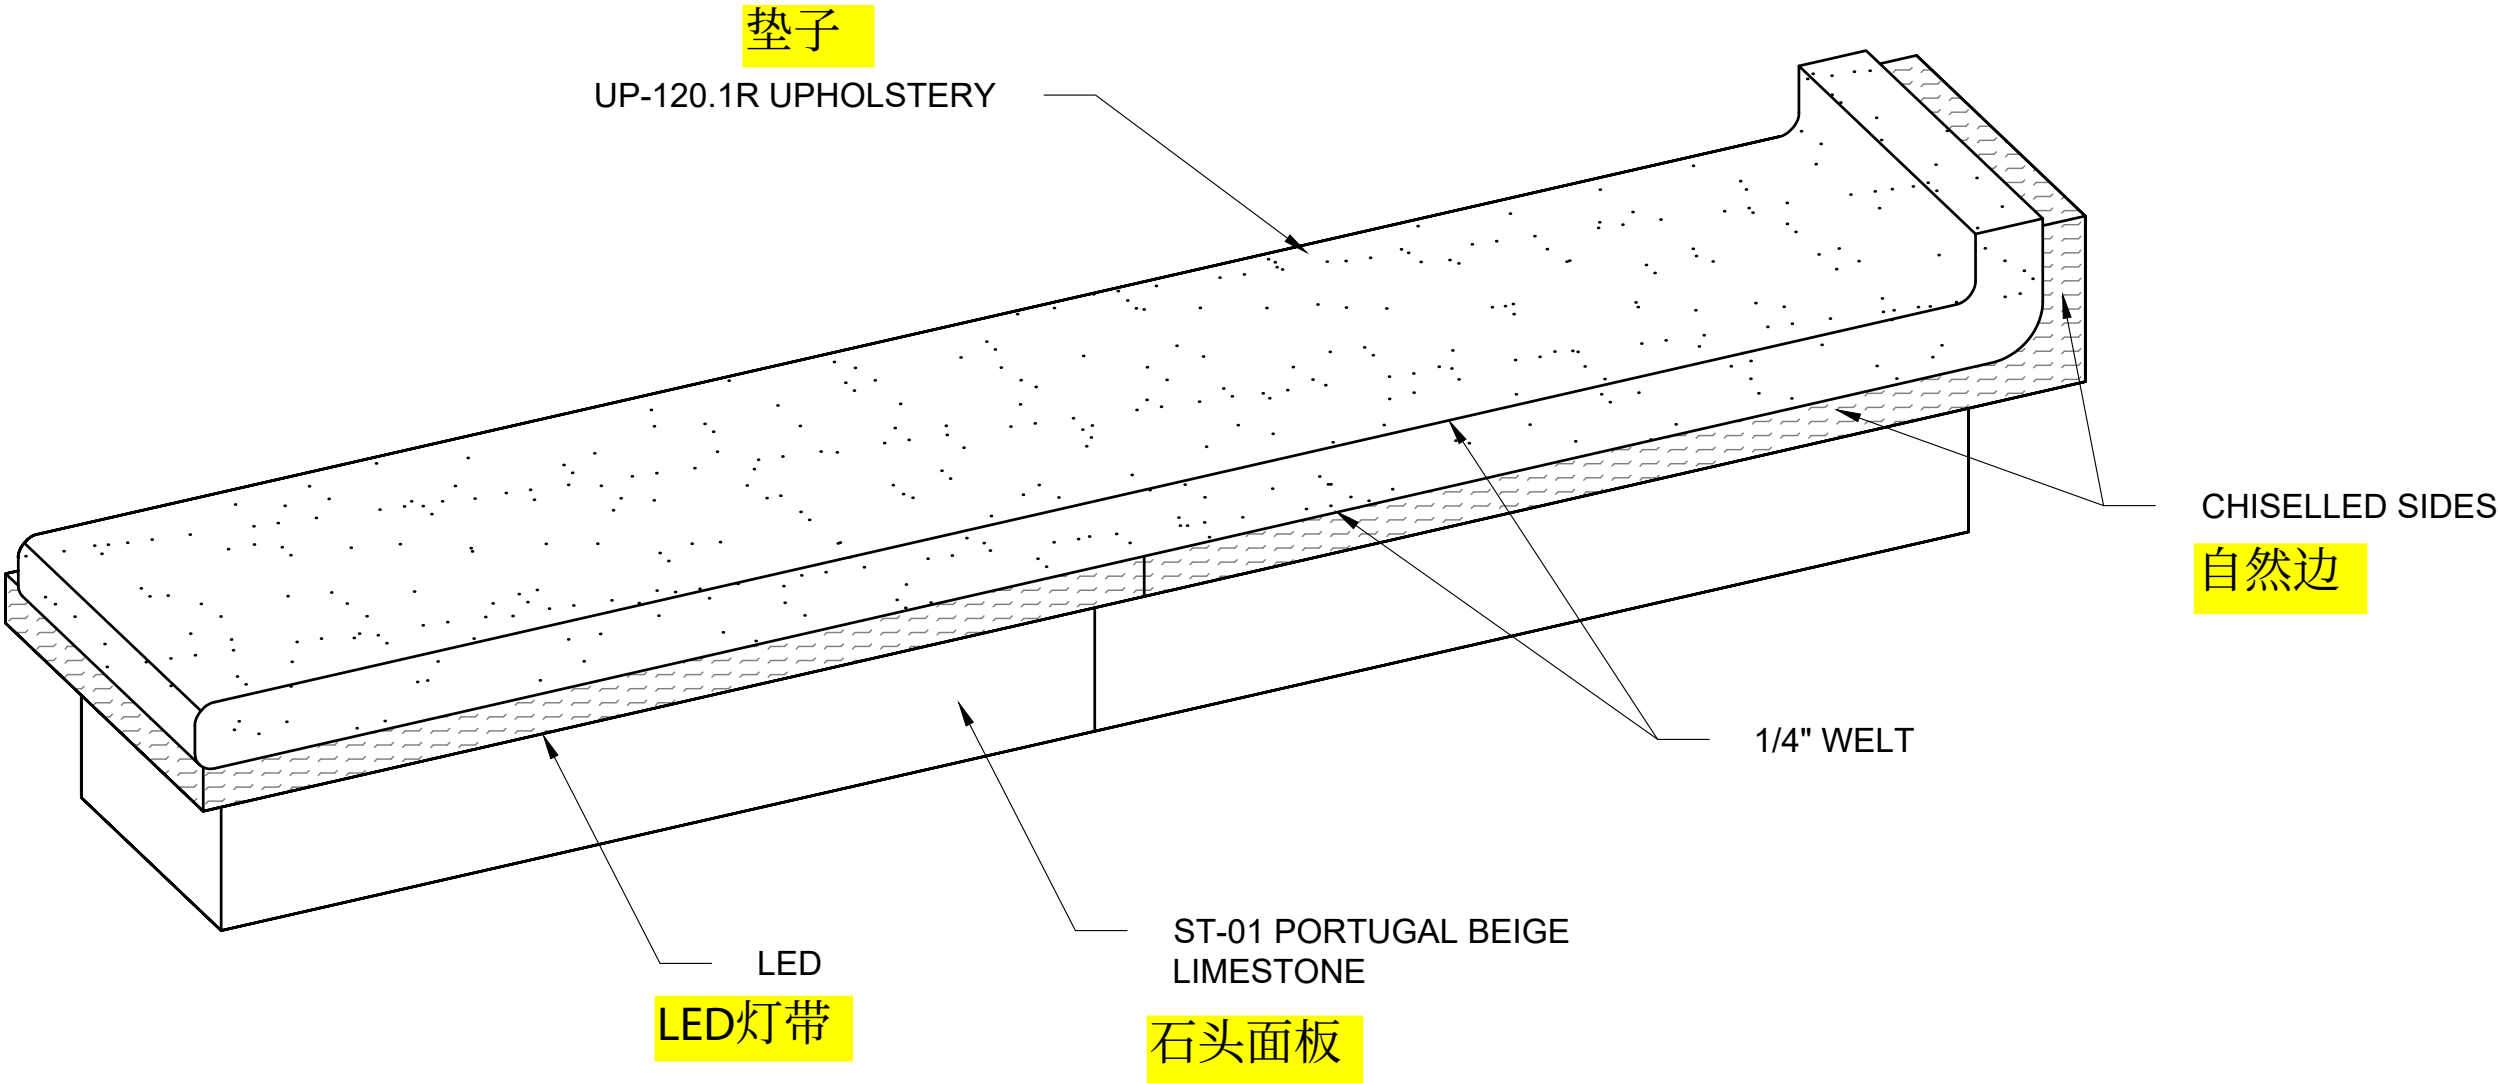


Reviewed No Exceptions Noted ()
Reviewed Exceptions Noted (X)
Revise and Resubmit ()
Rejected ()

By **XAVIER ESCRIBANA** Date **6/30/2025**


ISSUED FOR:	DATE:	BY:
DATE ISSUED	06/25/2025	MK

PROJECT TITLE:
WALLER CREEK
ITEM NUMBER:
GR-IF-120.1R
DESCRIPTION:
BENCH
SPECIFICATIONS:
MATERIAL: ST-01: PORTUGAL BEIGE LIMESTONE UP-120.1R: UPHOLSTERY
FINISH: STONE: HONED SURFACE CHISELLED SURFACE ALL SURFACES: MATTE PROTECTIVE SEALANT
NOTES:
JOB NO: 320C
DRAWN BY: MK/YA
DATE DRAWN: 6/25/2025
SCALE: AS NOTED
SHEET:

PLAN VIEW
平面剖面图

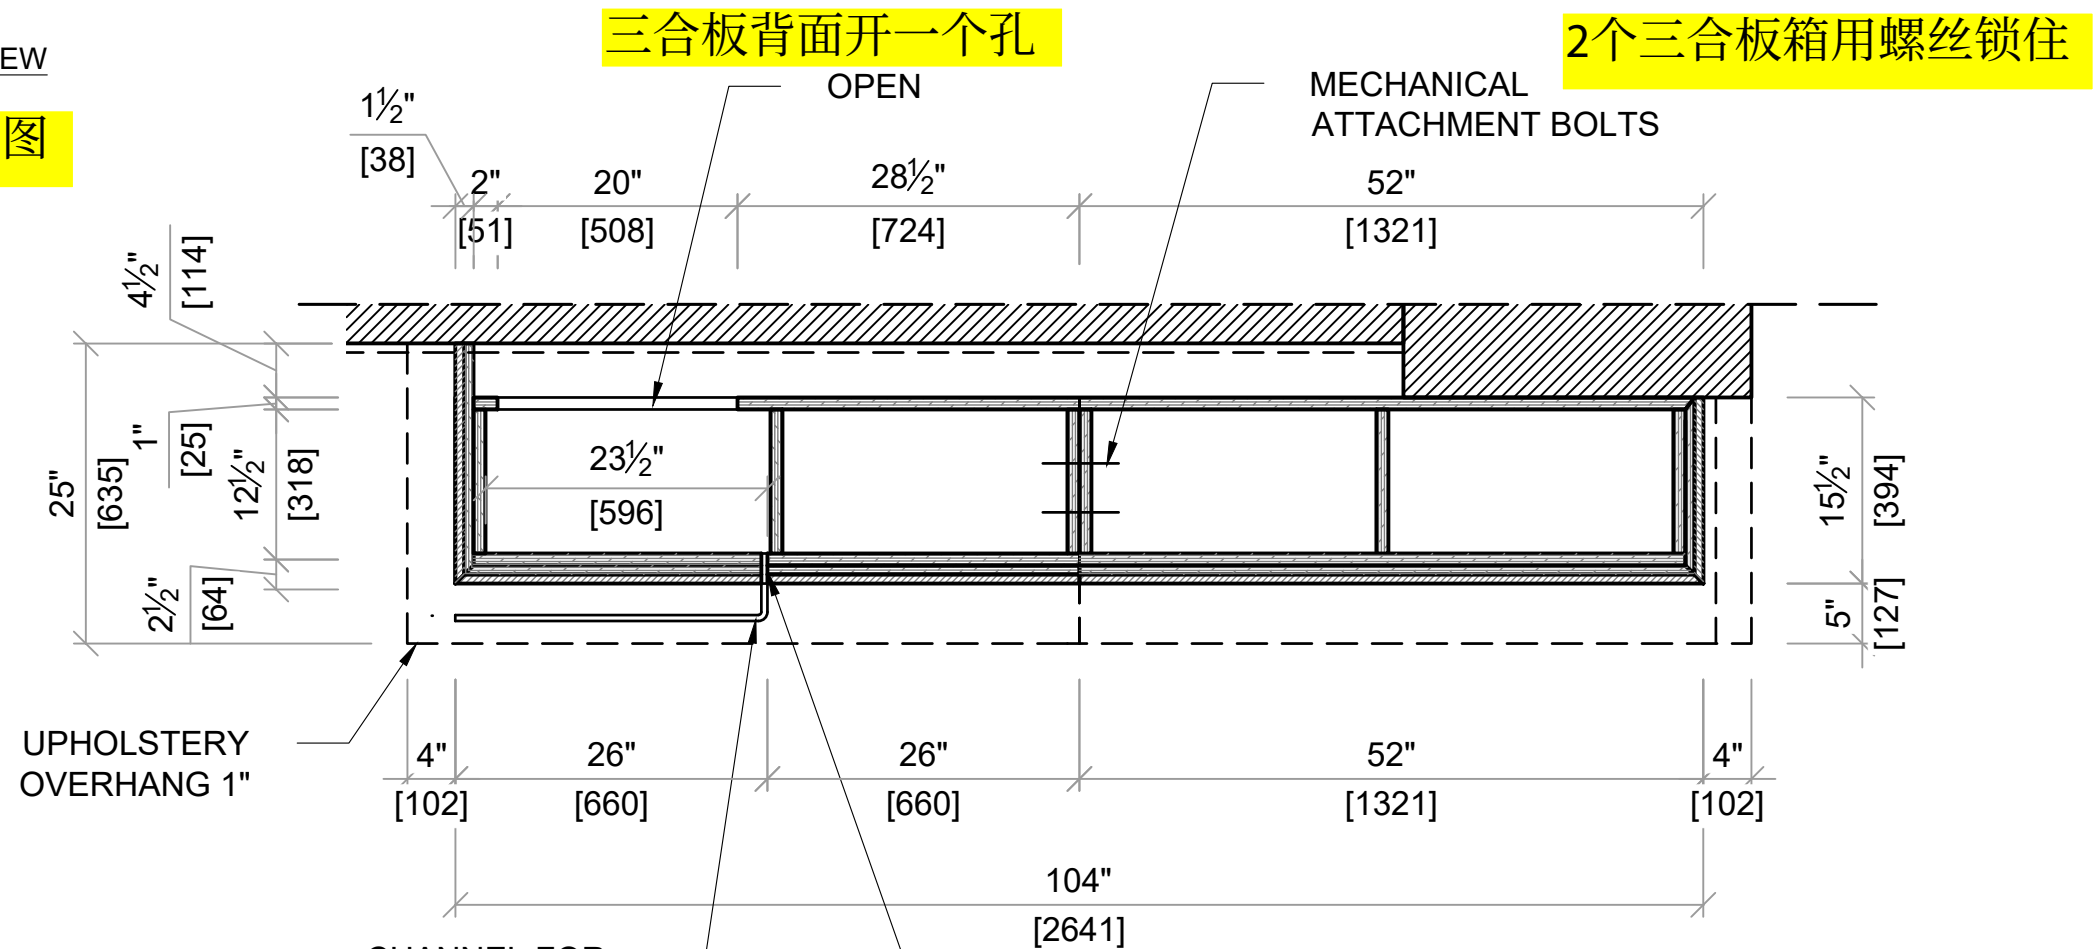

SECTION A
立面剖面图

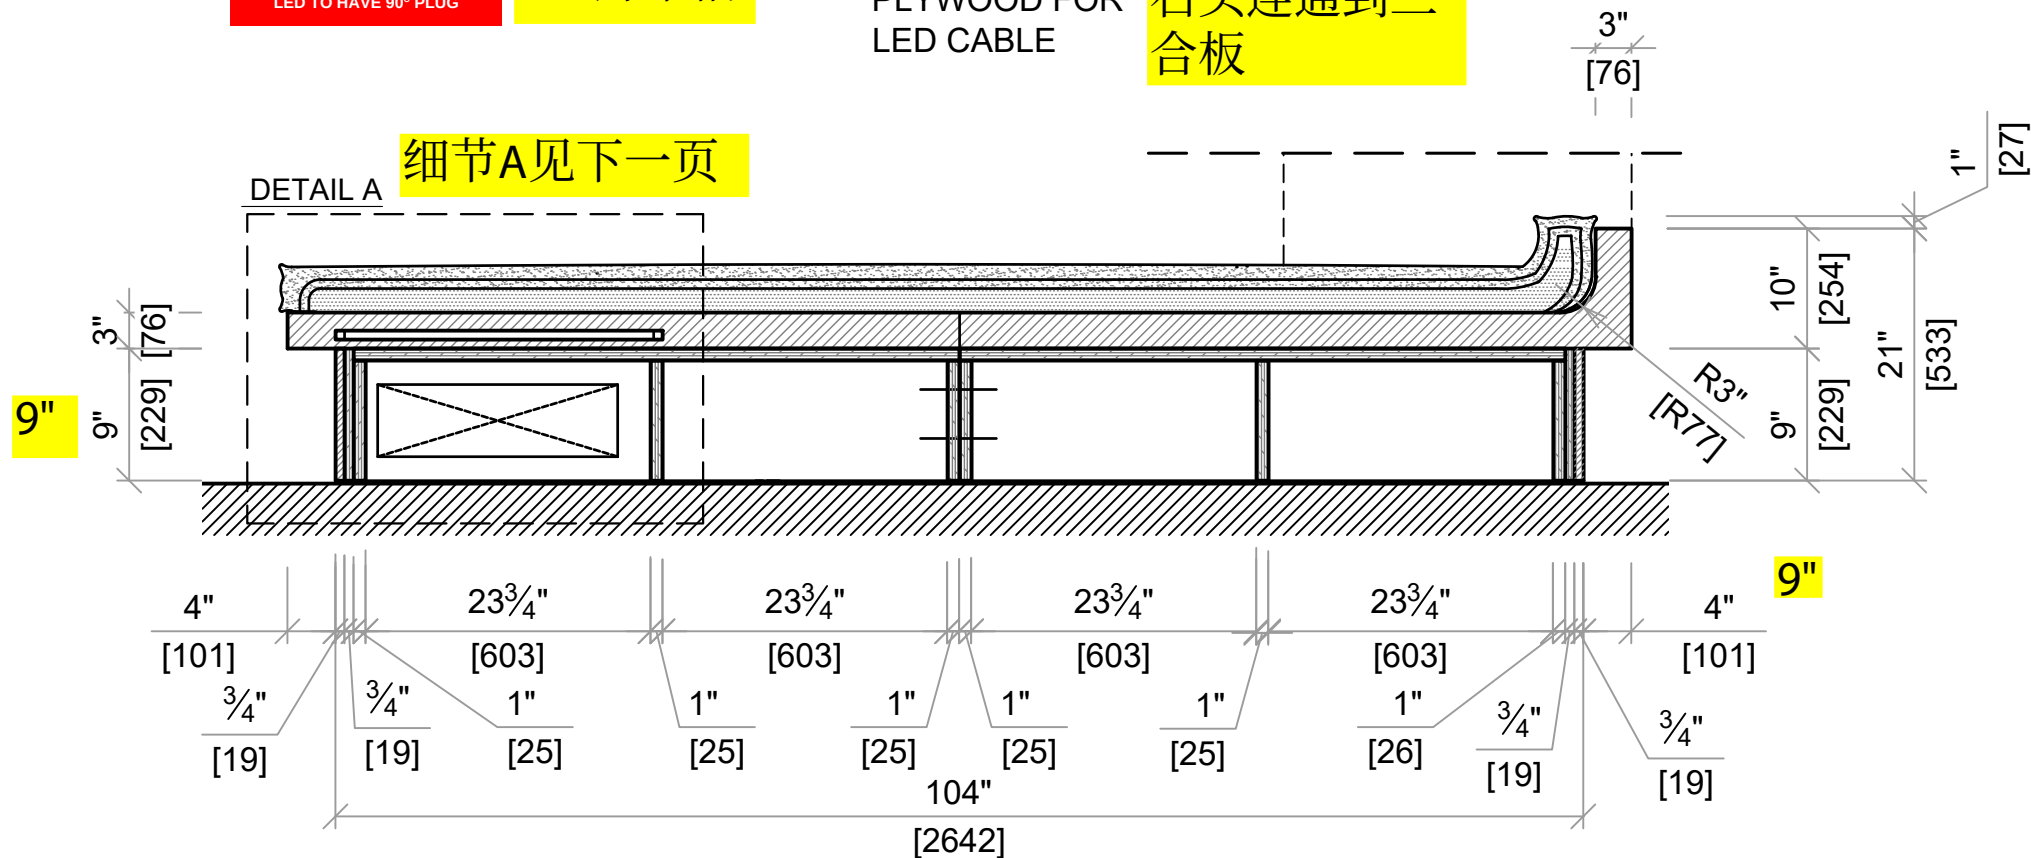

SCALE 3/4" = 1' 0"

ISSUED FOR:	DATE:	BY:
DATE ISSUED	06/25/2025	MK

PROJECT TITLE:
WALLER CREEK


ITEM NUMBER:
GR-IF-120.1R

DESCRIPTION:
BENCH

SPECIFICATIONS:
MATERIAL:
ST-01: PORTUGAL BEIGE LIMESTONE
UP-120.1R: UPHOLSTERY
FINISH:
STONE: HONED SURFACE
CHISELLED SURFACE ALL SURFACES:
MATTE PROTECTIVE SEALANT

NOTES:

JOB NO:	320C
DRAWN BY:	MK/YA
DATE DRAWN:	6/25/2025
SCALE:	AS NOTED
SHEET:	

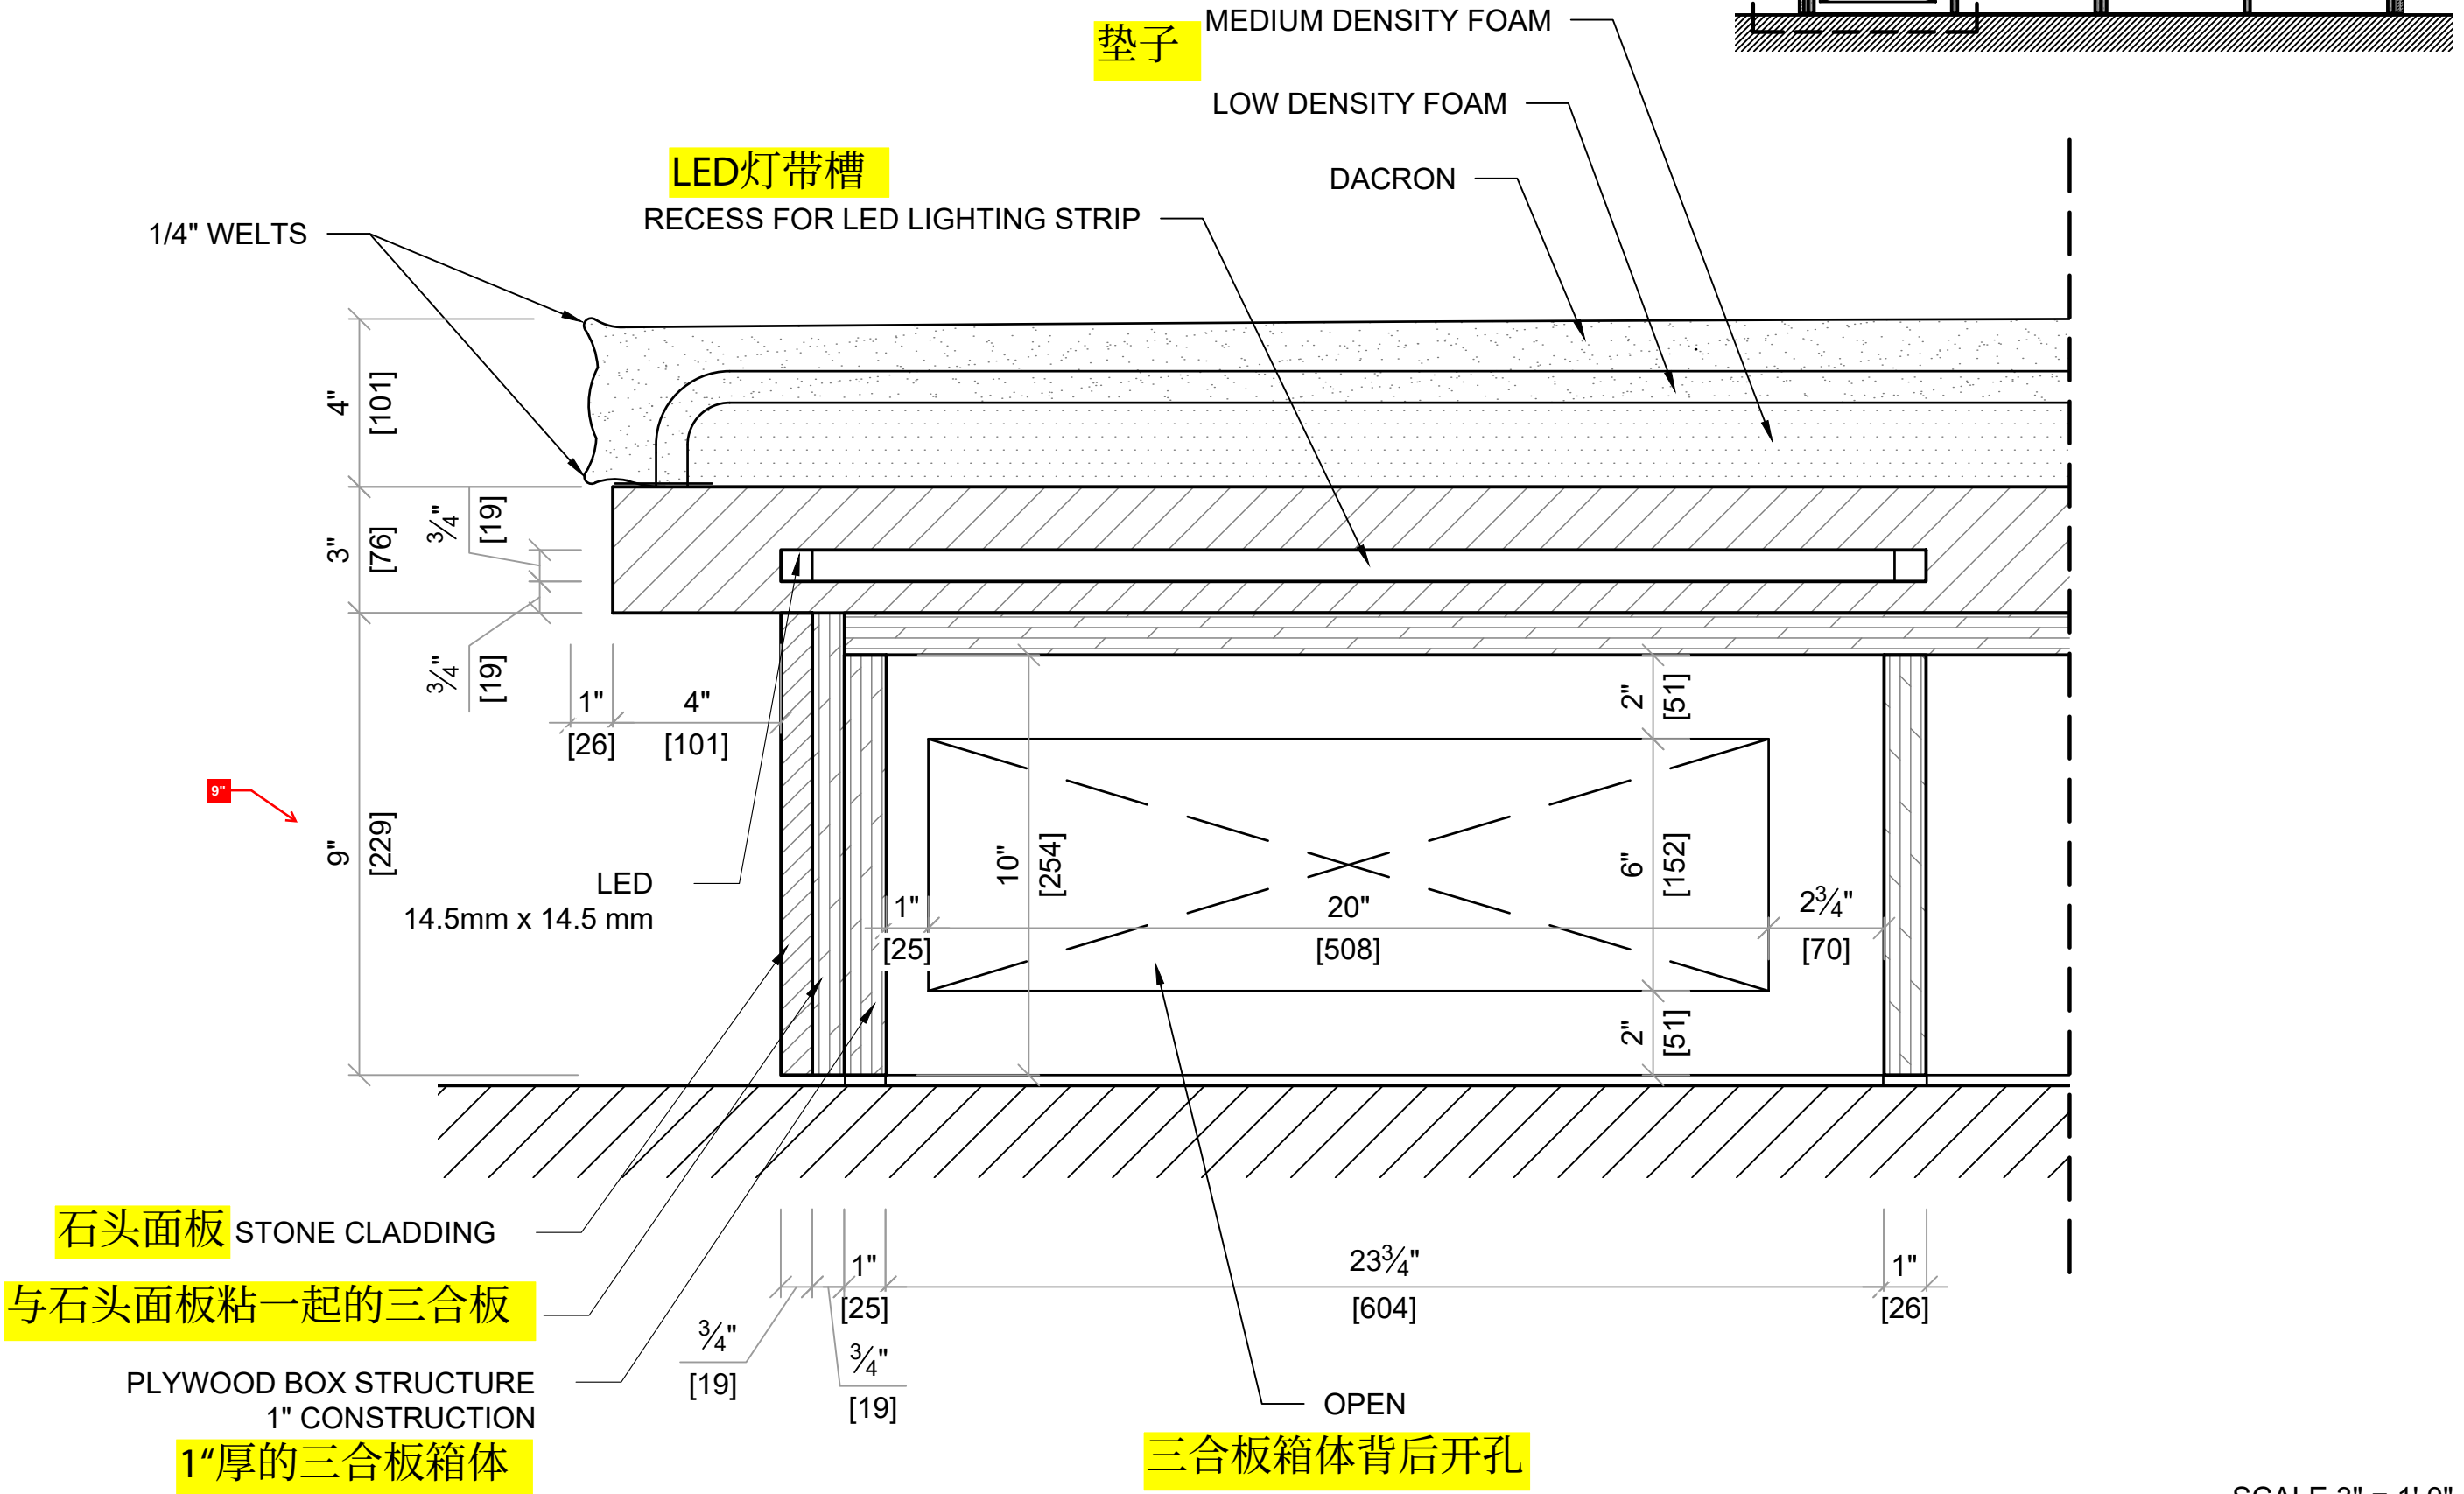


ISSUED FOR:	DATE:	BY:
DATE ISSUED	06/25/2025	MK

PROJECT TITLE:
WALLER CREEK
ITEM NUMBER:
GR-IF-120.1R
DESCRIPTION:
BENCH

SPECIFICATIONS:
MATERIAL:
ST-01: PORTUGAL BEIGE LIMESTONE
UP-120.1R: UPHOLSTERY
FINISH:
STONE: HONED SURFACE
CHISELLED SURFACE ALL SURFACES:
MATTE PROTECTIVE SEALANT

NOTES:
JOB NO:
320C
DRAWN BY:
MK/YA
DATE DRAWN:
6/25/2025
SCALE:
AS NOTED
SHEET:

侧面剖面图

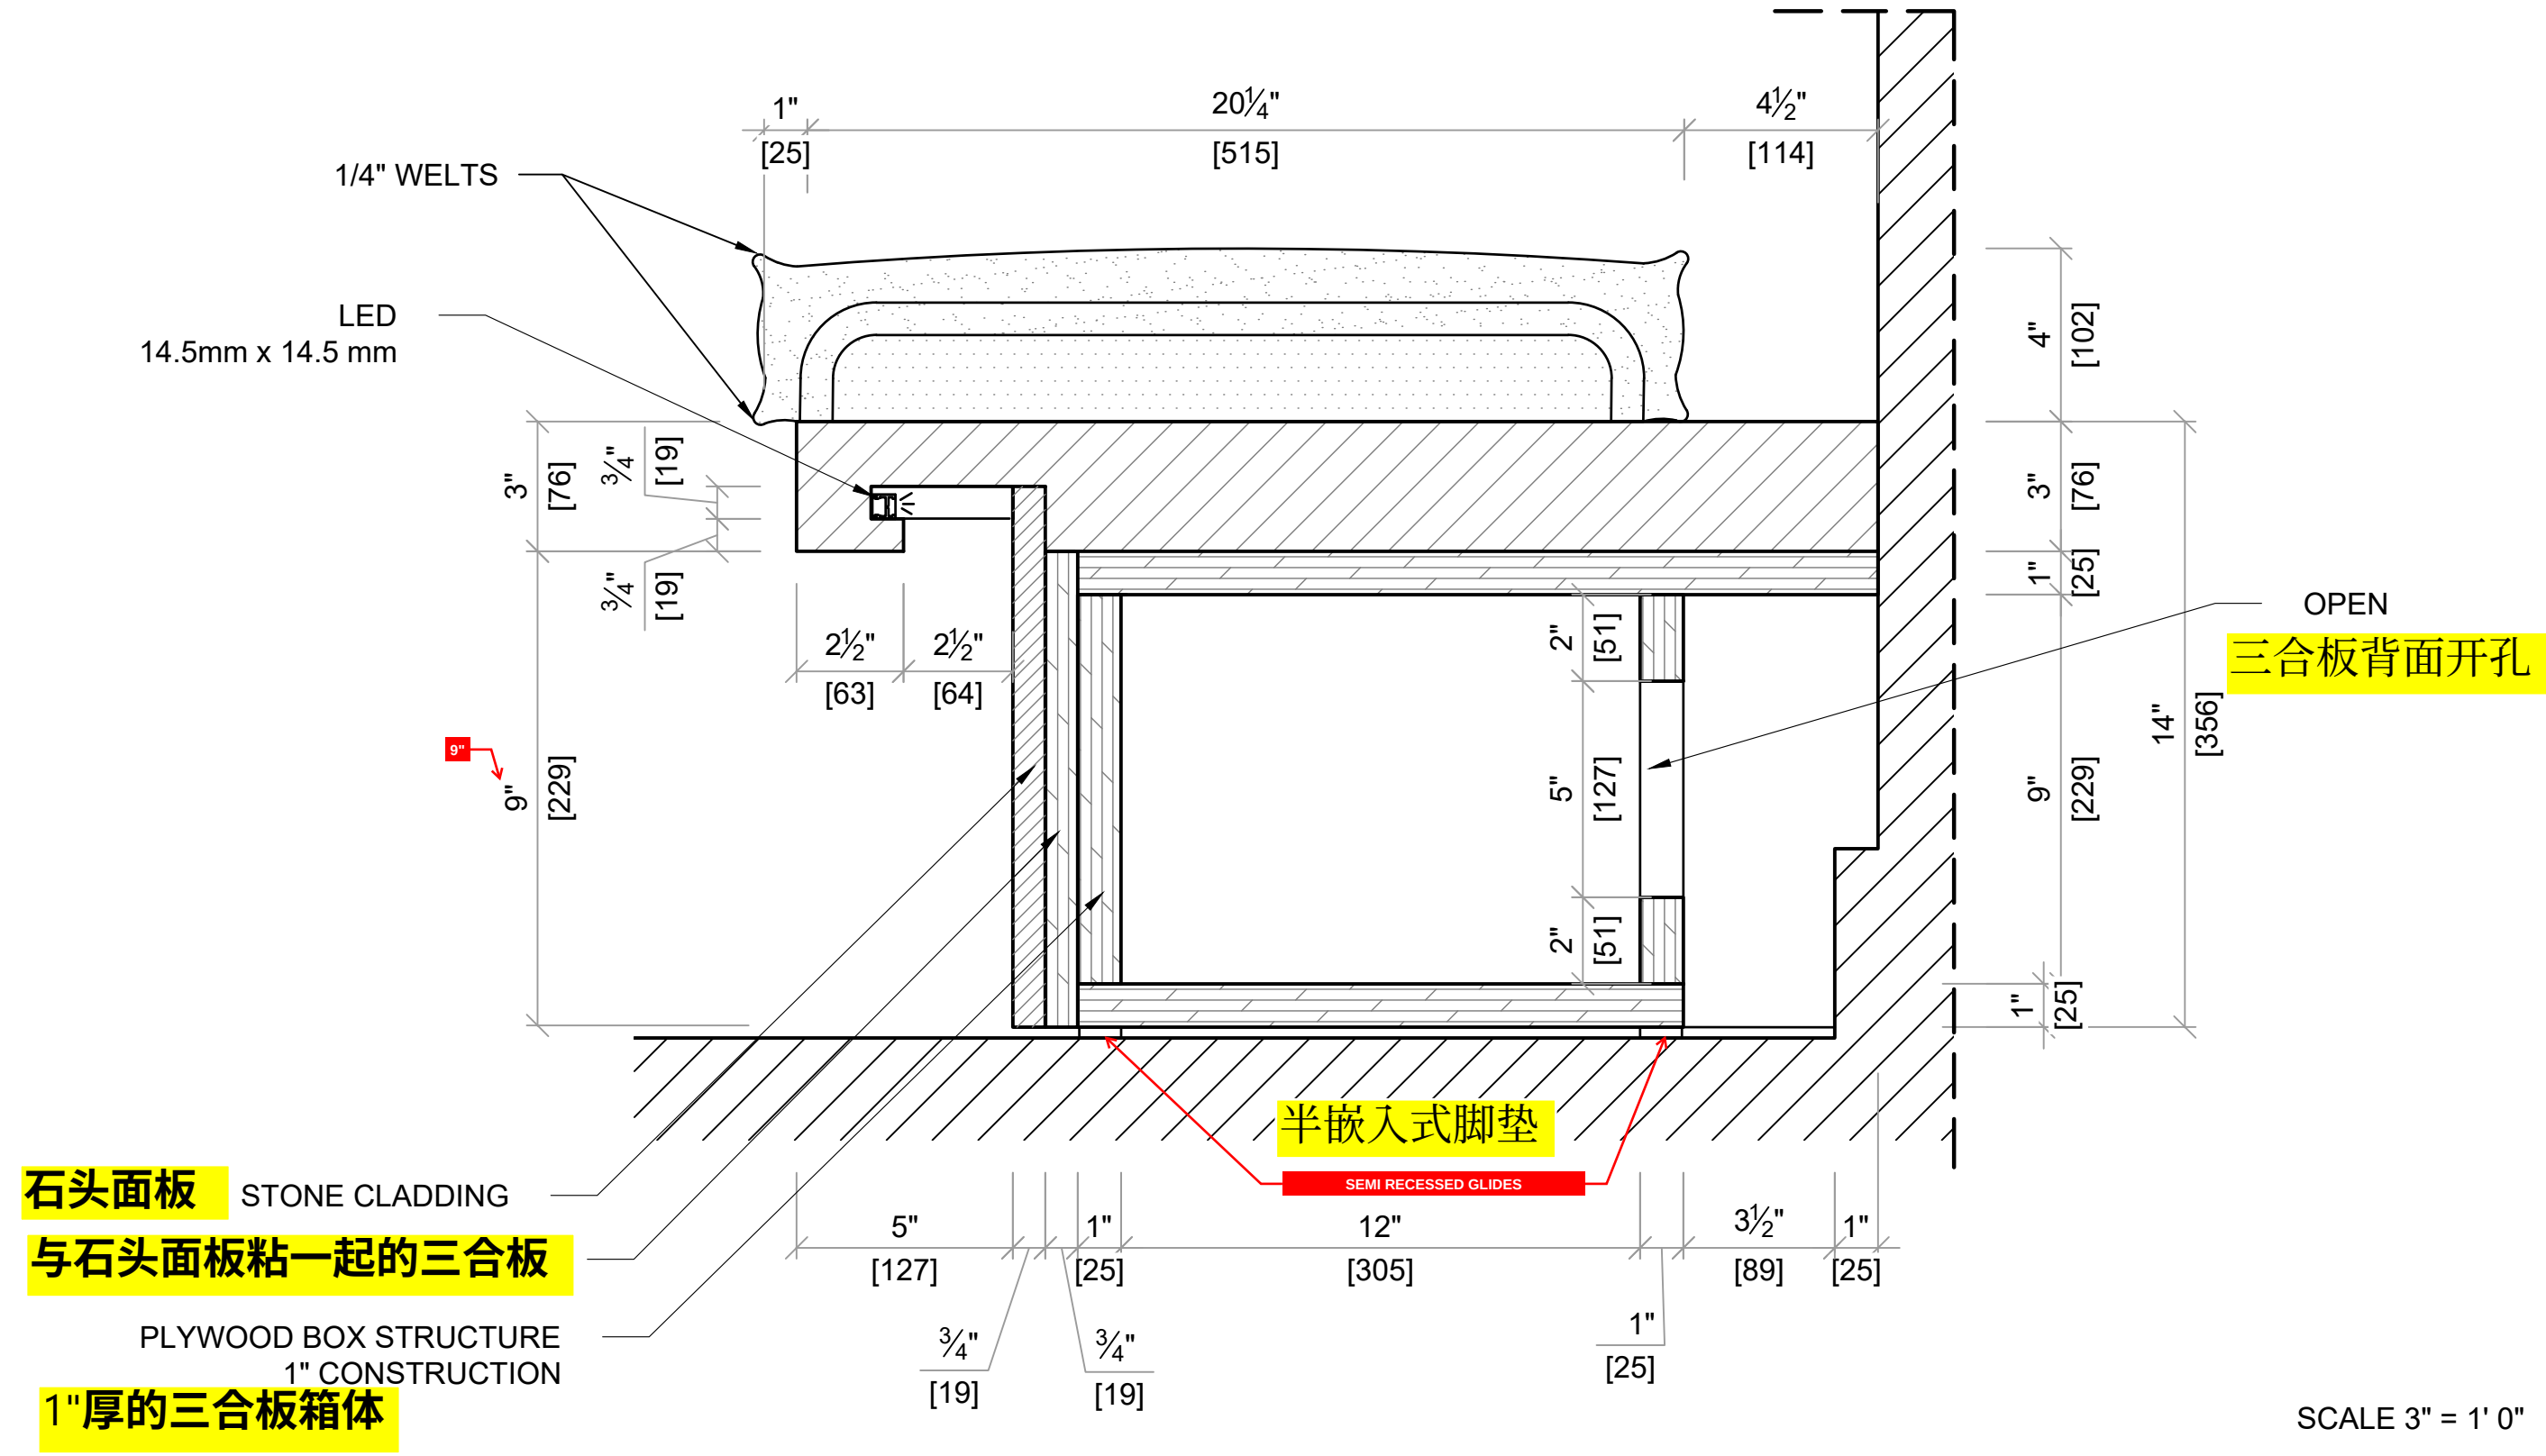

SCALE 3" = 1' 0"

ISSUED FOR:	DATE:	BY:
DATE ISSUED	06/25/2025	MK


PROJECT TITLE:
WALLER CREEK
ITEM NUMBER:
GR-IF-120.1R
DESCRIPTION:
BENCH

SPECIFICATIONS:
MATERIAL:
ST-01: PORTUGAL BEIGE LIMESTONE UP-120.1R: UPHOLSTERY
FINISH:
STONE: HONED SURFACE CHISELLED SURFACE ALL SURFACES: MATTE PROTECTIVE SEALANT

NOTES:
JOB NO:
320C
DRAWN BY:
MK/YA
DATE DRAWN:
6/25/2025
SCALE:
AS NOTED
SHEET:

SECTION C

侧面剖面图C

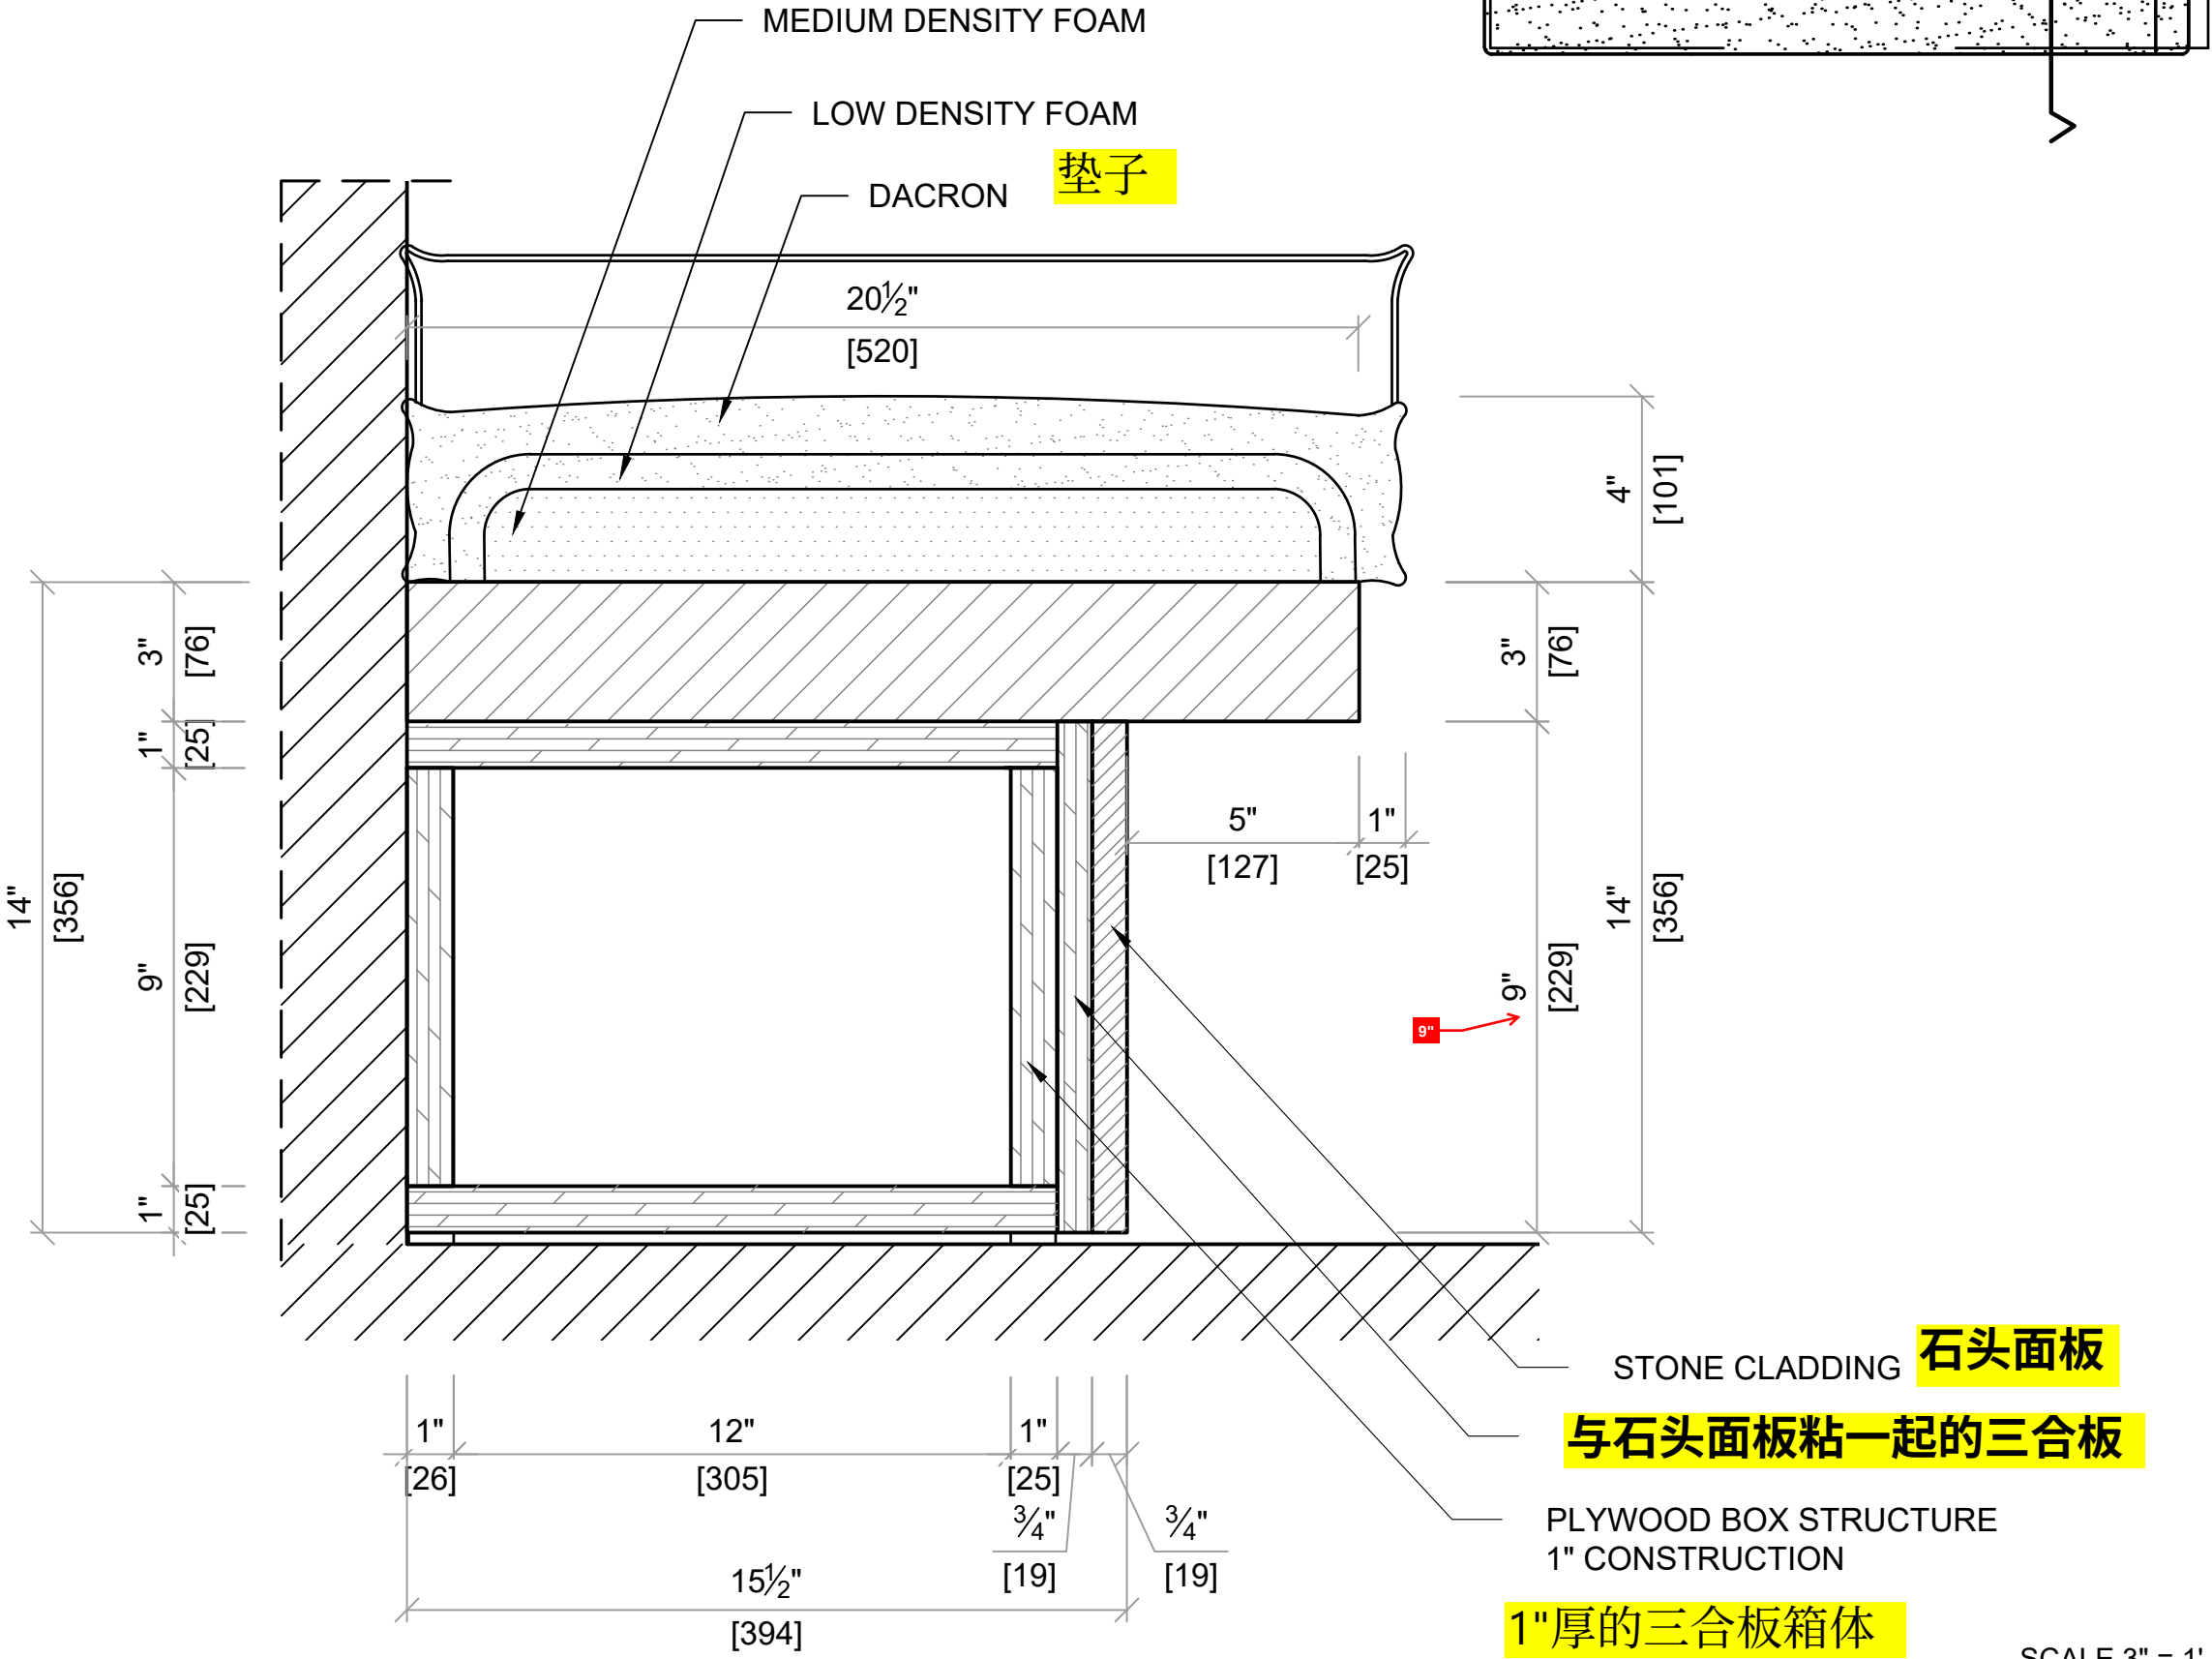

ISSUED FOR:	DATE:	BY:
DATE ISSUED	06/25/2025	MK

PROJECT TITLE:

WALLER CREEK

ITEM NUMBER:

GR-IF-120.1R

DESCRIPTION:

BENCH

SPECIFICATIONS:

MATERIAL:

ST-01: PORTUGAL BEIGE LIMESTONE
UP-120.1R: UPHOLSTERY

FINISH:


STONE: HONED SURFACE
CHISELLED SURFACE ALL SURFACES:
MATTE PROTECTIVE SEALANT

NOTES:

JOB NO:	320C
DRAWN BY:	MK/YA
DATE DRAWN:	6/25/2025
SCALE:	AS NOTED
SHEET:	

GENERAL NOTE
STUDY HEIGHT OF BENCH WITH TABLE AND CHAIR

GR - IF - 120.4
石头：葡萄牙米黄
加工：哑光面+自然边+防水
数量：6套

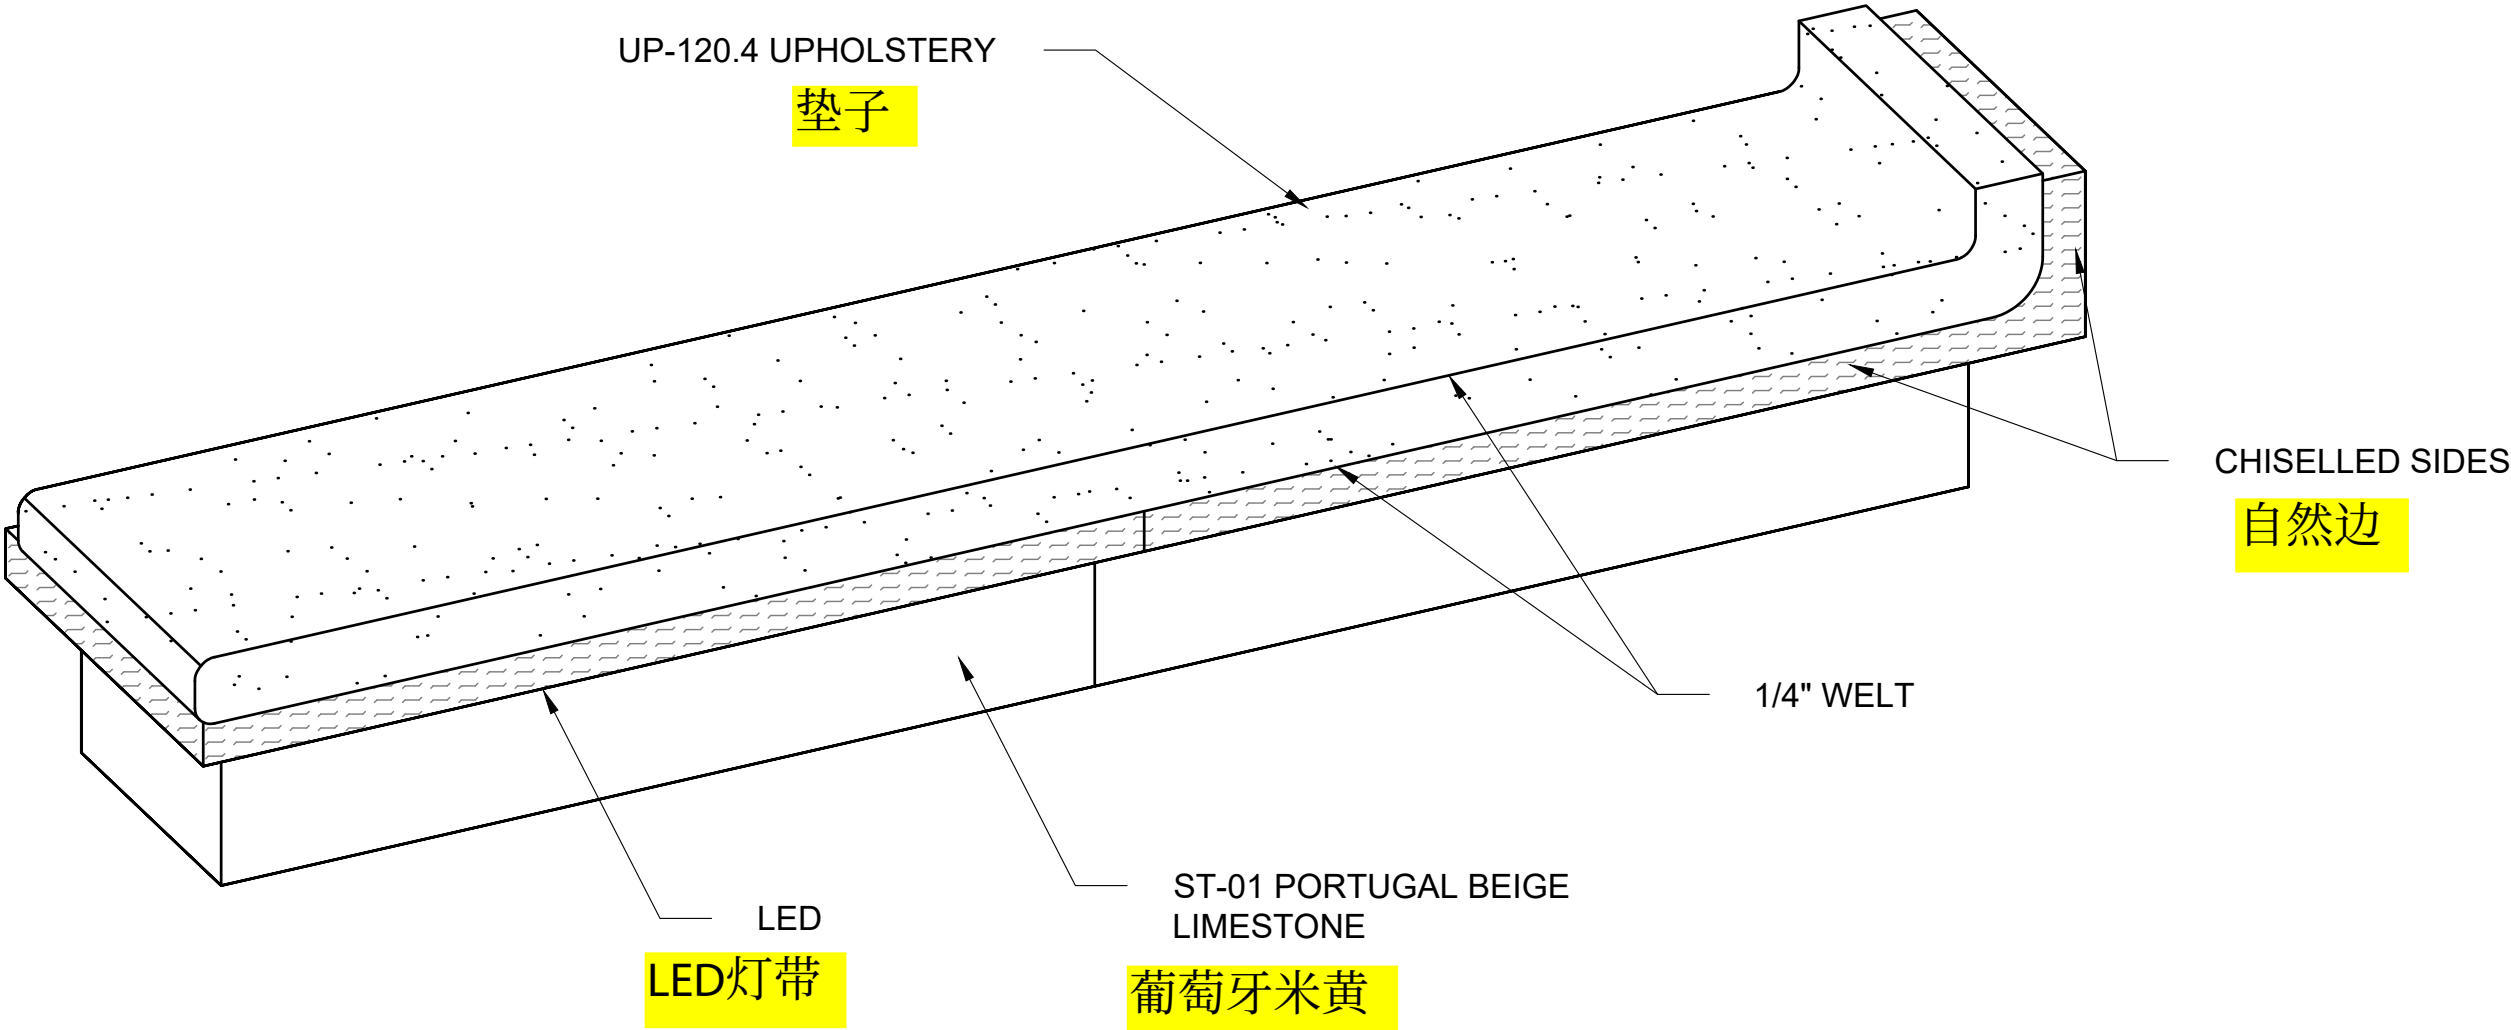

Reviewed No Exceptions Noted ()
Reviewed Exceptions Noted (X)
Revise and Resubmit ()
Rejected ()

By **XAVIER ESCRIBU** Date **6/30/2025**

ISSUED FOR:	DATE:	BY:
DATE ISSUED	06/25/2025	MK


PROJECT TITLE:
WALLER CREEK
ITEM NUMBER:
GR-IF-120.4
DESCRIPTION:
BENCH

SPECIFICATIONS:
MATERIAL: ST-01: PORTUGAL BEIGE LIMESTONE UP-120.4: UPHOLSTERY
FINISH: STONE: HONED SURFACE CHISELLED SURFACE ALL SURFACES: MATTE PROTECTIVE SEALANT
NOTES:

JOB NO:	320C
DRAWN BY:	MK/YA
DATE DRAWN:	6/26/2025
SCALE:	AS NOTED
SHEET:	


PLAN VIEW

平面剖面图

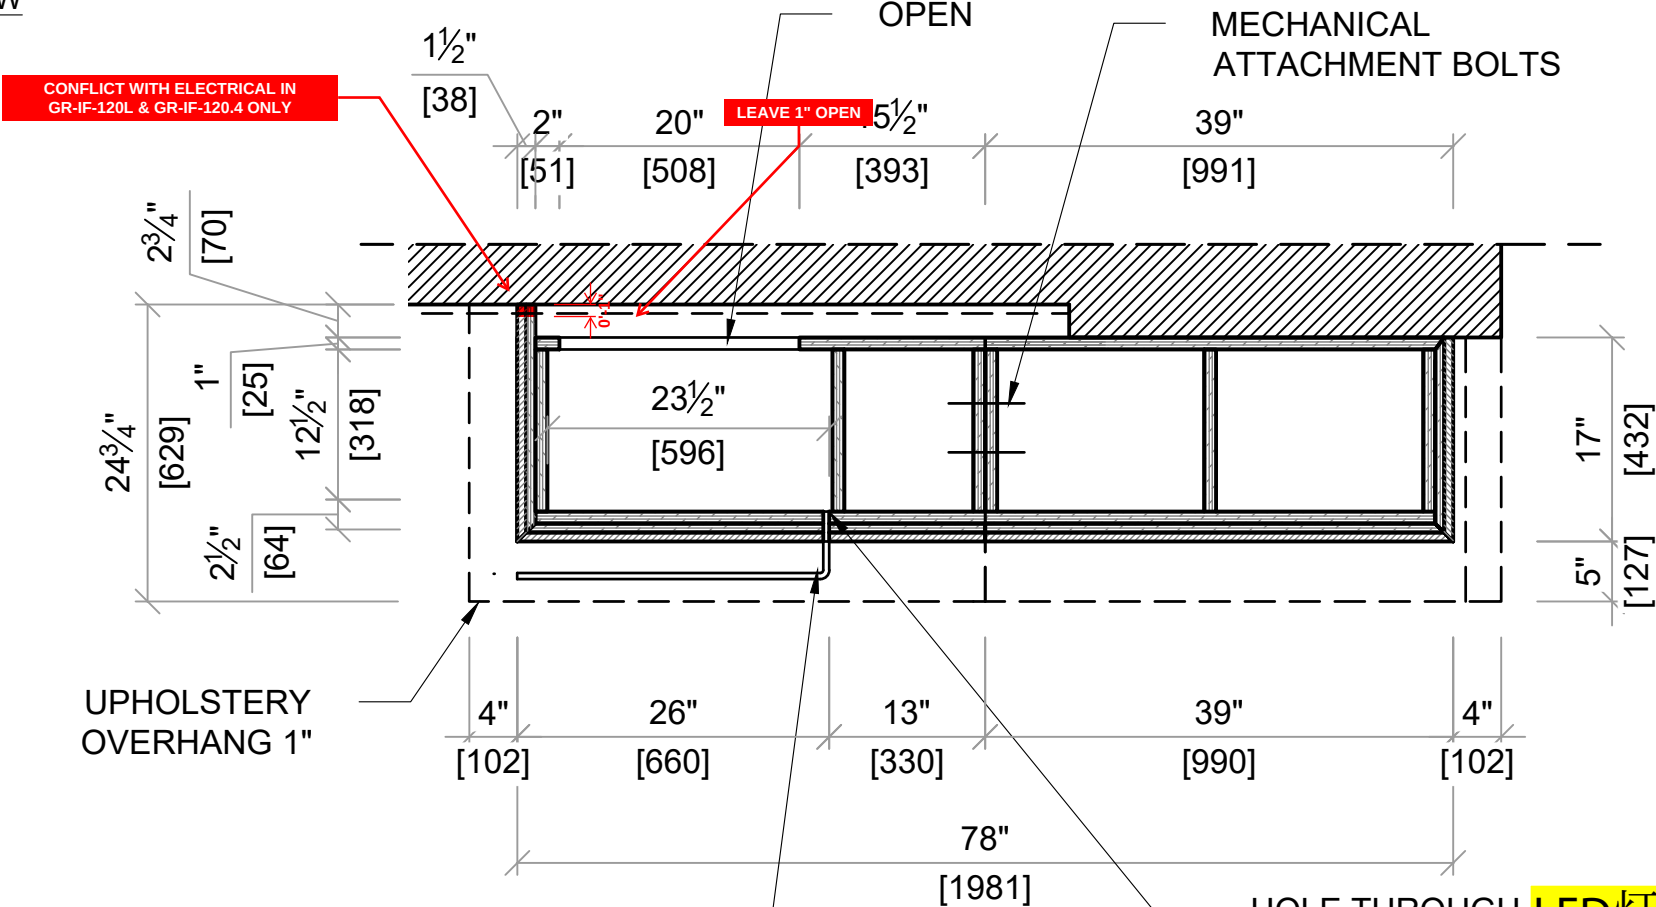

SECTION A

立面剖面图A

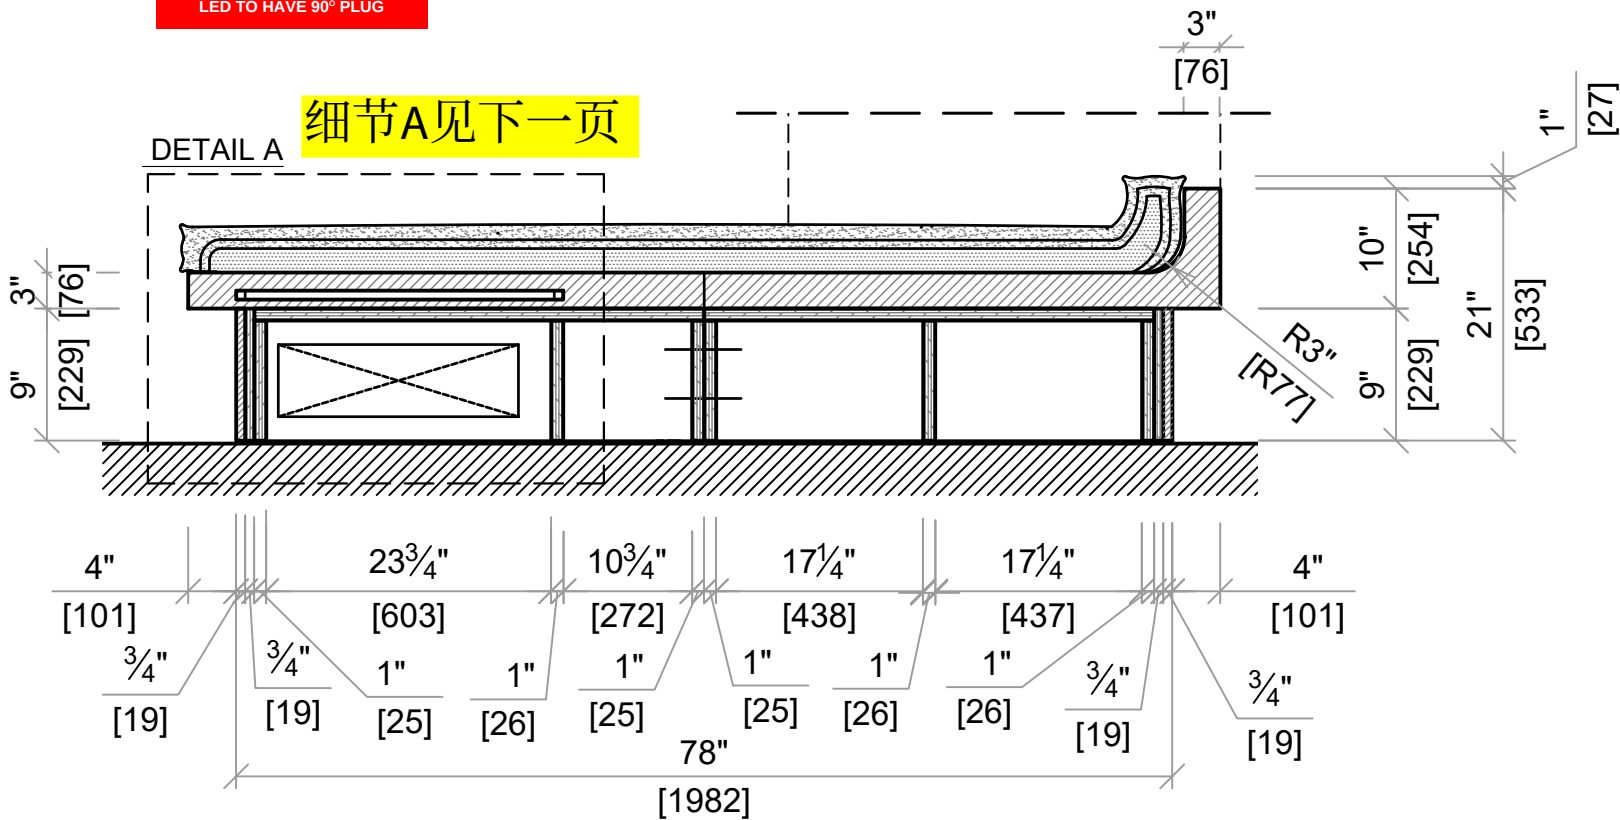



SCALE 3/4" = 1' 0"

ISSUED FOR:	DATE:	BY:
DATE ISSUED	06/25/2025	MK

PROJECT TITLE:
WALLER CREEK
ITEM NUMBER:
GR-IF-120.4
DESCRIPTION:
BENCH

SPECIFICATIONS:
MATERIAL:
ST-01: PORTUGAL BEIGE LIMESTONE
UP-120.4: UPHOLSTERY
FINISH:
STONE: HONED SURFACE
CHISELLED SURFACE ALL SURFACES:
MATTE PROTECTIVE SEALANT

NOTES:
JOB NO:
320C
DRAWN BY:
MK/YA
DATE DRAWN:
6/26/2025
SCALE:
AS NOTED
SHEET:

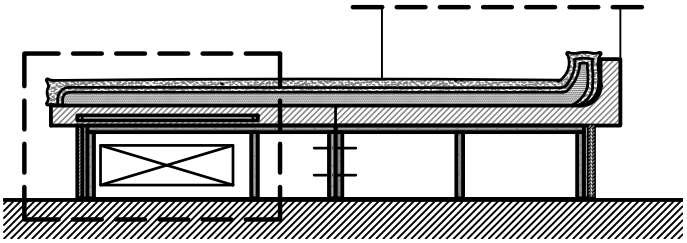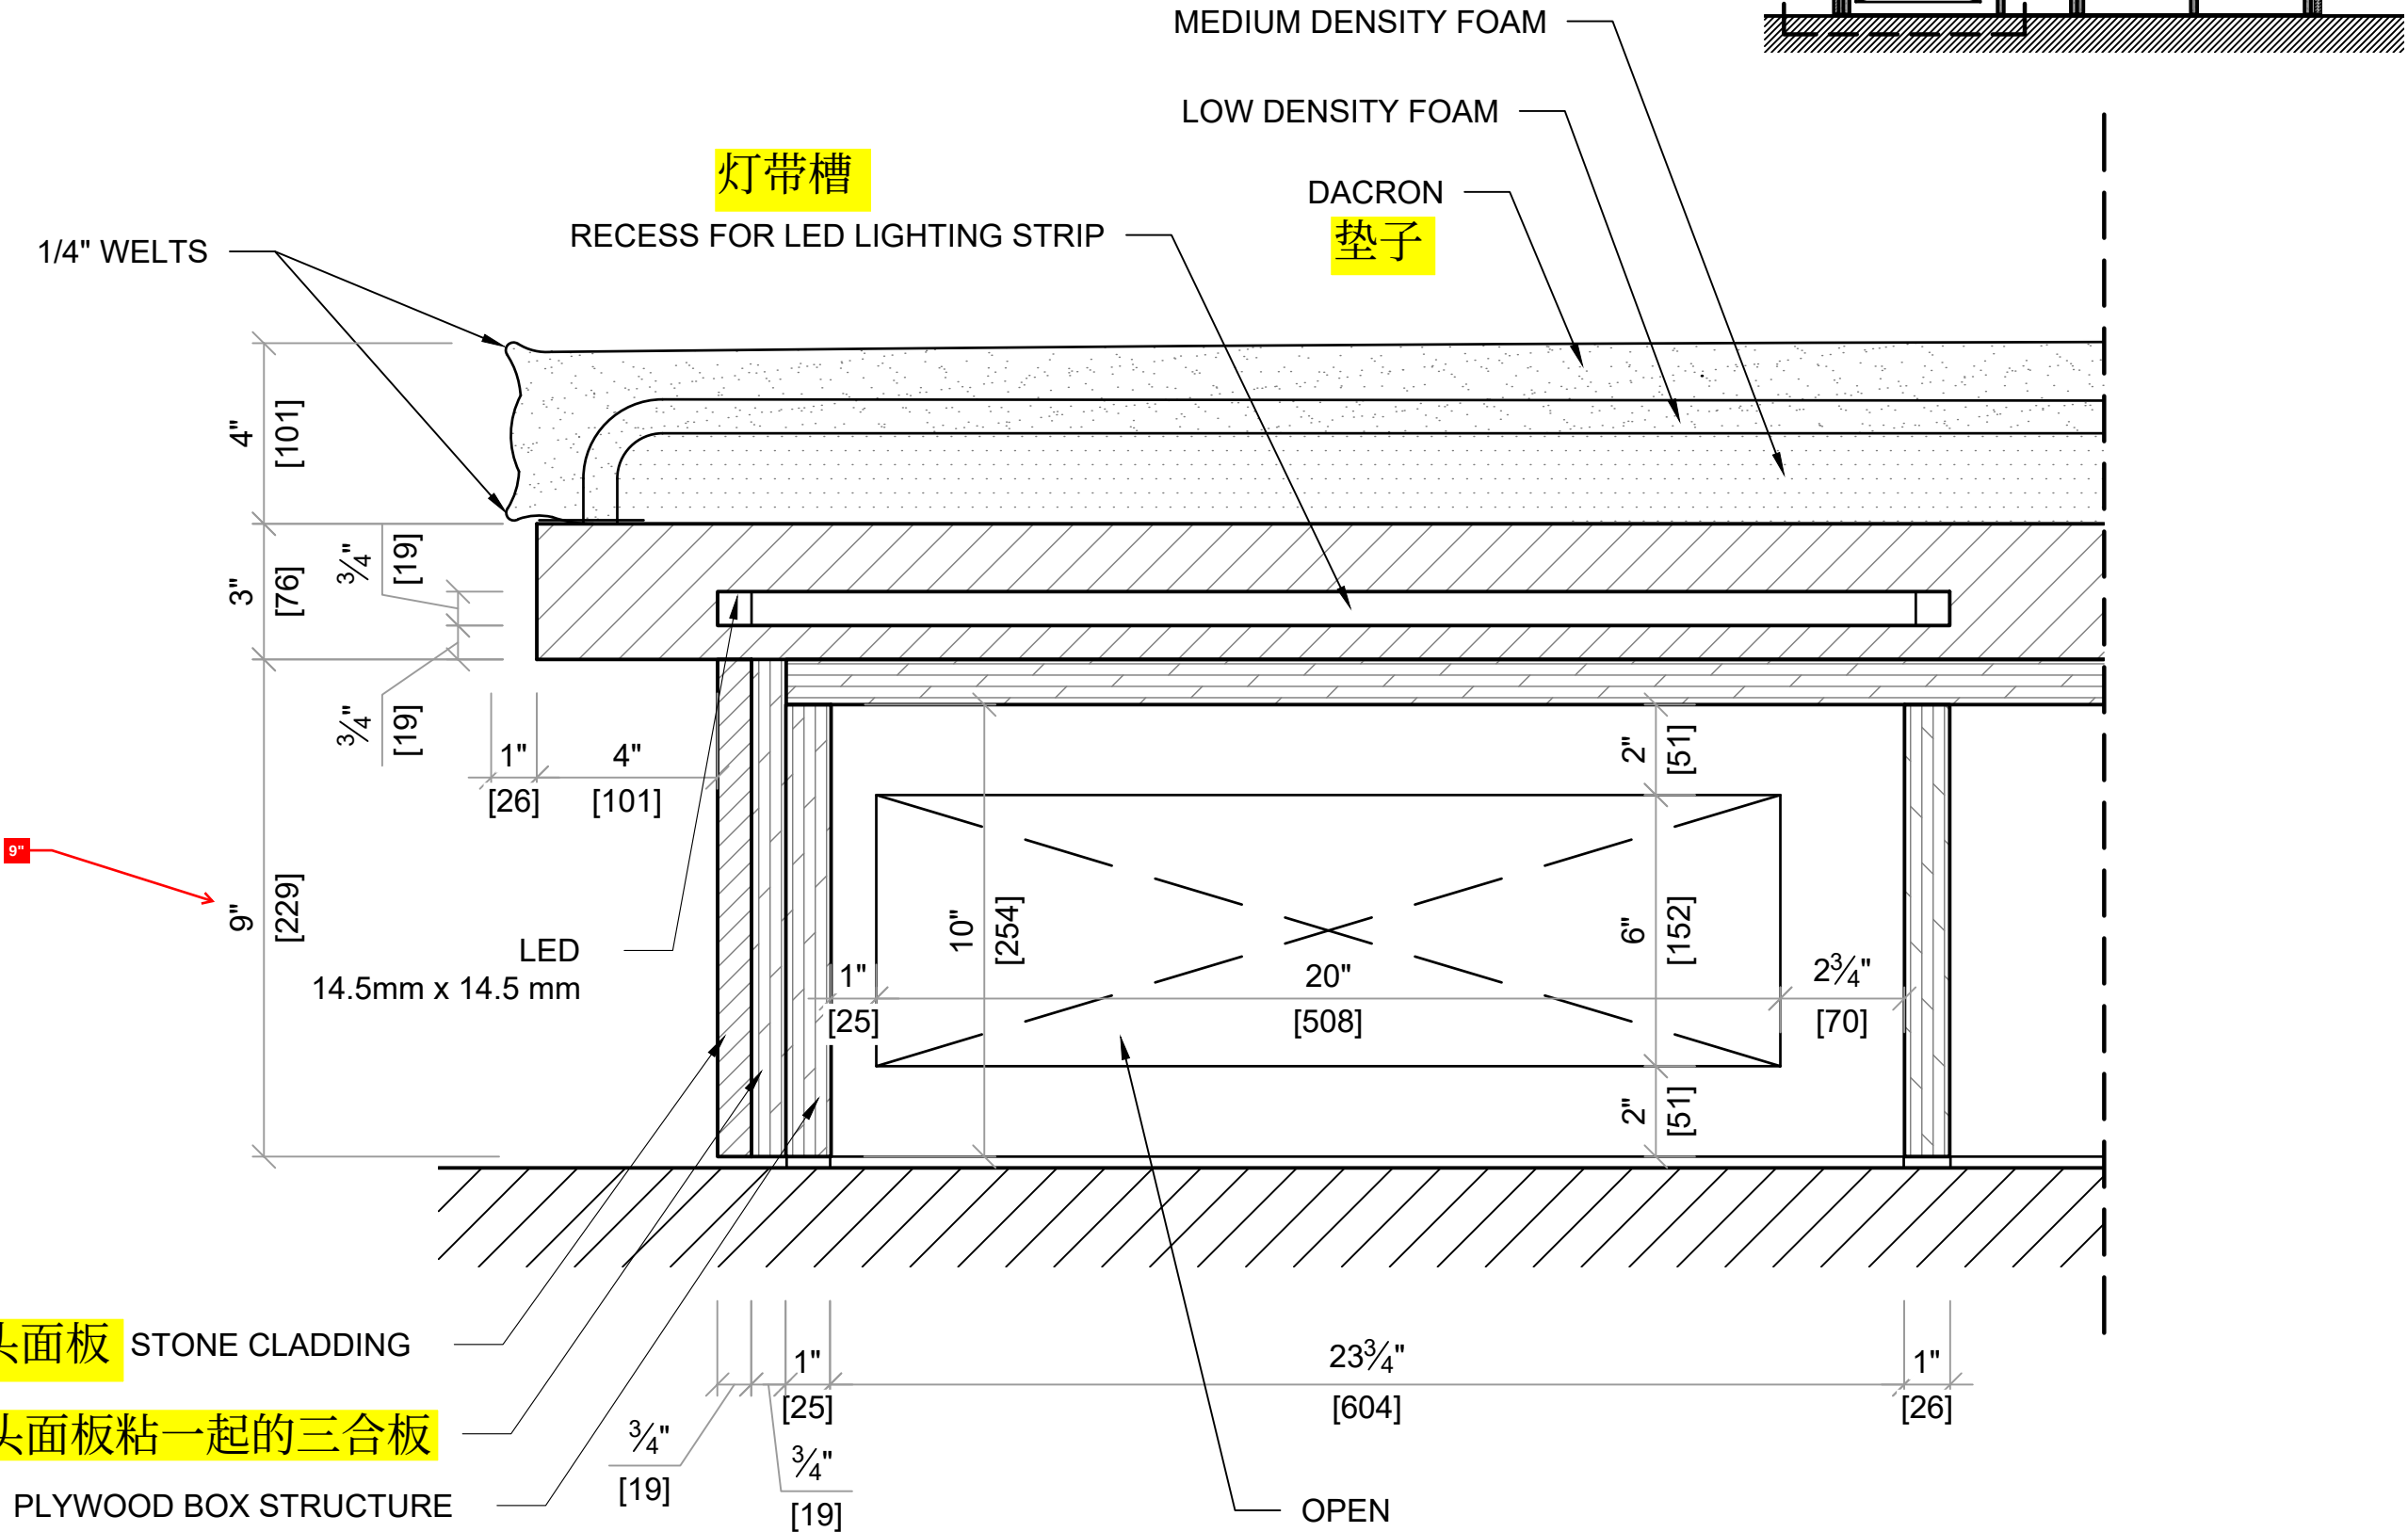

ISSUED FOR:	DATE:	BY:
DATE ISSUED	06/25/2025	MK


PROJECT TITLE:
WALLER CREEK
ITEM NUMBER:
GR-IF-120.4
DESCRIPTION:
BENCH

SPECIFICATIONS:
MATERIAL:
ST-01: PORTUGAL BEIGE LIMESTONE
UP-120.4: UPHOLSTERY
FINISH:
STONE: HONED SURFACE
CHISELLED SURFACE ALL SURFACES:
MATTE PROTECTIVE SEALANT

NOTES:

JOB NO:	320C
DRAWN BY:	MK/YA
DATE DRAWN:	6/26/2025
SCALE:	AS NOTED
SHEET:	

侧面剖面图B

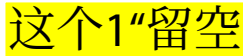

与石头面板粘一起的三合板

PLYWOOD BOX STRUCTURE 1" CONSTRUCTION

1"厚的三合板箱体

半嵌入式滑轨

SEMI RECESSED GLIDES

LEAVE BACK 1" OPEN

OPEN
开孔


SHEET:

05

SCALE 3" = 1' 0"

05

SECTION C

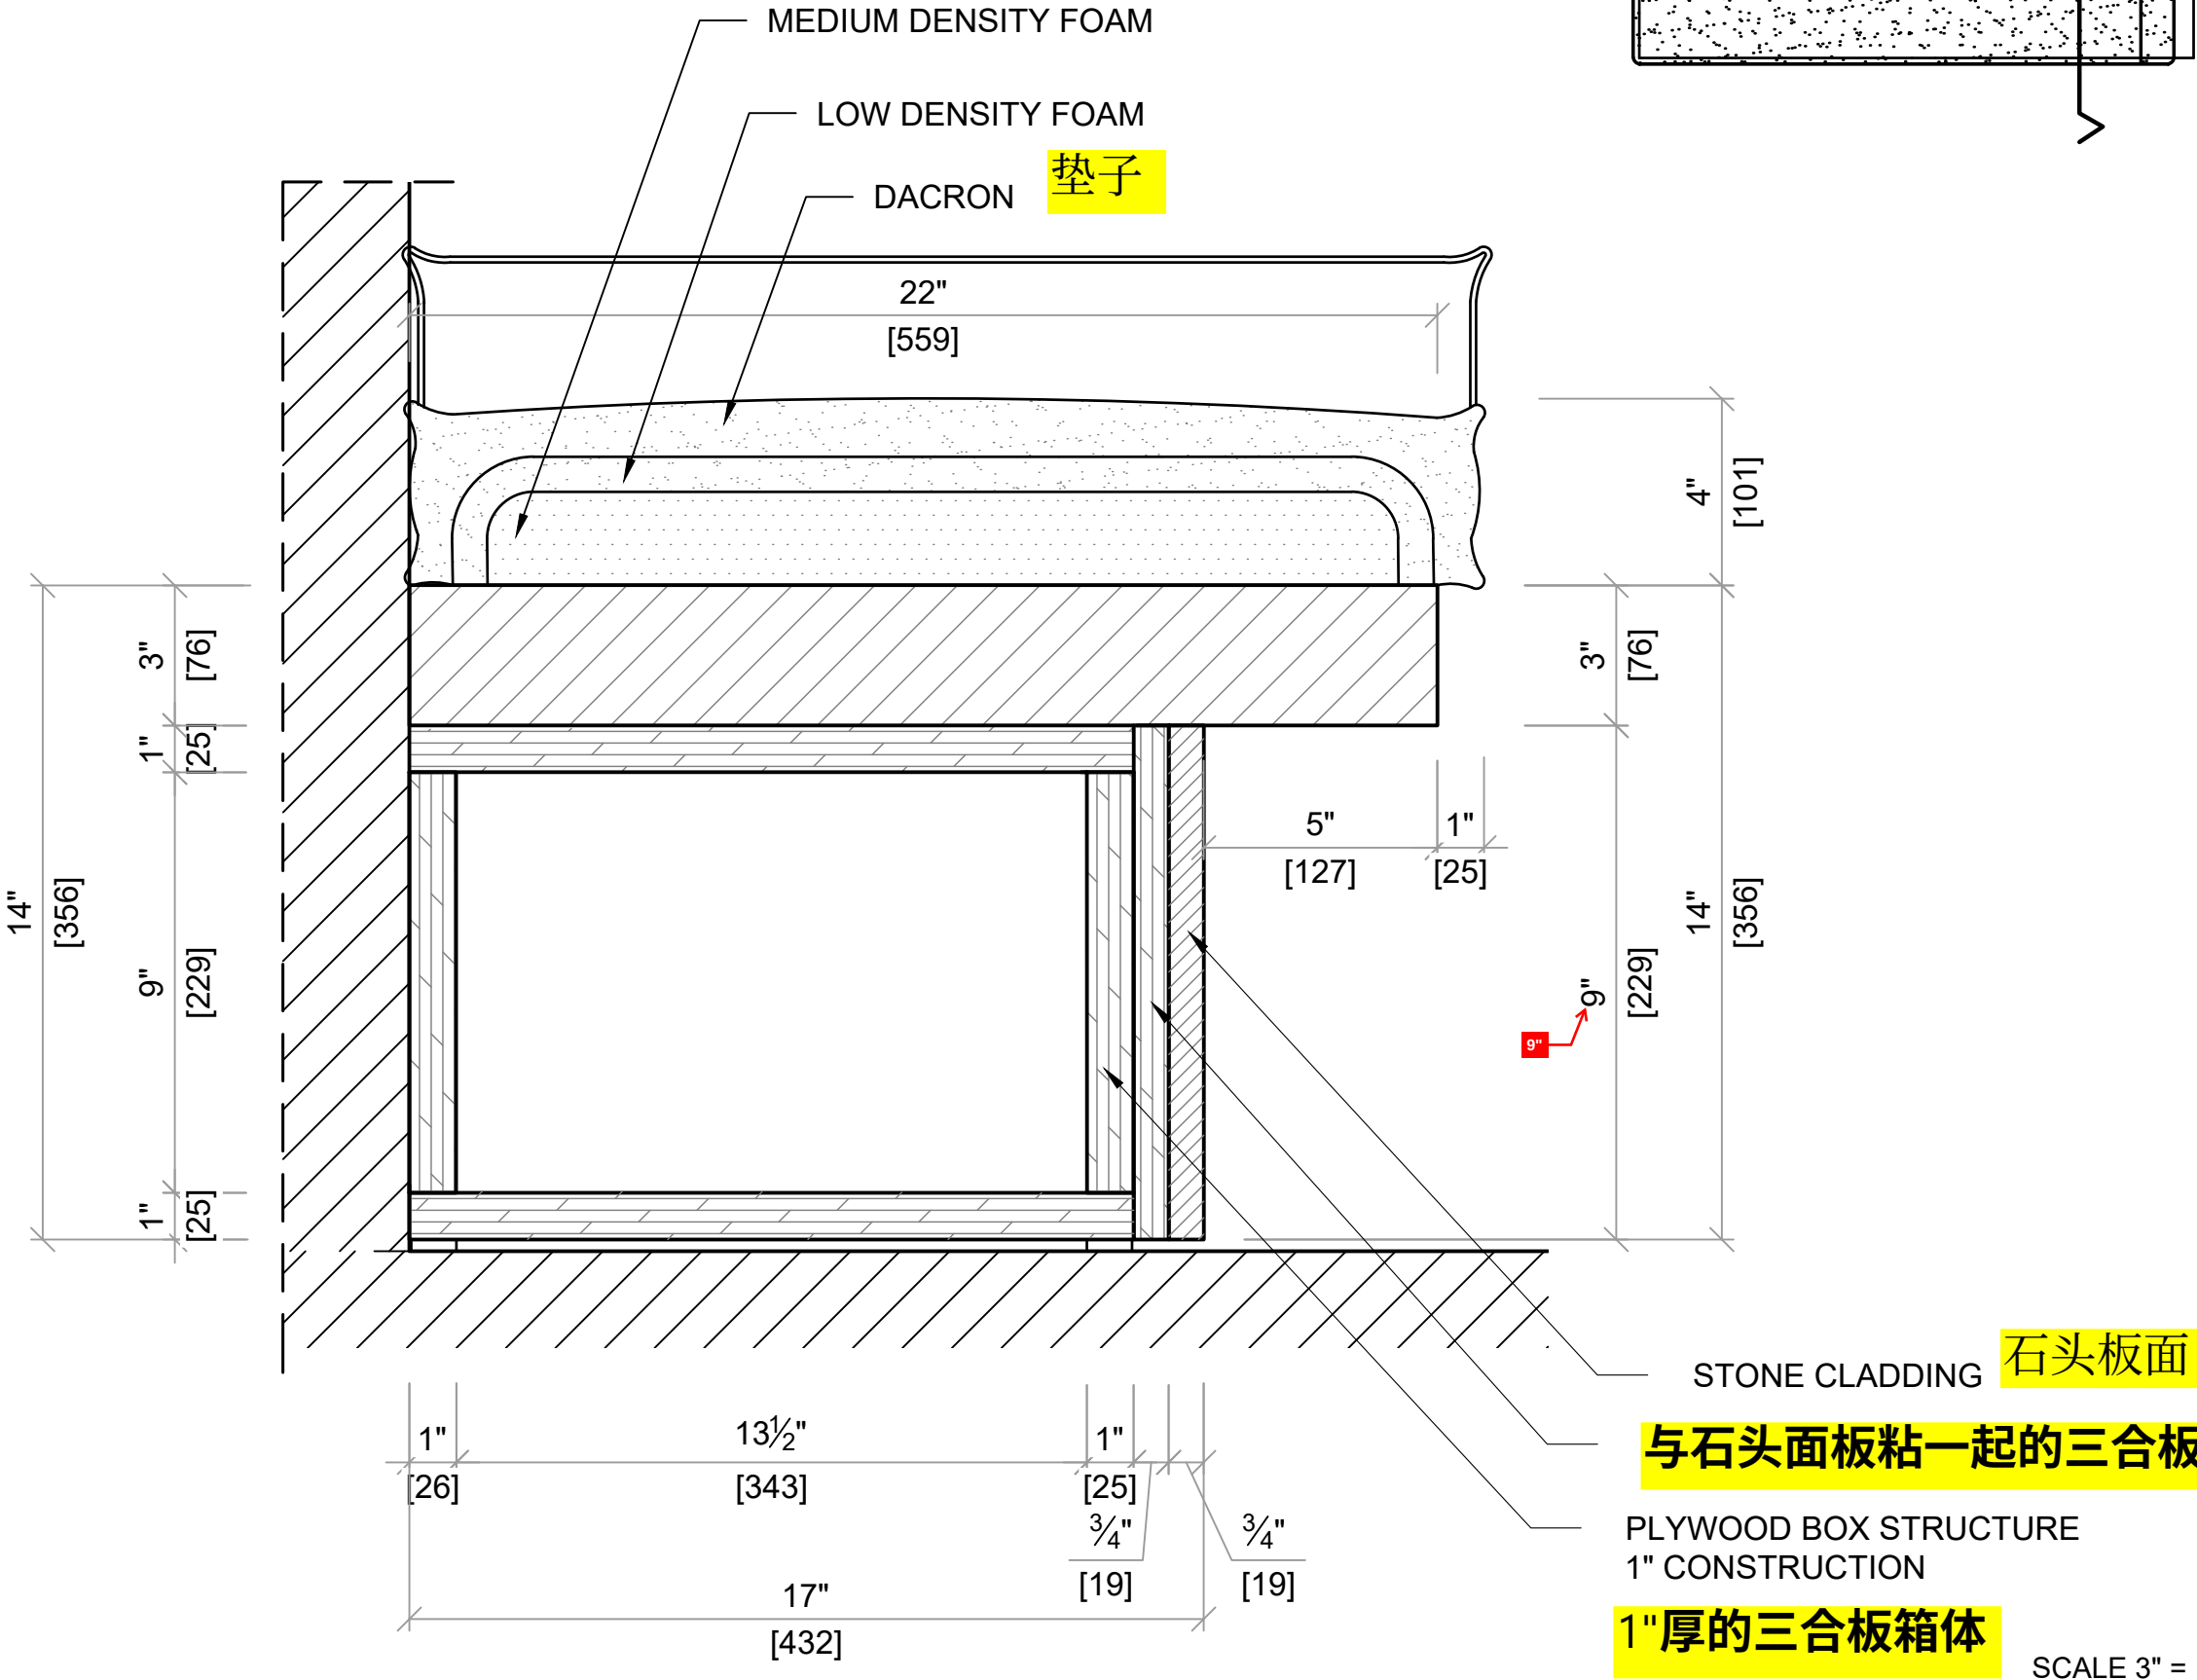

SCALE 3" = 1' 0"

ISSUED FOR:	DATE:	BY:
DATE ISSUED	06/25/2025	MK

PROJECT TITLE:
WALLER CREEK
ITEM NUMBER:
GR-IF-120.4
DESCRIPTION:
BENCH


SPECIFICATIONS:
MATERIAL:
ST-01: PORTUGAL BEIGE LIMESTONE
UP-120.4: UPHOLSTERY
FINISH:
STONE: HONED SURFACE
CHISELLED SURFACE ALL SURFACES:
MATTE PROTECTIVE SEALANT

NOTES:

JOB NO:	320C
DRAWN BY:	MK/YA
DATE DRAWN:	6/26/2025
SCALE:	AS NOTED
SHEET:	

GENERAL NOTE
STUDY HEIGHT OF BENCH WITH TABLE AND CHAIR

GR - IF - 120.5
石头：葡萄牙米黄
加工：哑光面+自然边+防水
数量：1套

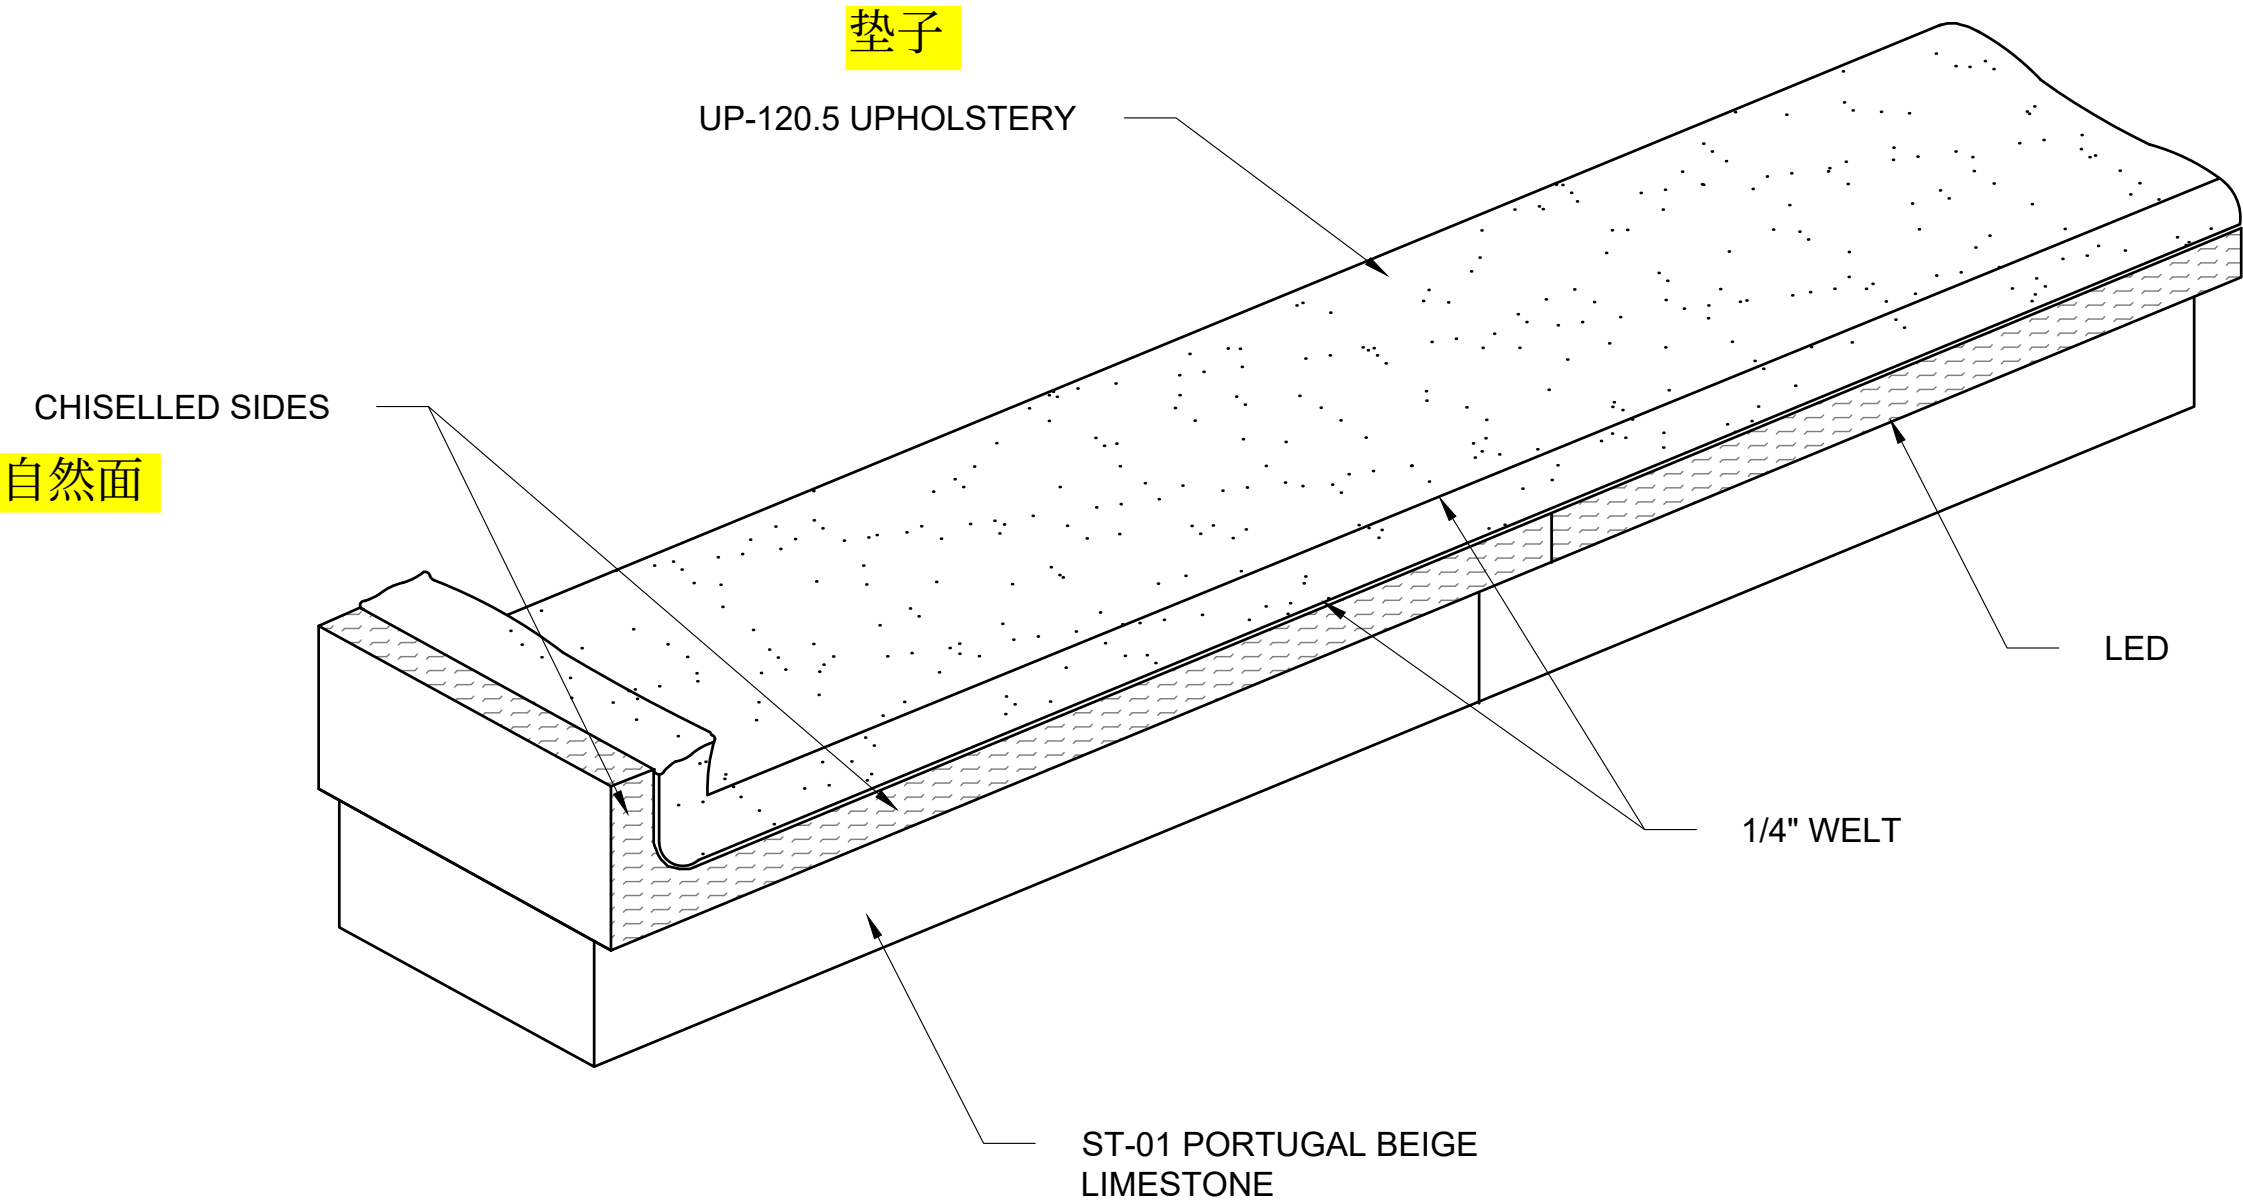

ST-01 PORTUGAL BEIGE
LIMESTONE
葡萄牙米黄-哑光面


Reviewed No Exceptions Noted ()
Reviewed Exceptions Noted (X)
Revise and Resubmit ()
Rejected ()

By XAVIER ESCRIBU Date 6/30/2025

ISSUED FOR:	DATE:	BY:
DATE ISSUED	06/26/2025	MK

PROJECT TITLE:
WALLER CREEK
ITEM NUMBER:
GR-IF-120.5
DESCRIPTION:
BENCH
SPECIFICATIONS:
MATERIAL: ST-01: PORTUGAL BEIGE LIMESTONE UP-120.5: UPHOLSTERY
FINISH: STONE: HONED SURFACE CHISELLED SURFACE ALL SURFACES: MATTE PROTECTIVE SEALANT
NOTES:
JOB NO: 320C
DRAWN BY: MK/YA
DATE DRAWN: 6/26/2025
SCALE: AS NOTED
SHEET:


俯视图

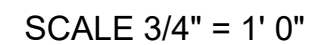


SHEET:

02

PLAN VIEW
平面剖面图

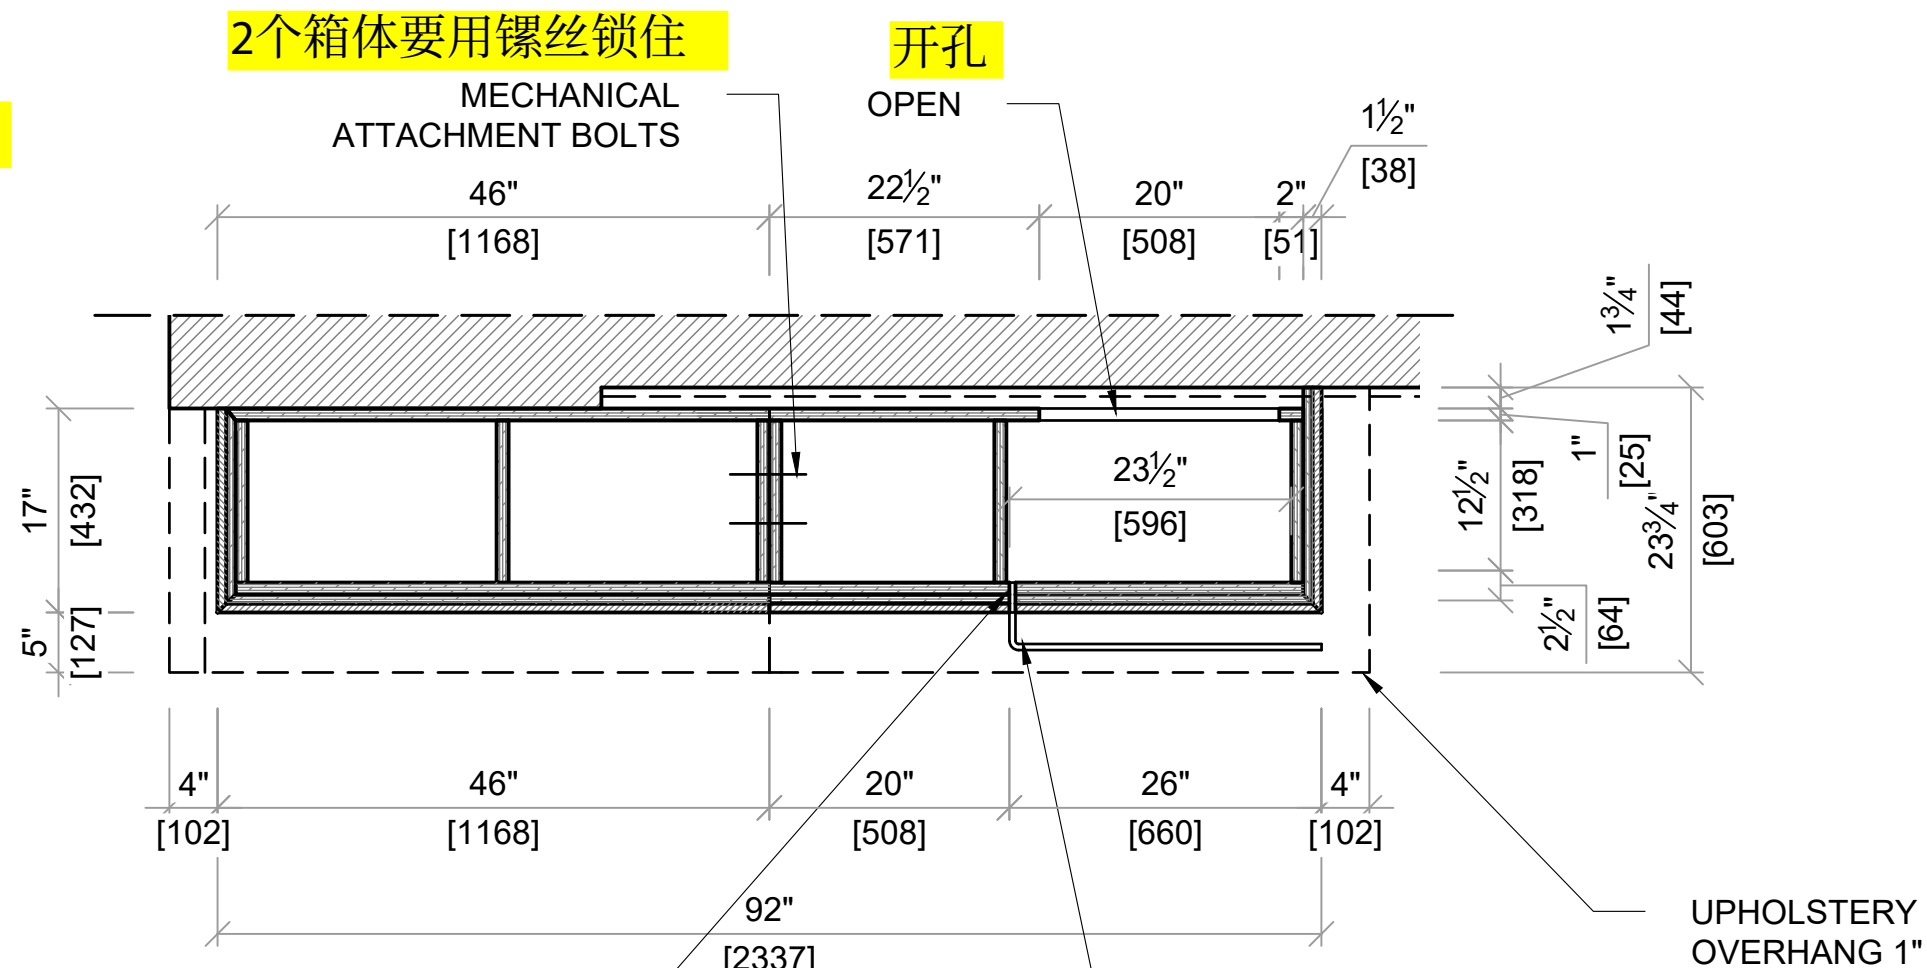

SECTION A
立面剖面图

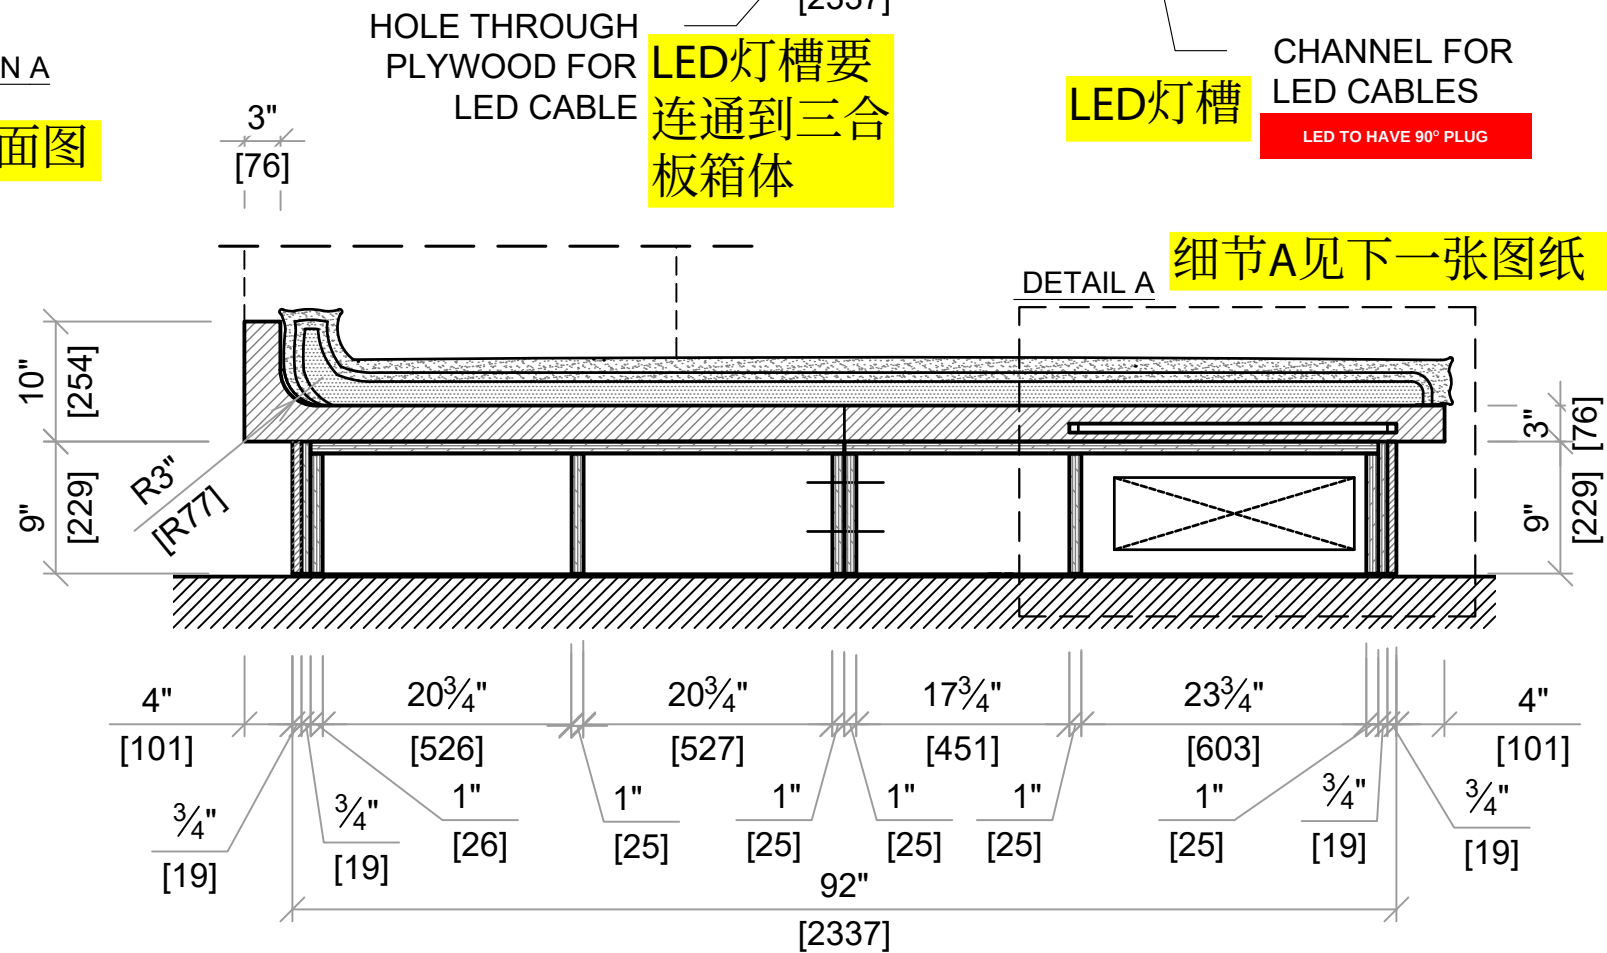

SCALE 3/4" = 1' 0"

ISSUED FOR:	DATE:	BY:
DATE ISSUED	06/26/2025	MK

PROJECT TITLE:

WALLER CREEK

ITEM NUMBER:

GR-IF-120.5

DESCRIPTION:

BENCH

SPECIFICATIONS:

MATERIAL:
ST-01: PORTUGAL BEIGE LIMESTONE
UP-120.5: UPHOLSTERY

FINISH:
STONE: HONED SURFACE
CHISELLED SURFACE ALL SURFACES:
MATTE PROTECTIVE SEALANT

NOTES:

JOB NO: 320C


DRAWN BY: MK/YA

DATE DRAWN: 6/26/2025

SCALE: AS NOTED

SHEET:

03

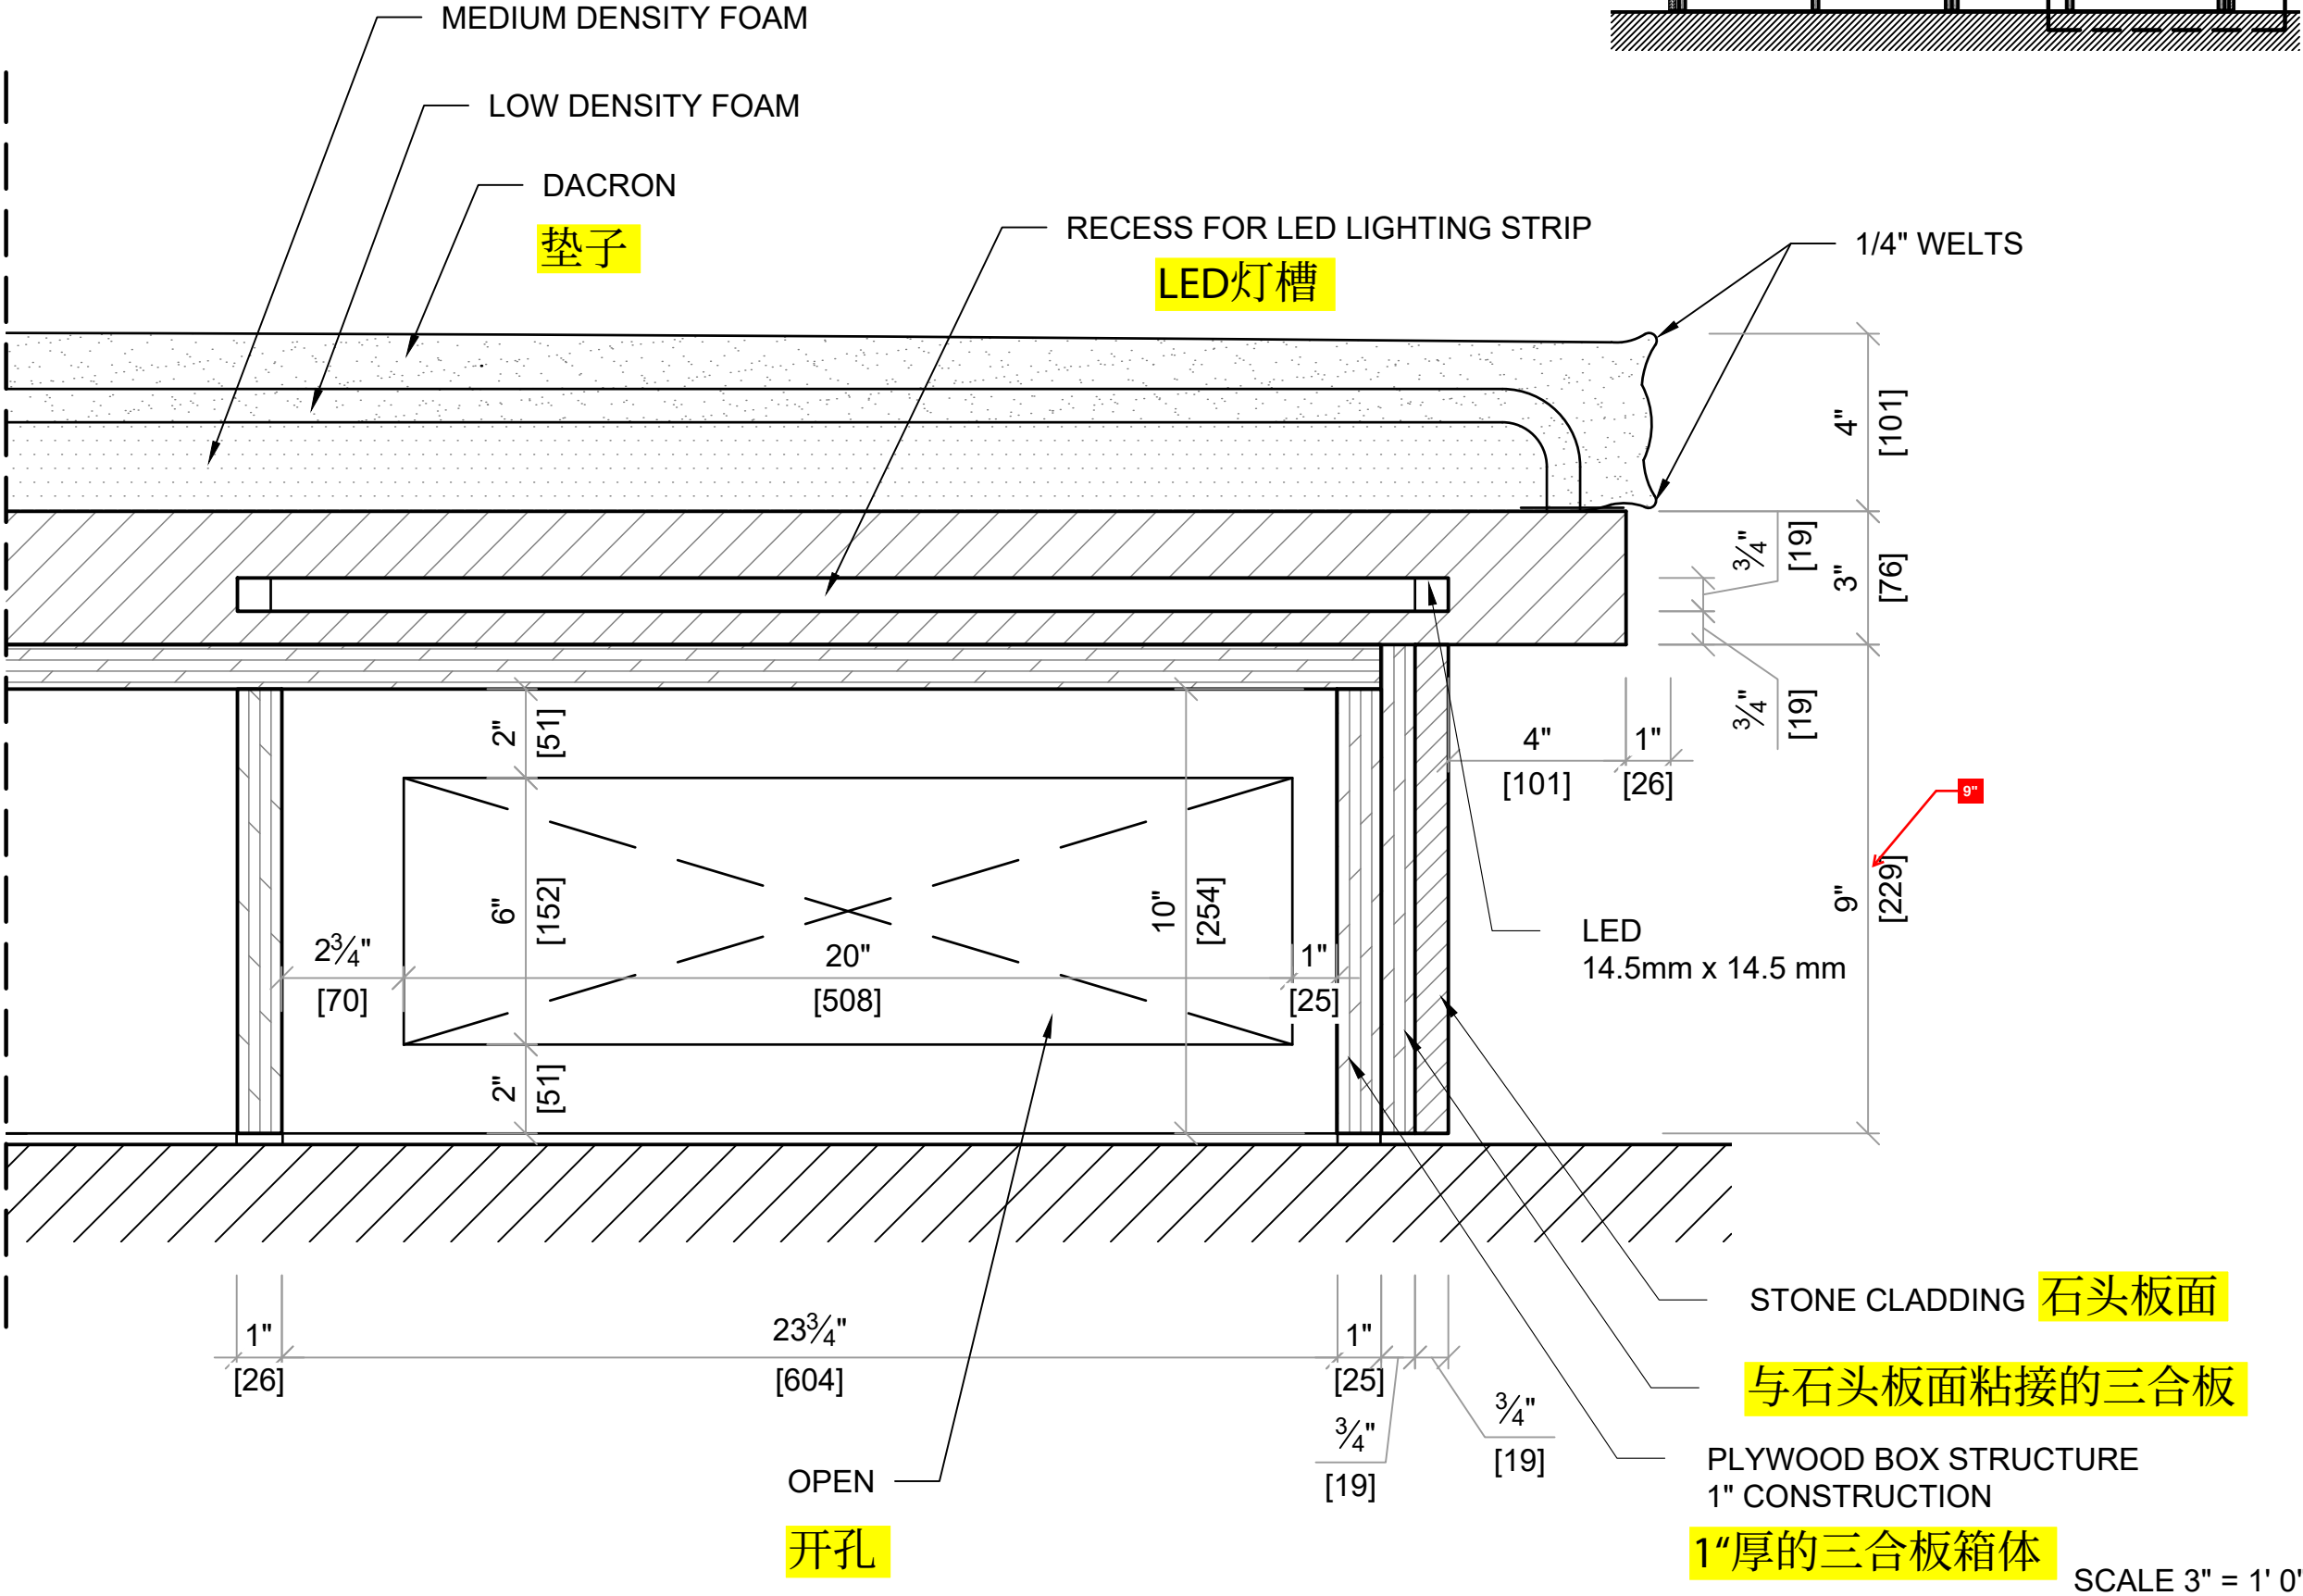

ISSUED FOR:	DATE:	BY:
DATE ISSUED	06/26/2025	MK

PROJECT TITLE:
WALLER CREEK

ITEM NUMBER:
GR-IF-120.5

DESCRIPTION:
BENCH

SPECIFICATIONS:
MATERIAL:
ST-01: PORTUGAL BEIGE LIMESTONE
UP-120.5: UPHOLSTERY

FINISH:
STONE: HONED SURFACE
CHISELLED SURFACE ALL SURFACES:
MATTE PROTECTIVE SEALANT


NOTES:

JOB NO:	320C
DRAWN BY:	MK/YA
DATE DRAWN:	6/26/2025
SCALE:	AS NOTED
SHEET:	

SECTION B

侧面剖面图B

OPEN
开孔

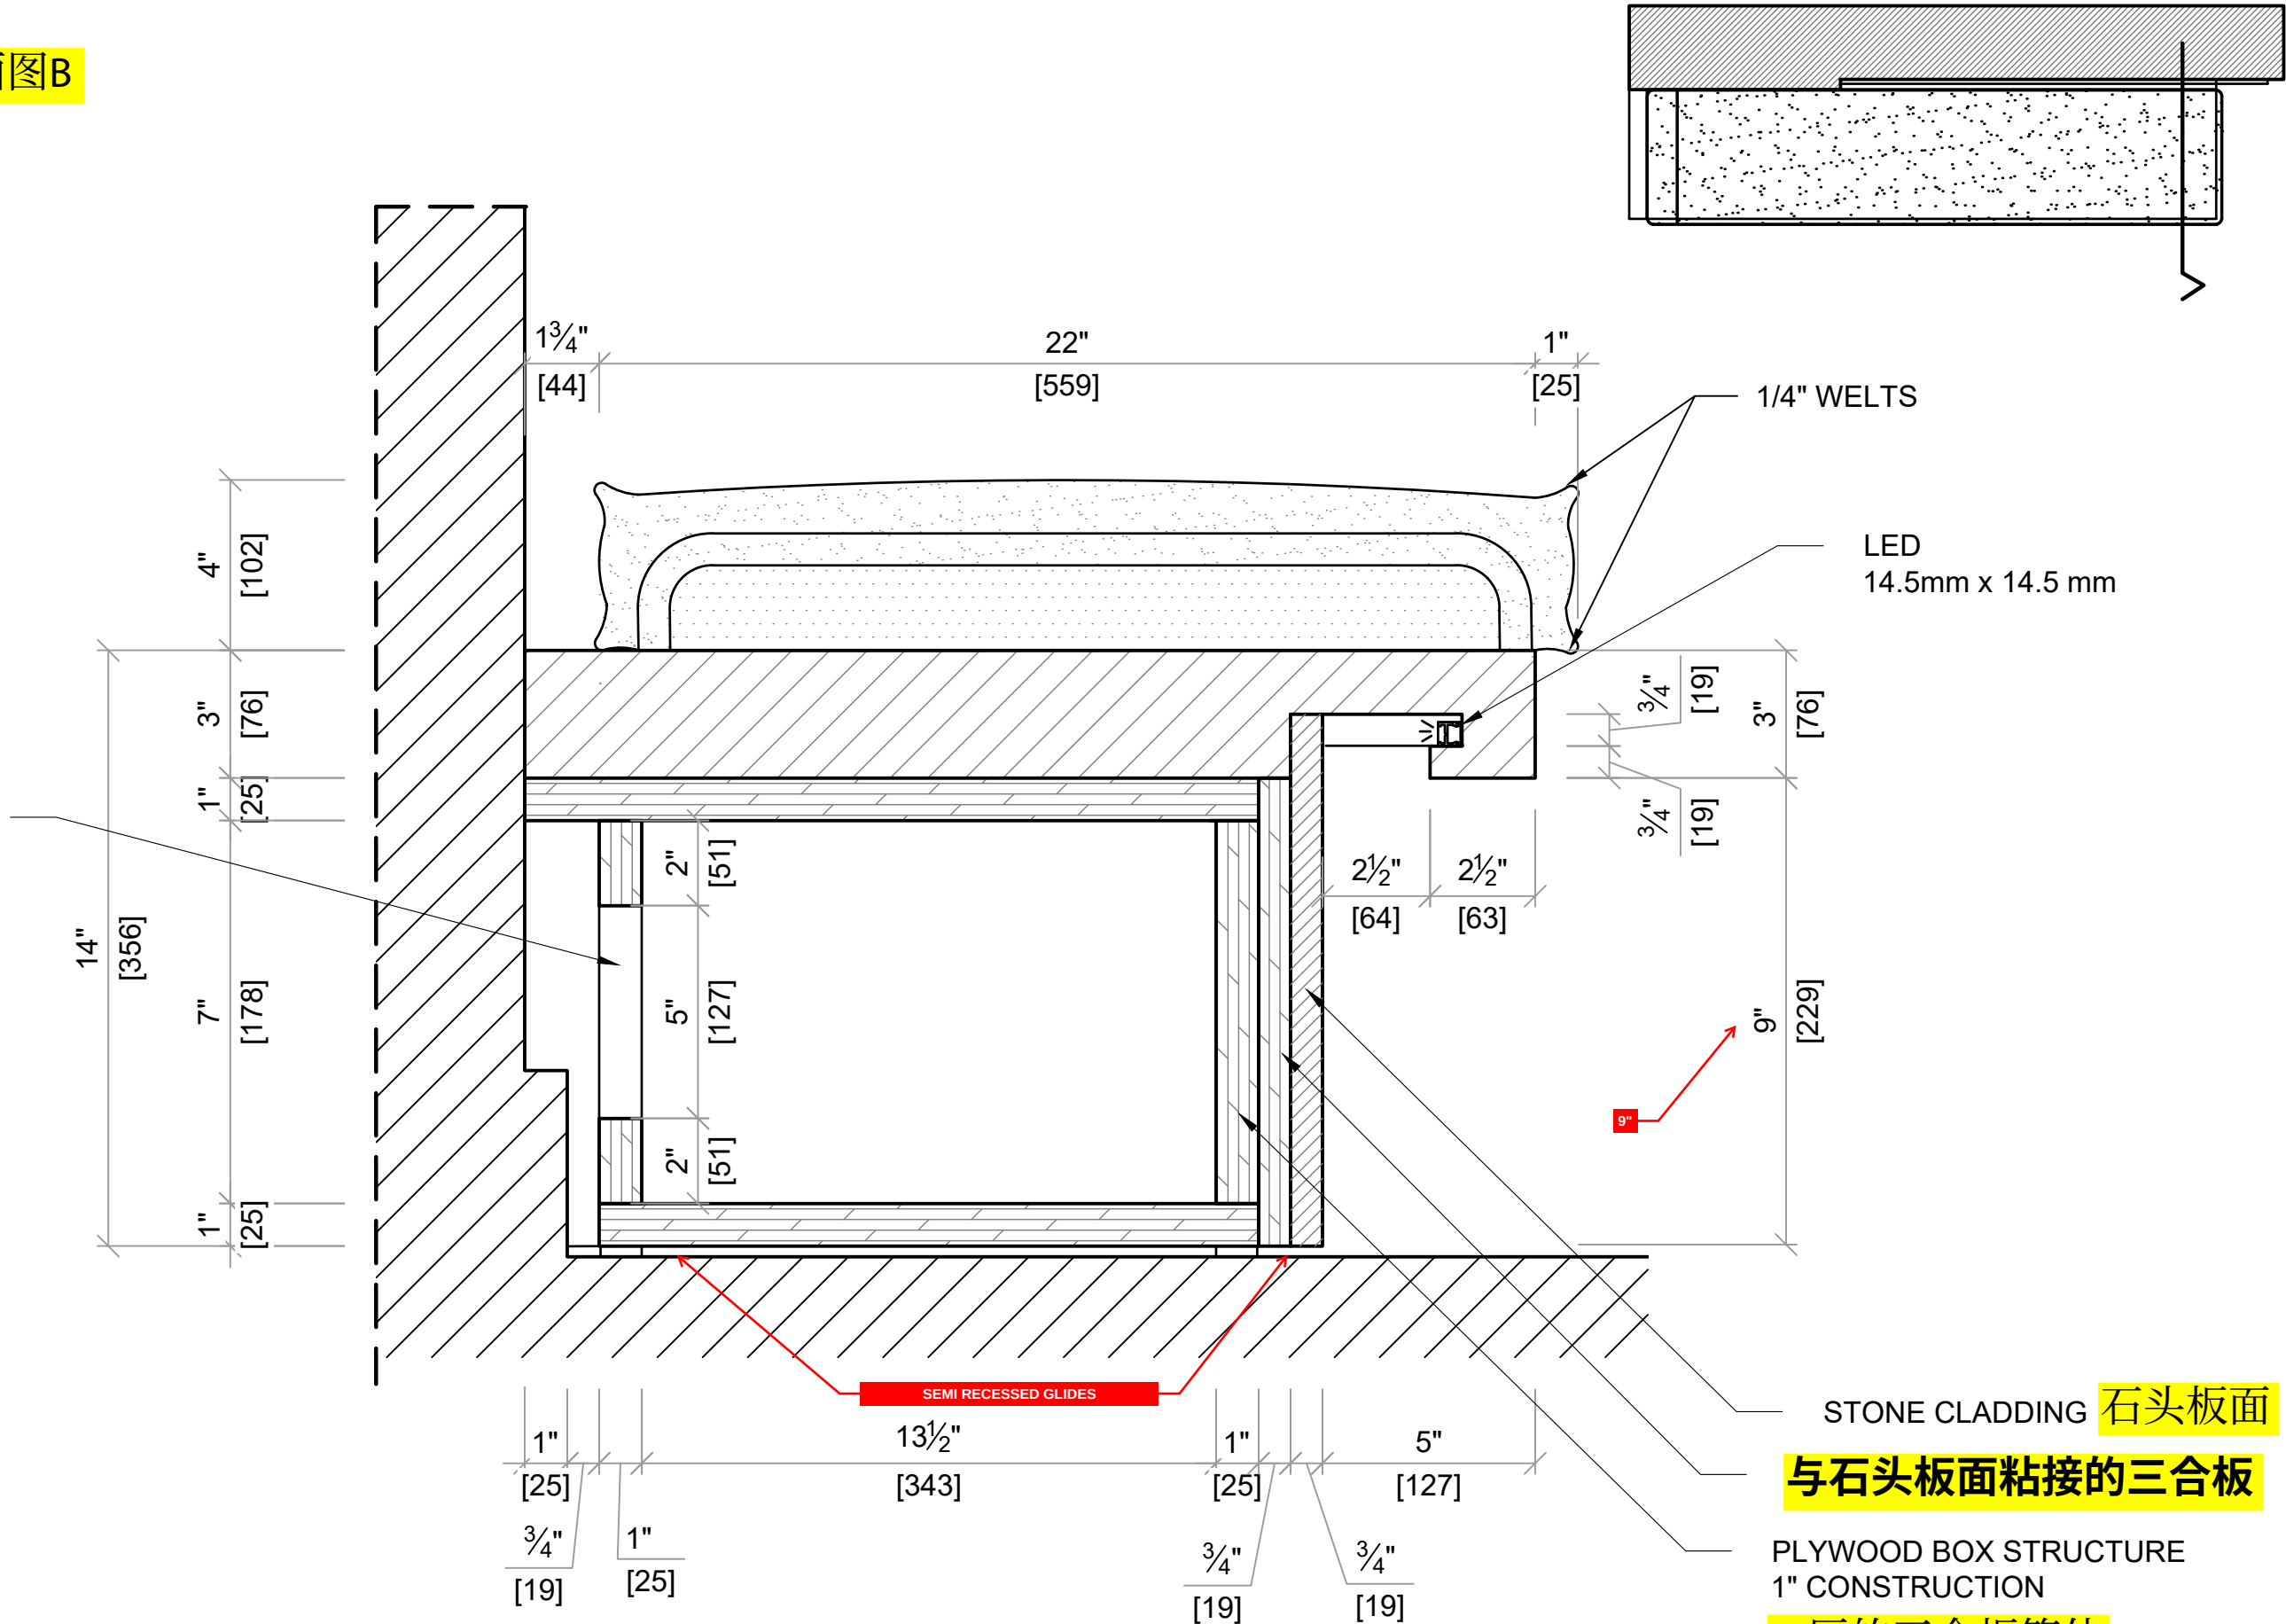

SCALE 3" = 1' 0"


ISSUED FOR:	DATE:	BY:
DATE ISSUED	06/26/2025	MK

PROJECT TITLE:
WALLER CREEK
ITEM NUMBER:
GR-IF-120.5
DESCRIPTION:
BENCH

SPECIFICATIONS:
MATERIAL:
ST-01: PORTUGAL BEIGE LIMESTONE UP-120.5: UPHOLSTERY
FINISH:
STONE: HONED SURFACE CHISELLED SURFACE ALL SURFACES: MATTE PROTECTIVE SEALANT
NOTES:

JOB NO:	320C
DRAWN BY:	MK/YA
DATE DRAWN:	6/26/2025
SCALE:	AS NOTED
SHEET:	

SECTION C

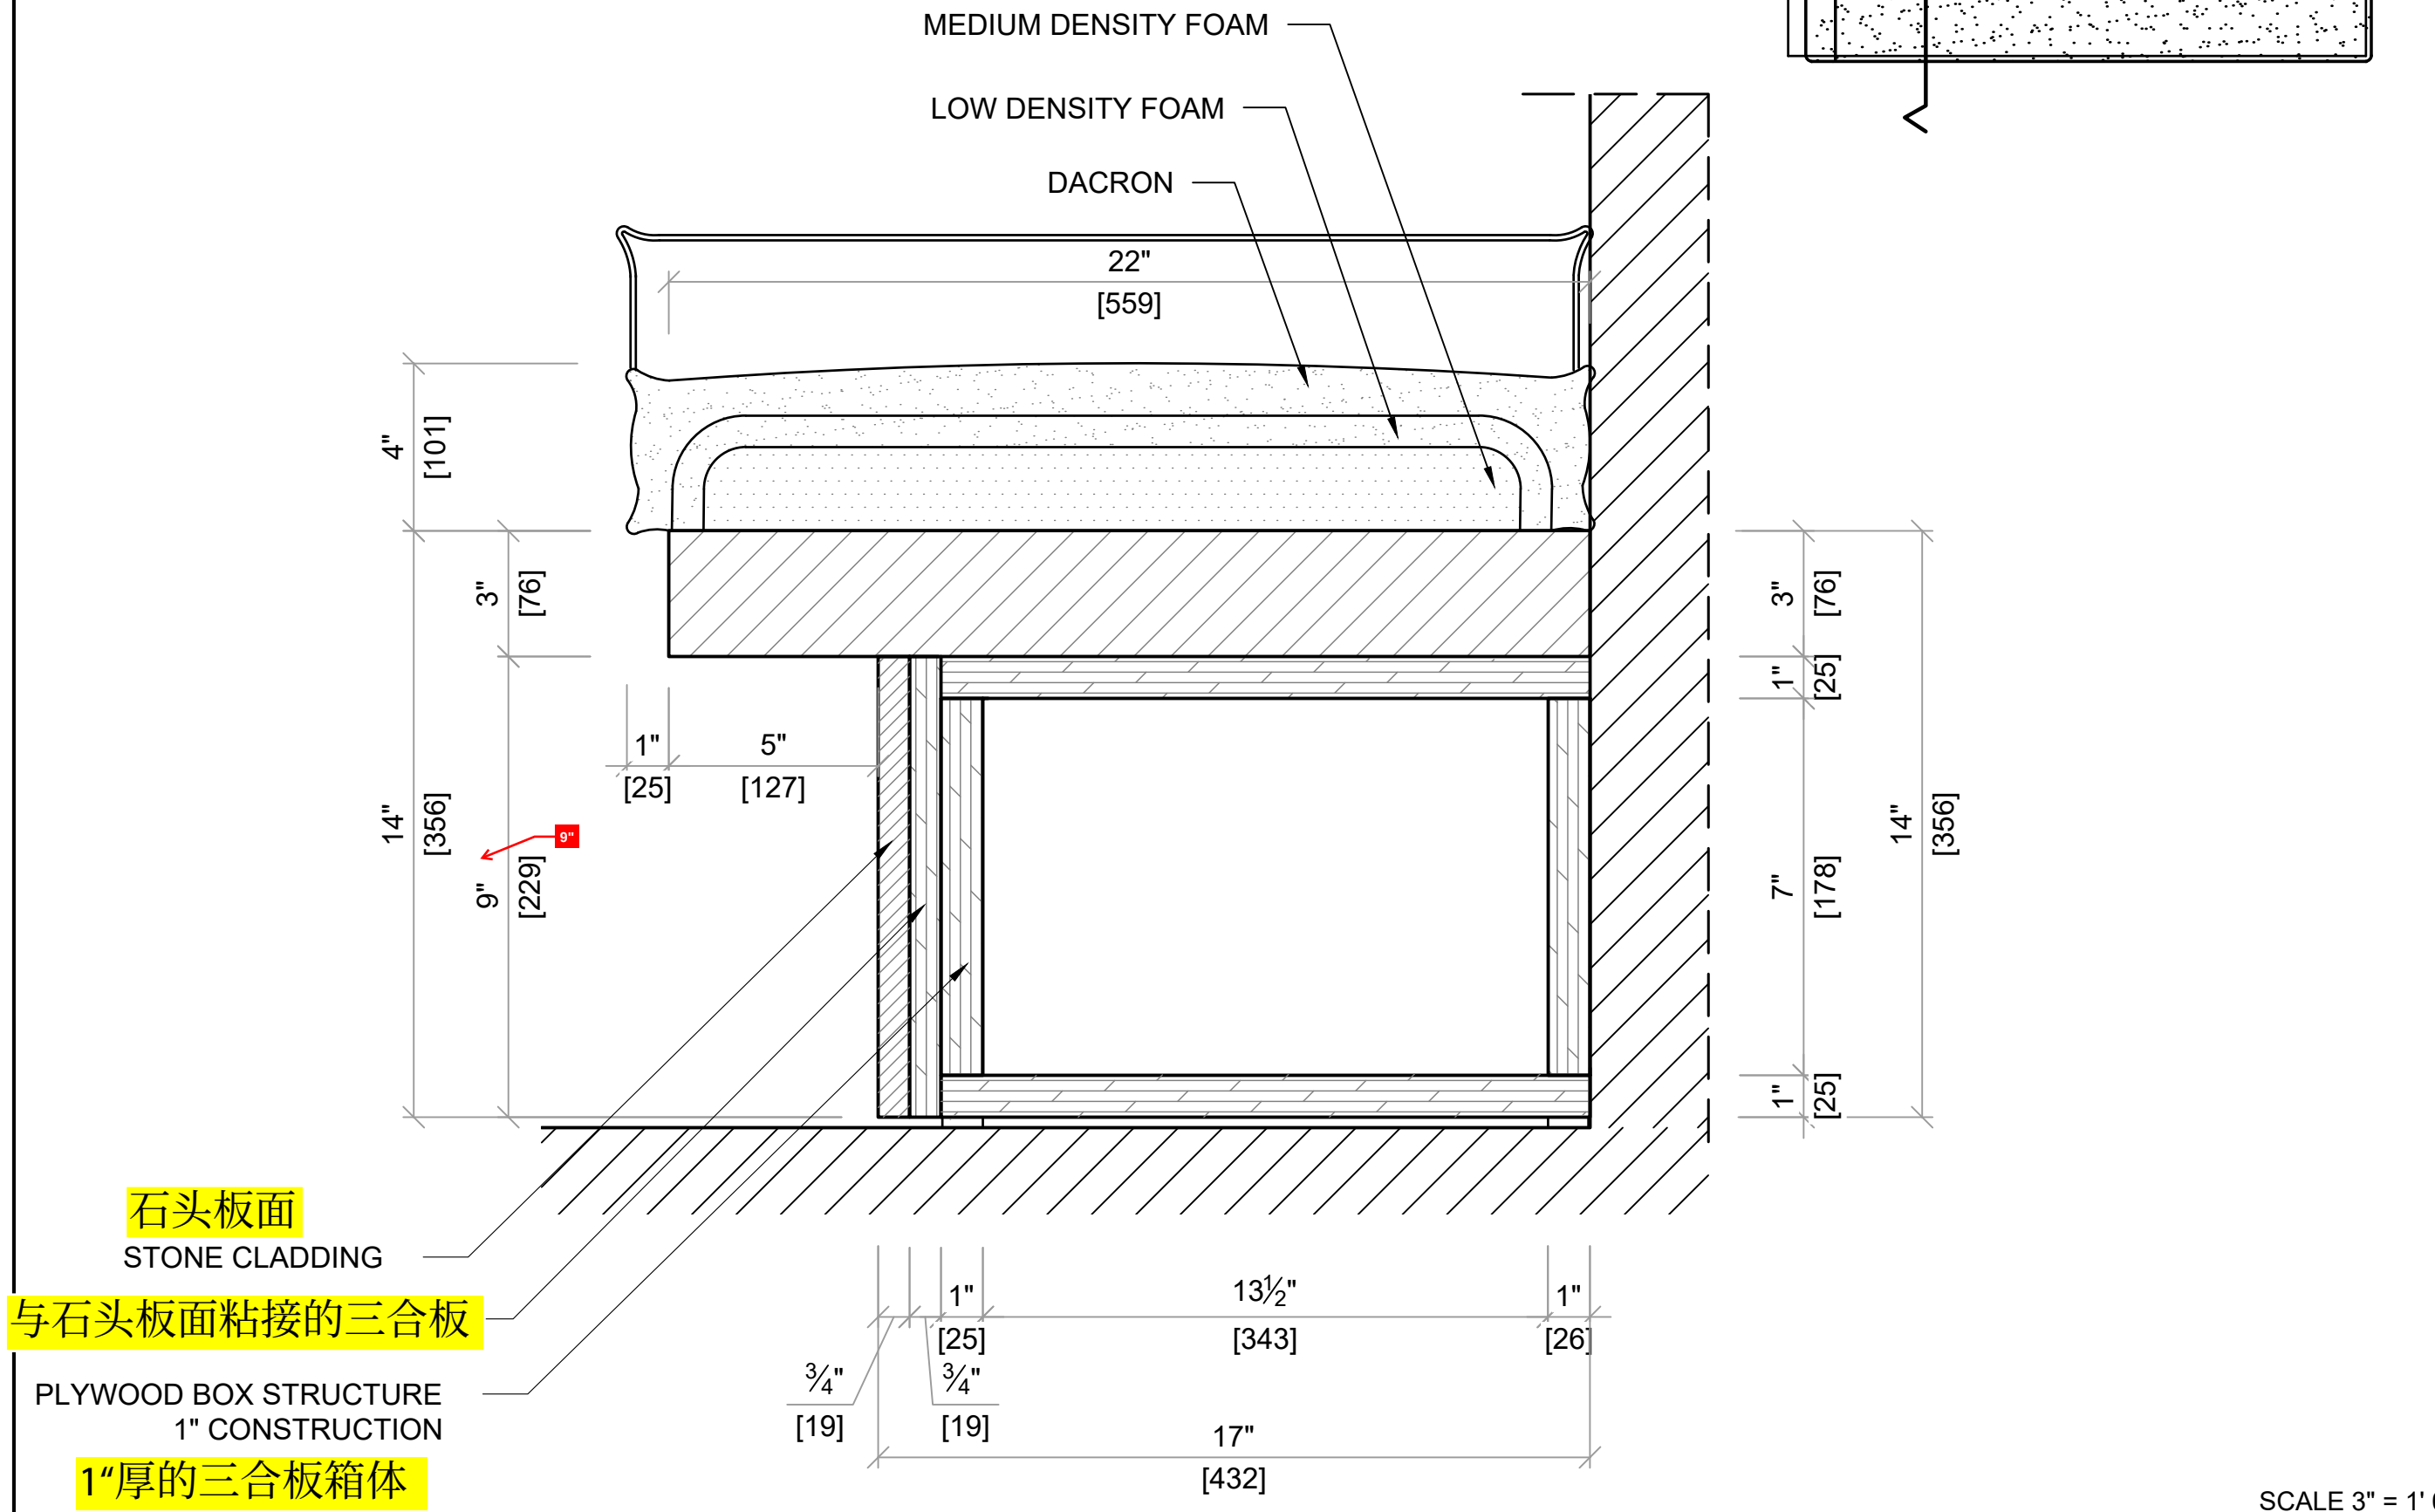

SCALE 3" = 1' 0"

ISSUED FOR:	DATE:	BY:
DATE ISSUED	06/26/2025	MK


PROJECT TITLE:
WALLER CREEK
ITEM NUMBER:
GR-IF-120.5
DESCRIPTION:
BENCH

SPECIFICATIONS:
MATERIAL:
ST-01: PORTUGAL BEIGE LIMESTONE
UP-120.5: UPHOLSTERY
FINISH:
STONE: HONED SURFACE
CHISELLED SURFACE ALL SURFACES:
MATTE PROTECTIVE SEALANT

NOTES:
JOB NO:
320C
DRAWN BY:
MK/YA
DATE DRAWN:
6/26/2025
SCALE:
AS NOTED
SHEET:

GENERAL NOTE
STUDY HEIGHT OF BENCH WITH TABLE AND CHAIR

GR - IF - 120.6
石头：葡萄牙米黄
加工：表面哑光+自然这+防水
数量：2套

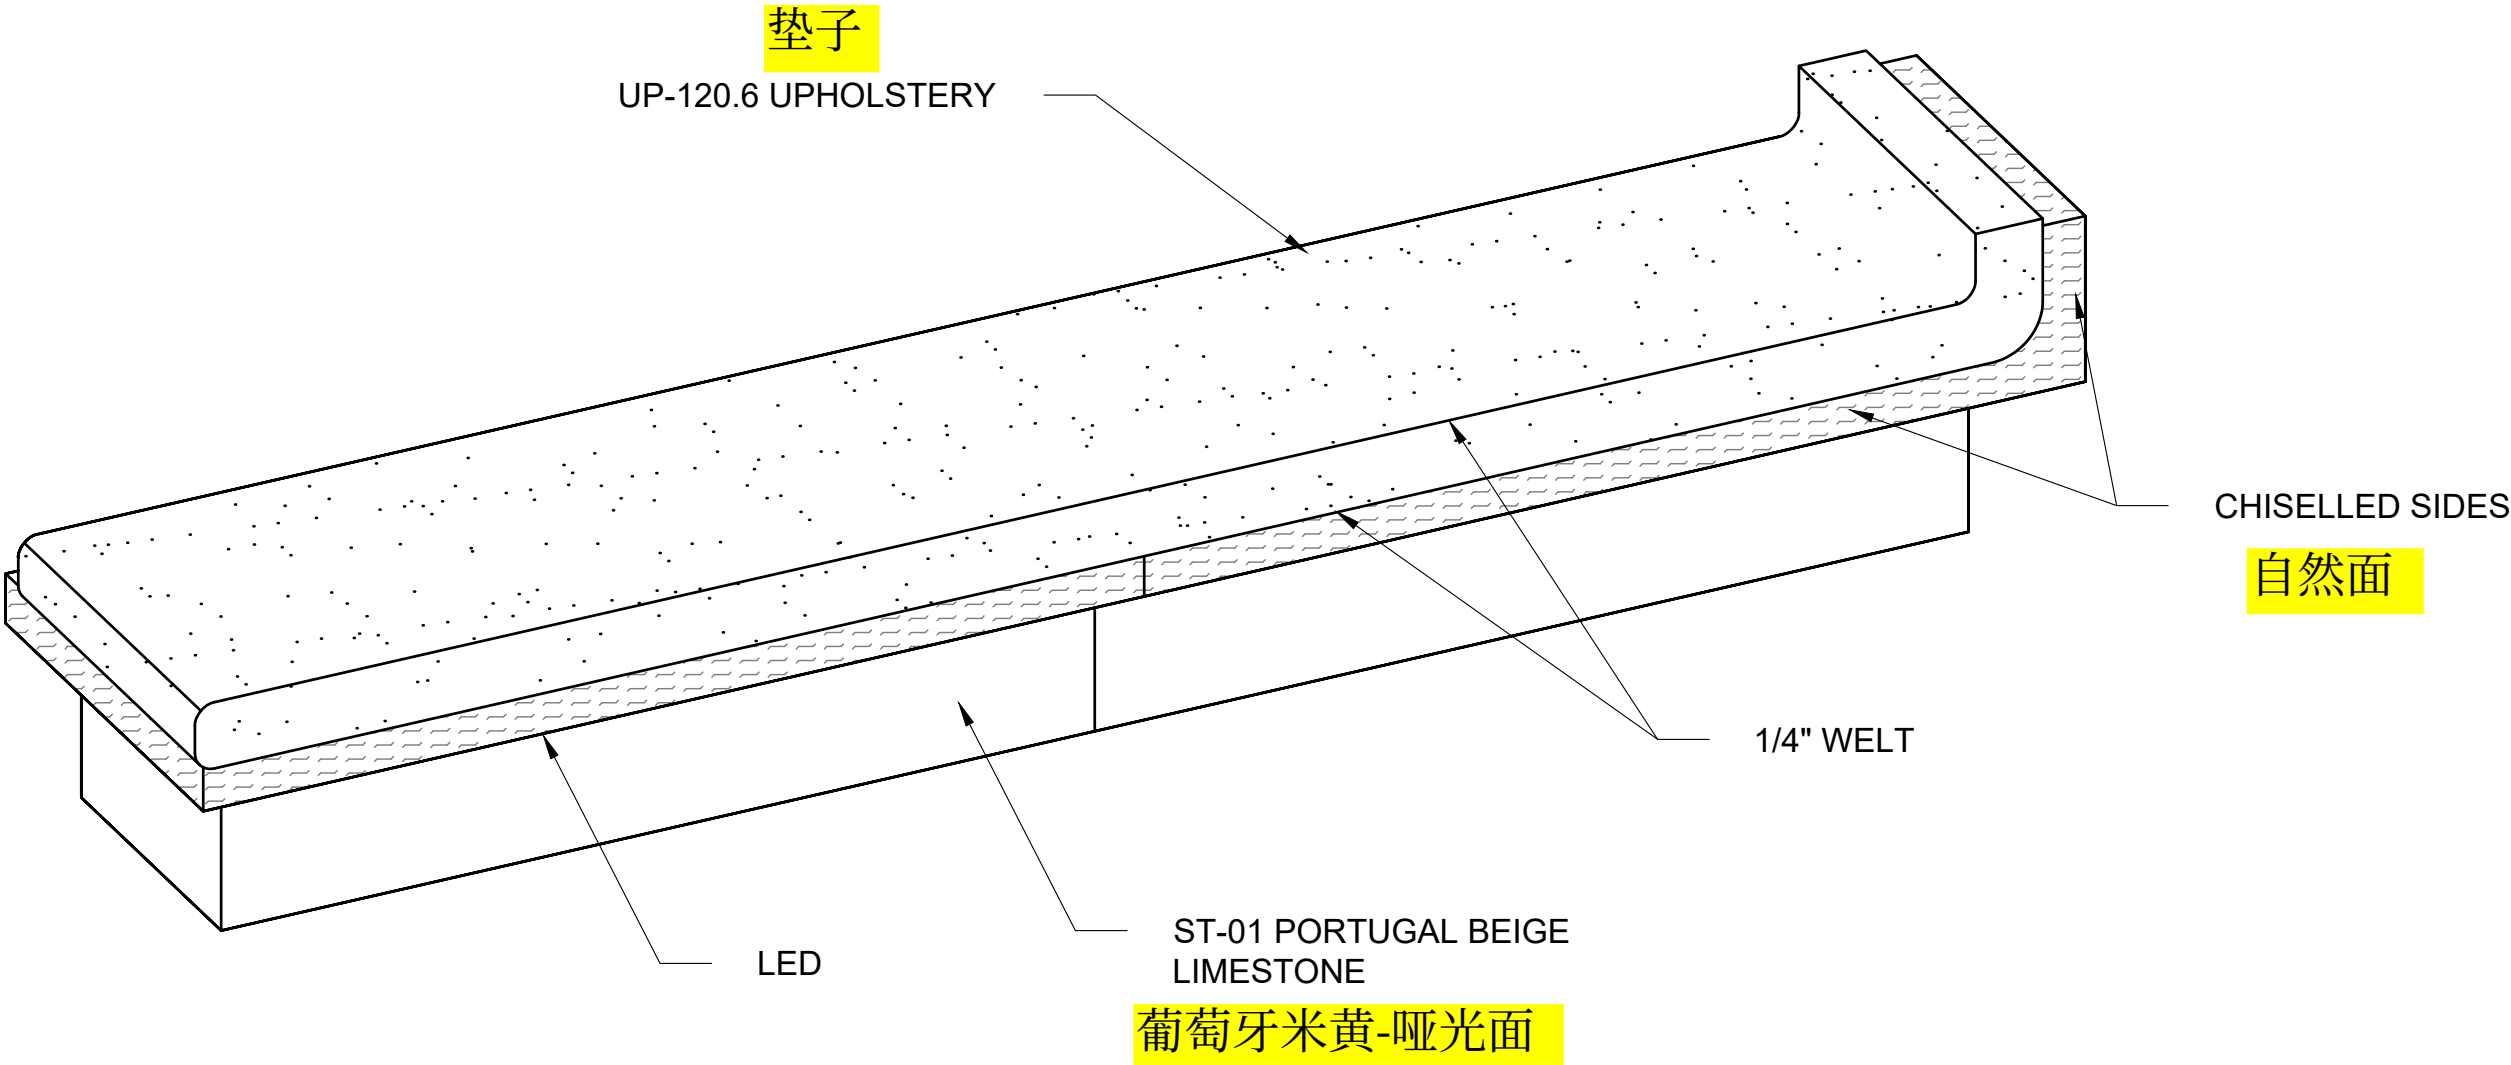

Reviewed No Exceptions Noted ()
Reviewed Exceptions Noted (X)
Revise and Resubmit ()
Rejected ()


By **XAVIER ESCRIBU** Date **6/30/2025**

ISSUED FOR:	DATE:	BY:
DATE ISSUED	06/26/2025	MK

PROJECT TITLE:
WALLER CREEK
ITEM NUMBER:
GR-IF-120.6
DESCRIPTION:
BENCH
SPECIFICATIONS:
MATERIAL: ST-01: PORTUGAL BEIGE LIMESTONE UP-120.6: UPHOLSTERY
FINISH: STONE: HONED SURFACE CHISELLED SURFACE ALL SURFACES: MATTE PROTECTIVE SEALANT
NOTES:
JOB NO: 320C
DRAWN BY: MK/YA
DATE DRAWN: 6/26/2025
SCALE: AS NOTED
SHEET:


TOP VIEW

俯视图

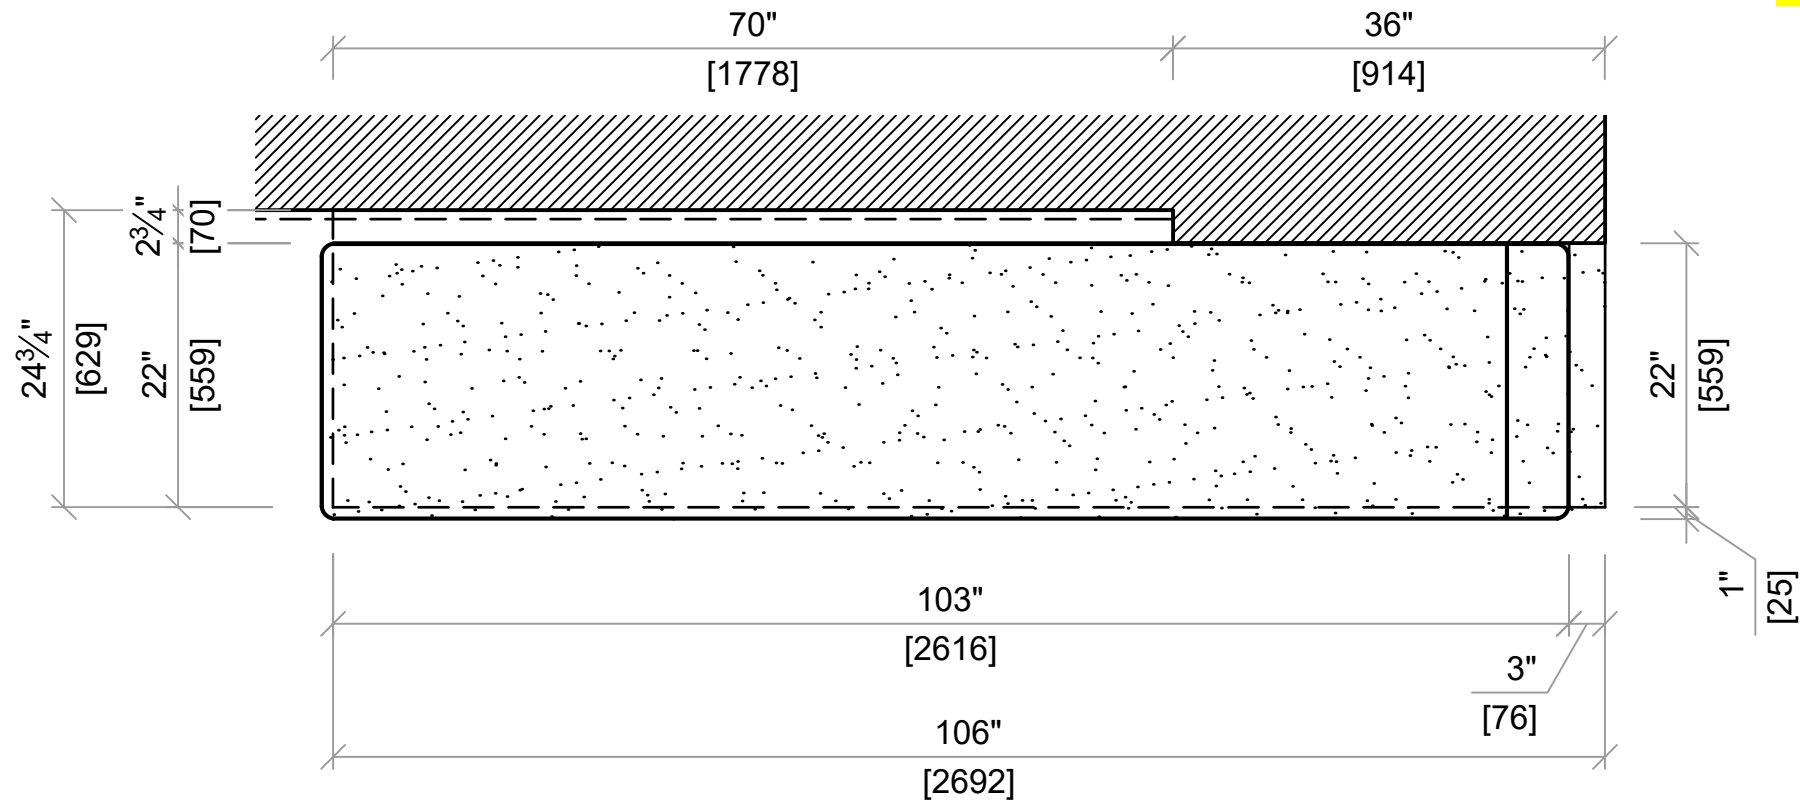


SIDE ELEVATION

侧面图

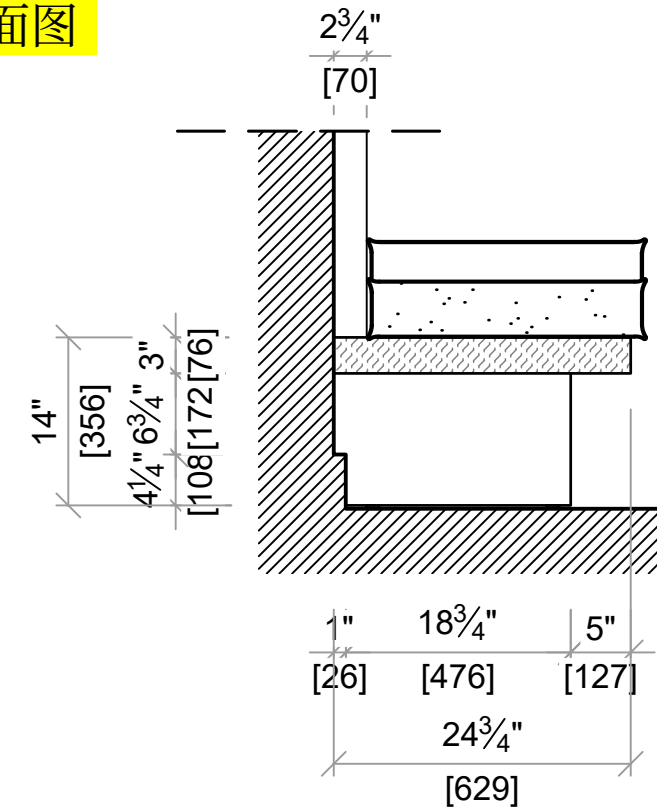


FRONT ELEVATION

正面图

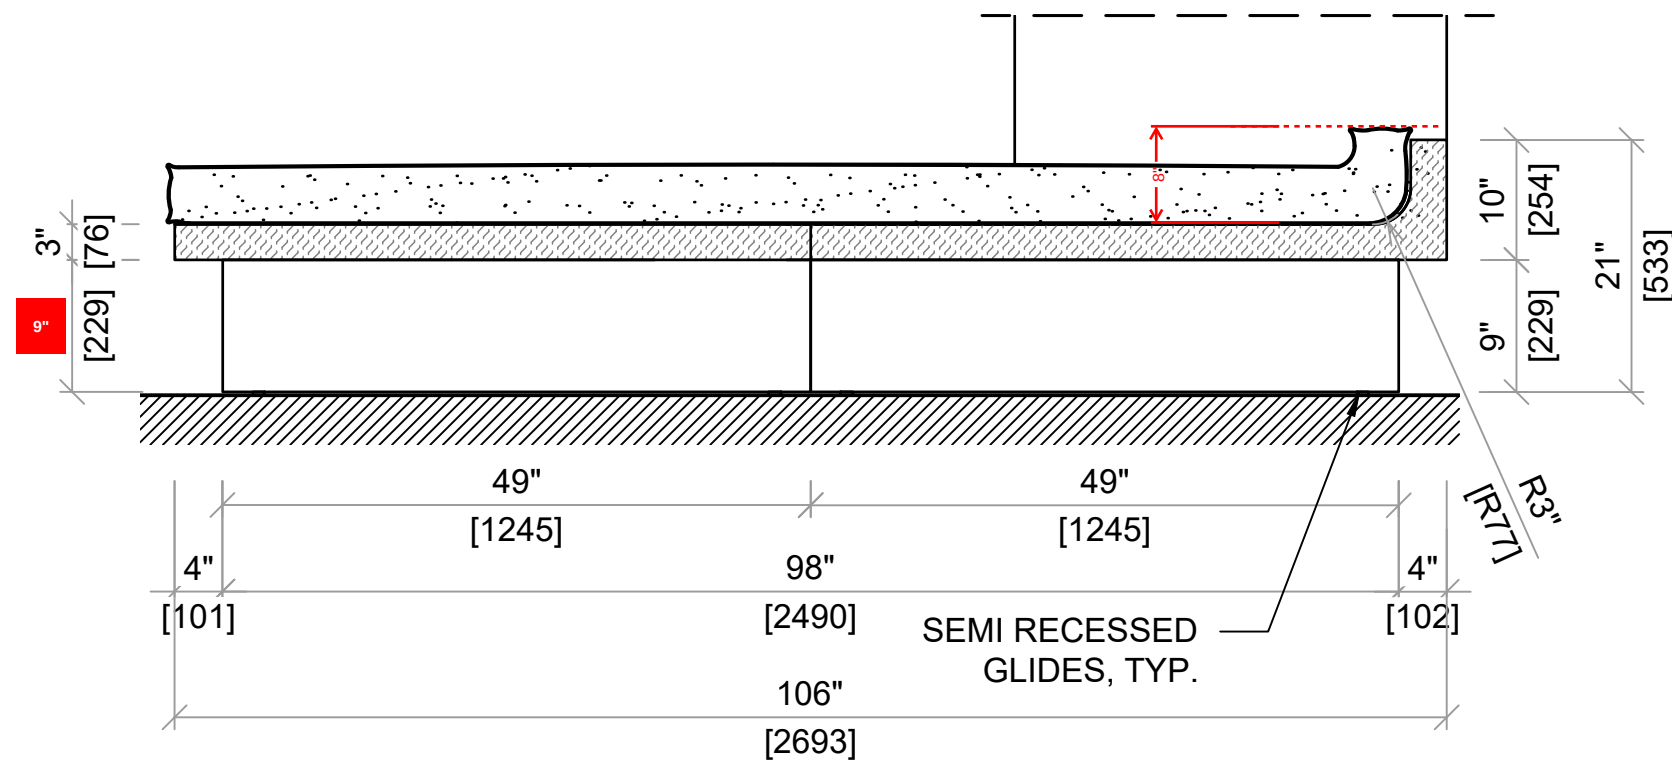

侧面图

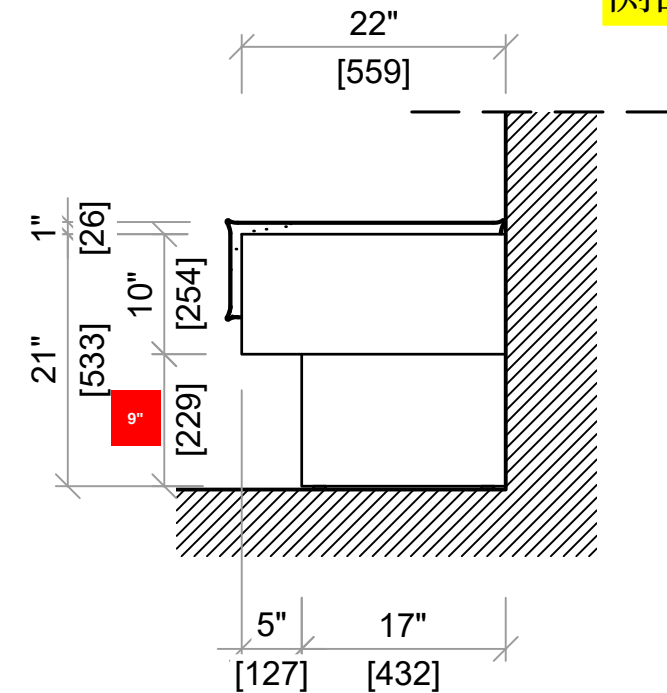

SCALE 3/4" = 1' 0"

ISSUED FOR:	DATE:	BY:
DATE ISSUED	06/26/2025	MK

PROJECT TITLE:

WALLER CREEK

ITEM NUMBER:

GR-IF-120.6

DESCRIPTION:

BENCH

SPECIFICATIONS:

MATERIAL:
ST-01: PORTUGAL BEIGE LIMESTONE
UP-120.6: UPHOLSTERY

FINISH:
STONE: HONED SURFACE
CHISELLED SURFACE ALL SURFACES:
MATTE PROTECTIVE SEALANT

NOTES:

JOB NO: 320C

DRAWN BY: MK/YA


DATE DRAWN: 6/26/2025

SCALE: AS NOTED


SHEET:

02

PLAN VIEW
平面剖面图

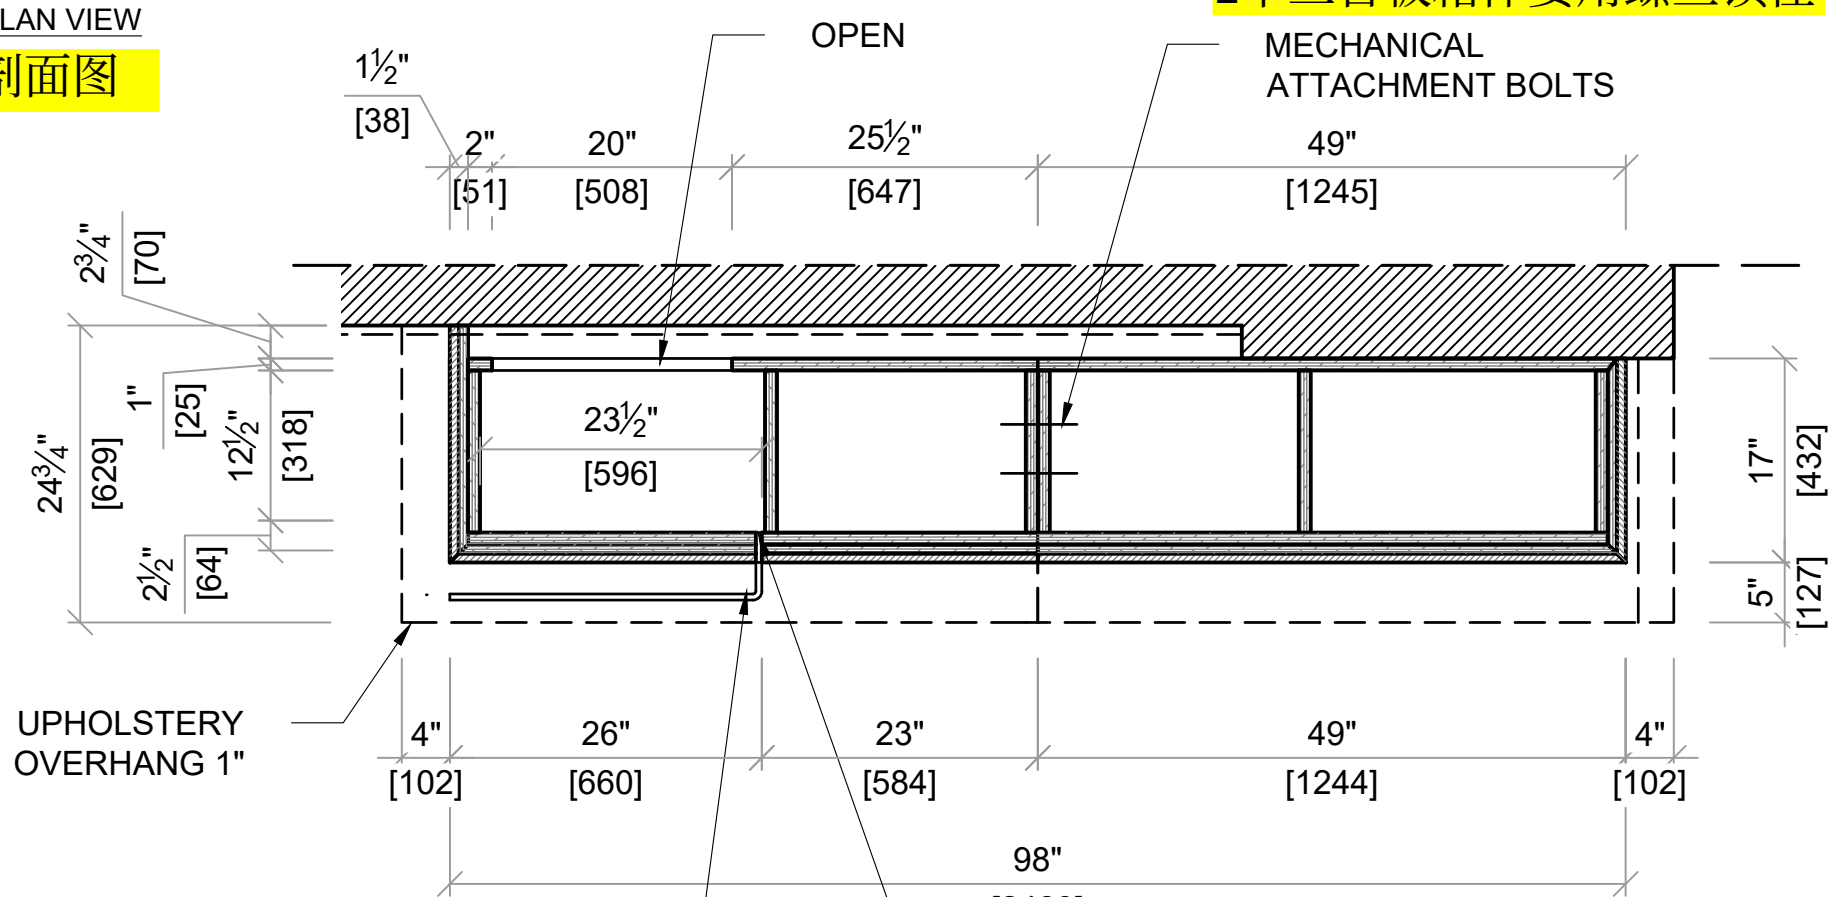

SECTION A
立面剖面图A

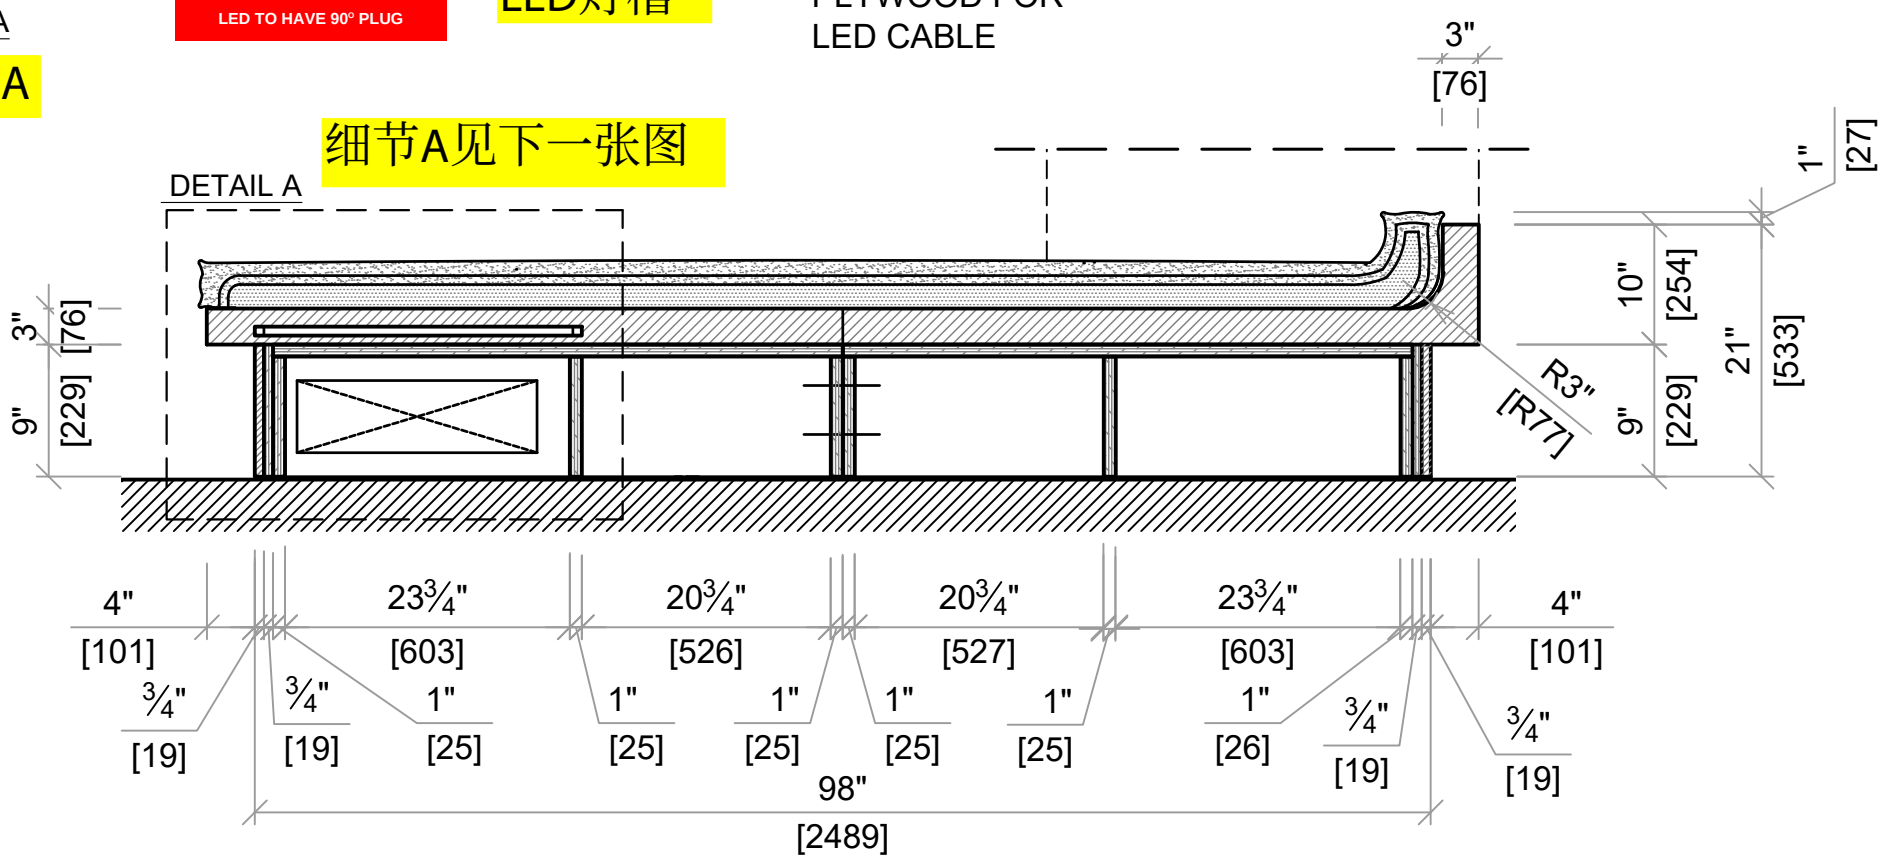

SCALE 3/4" = 1' 0"

ISSUED FOR:	DATE:	BY:
DATE ISSUED	06/26/2025	MK

PROJECT TITLE:
WALLER CREEK

ITEM NUMBER:
GR-IF-120.6



DESCRIPTION:
BENCH

SPECIFICATIONS:
MATERIAL:
ST-01: PORTUGAL BEIGE LIMESTONE
UP-120.6: UPHOLSTERY
FINISH:
STONE: HONED SURFACE
CHISELLED SURFACE ALL SURFACES:
MATTE PROTECTIVE SEALANT

NOTES:

JOB NO:	320C
DRAWN BY:	MK/YA
DATE DRAWN:	6/26/2025
SCALE:	AS NOTED
SHEET:	

DETAIL A
细节A

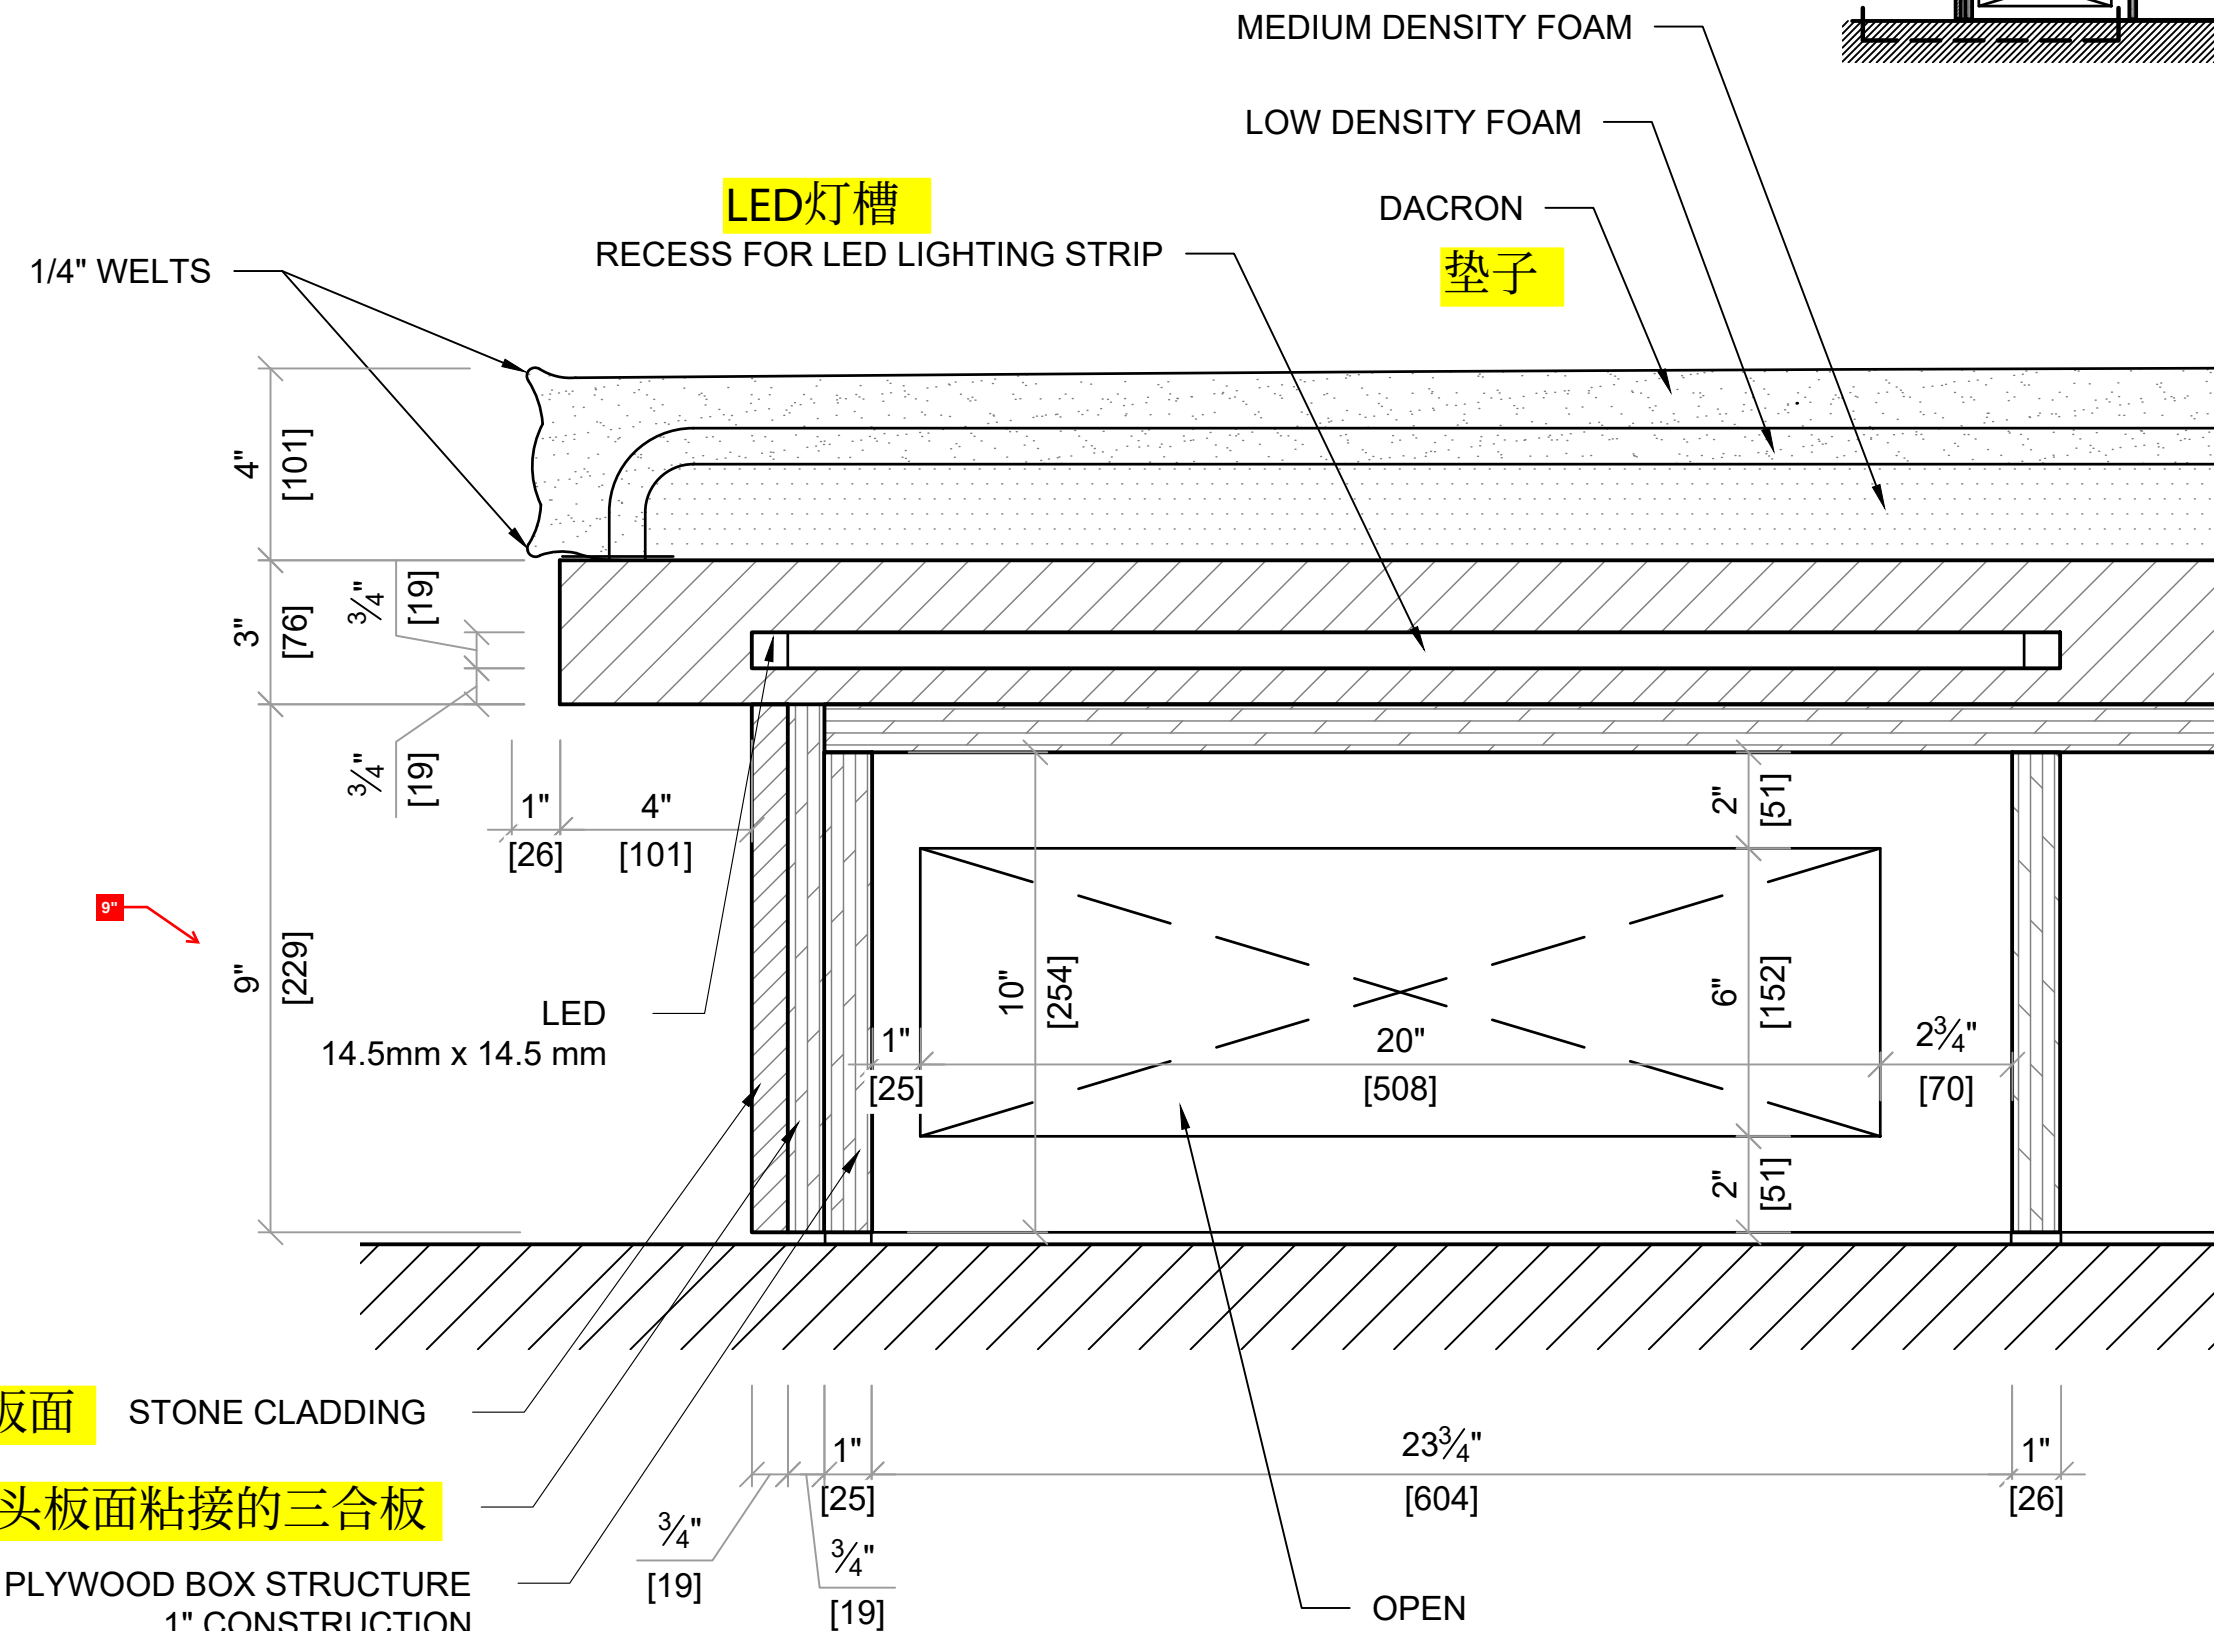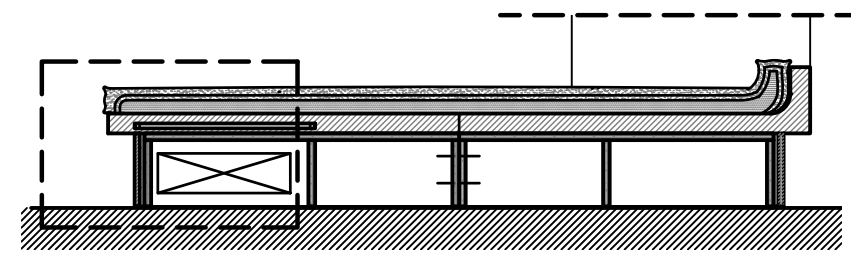

石头板面 STONE CLADDING

与石头板面粘接的三合板

PLYWOOD BOX STRUCTURE
1\" CONSTRUCTION

1\"厚的三合板箱体

开孔

SCALE 3\" = 1' 0\"

ISSUED FOR:	DATE:	BY:
DATE ISSUED	06/26/2025	MK
PROJECT TITLE:		
WALLER CREEK		
ITEM NUMBER:		
GR-IF-120.6		
DESCRIPTION:		
BENCH		
SPECIFICATIONS:		
MATERIAL: ST-01: PORTUGAL BEIGE LIMESTONE UP-120.6: UPHOLSTERY		
FINISH: STONE: HONED SURFACE CHISELLED SURFACE ALL SURFACES: MATTE PROTECTIVE SEALANT		
NOTES:		
JOB NO:	320C	
DRAWN BY:	MK/YA	
DATE DRAWN:	6/26/2025	
SCALE:	AS NOTED	
SHEET:		

侧面剖面图B



SCALE 3" = 1' 0"

ISSUED FOR:	DATE:	BY:
DATE ISSUED	06/26/2025	MK

PROJECT TITLE:

WALLER CREEK

ITEM NUMBER:

GR-IF-120.6

DESCRIPTION:

BENCH

SPECIFICATIONS:

MATERIAL:

T-01: PORTUGAL BEIGE LIMESTONE

UP-120.6: UPHOLSTERY

FINISH:
STONE: HONED SURFACE
CHISELLED SURFACE ALL SURFACES:
MATTE PROTECTIVE SEALANT

NOTES:

JOB NO: 320C

DRAWN BY: MK/YA


DATE DRAWN: 6/26/2025

SCALE: AS NOTED

SHEET:

05

侧面剖面图C

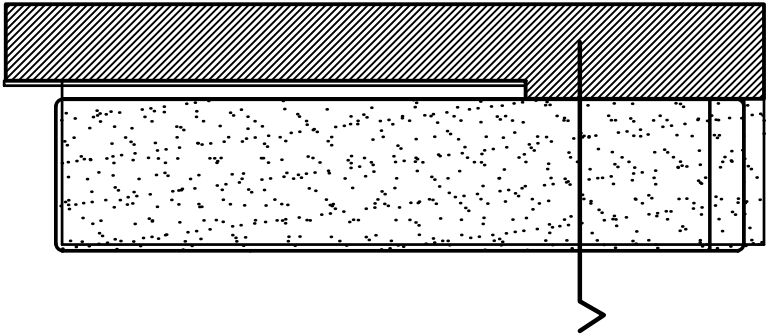

ISSUED FOR:	DATE:	BY:
DATE ISSUED	06/26/2025	MK

PROJECT TITLE:

WALLER CREEK

ITEM NUMBER:

GR-IF-120.6

DESCRIPTION:

BENCH

SPECIFICATIONS:

MATERIAL:
ST-01: PORTUGAL BEIGE LIMESTONE
UP-120.6: UPHOLSTERY

FINISH:

STONE: HONED SURFACE
CHISELLED SURFACE ALL SURFACES:
MATTE PROTECTIVE SEALANT

NOTES:

JOB NO: 320C

DRAWN BY: MK/YA

DATE DRAWN: 6/26/2025

SCALE: AS NOTED


SHEET:

06

SCALE 3" = 1' 0"

GENERAL NOTE
STUDY HEIGHT OF BENCH WITH TABLE AND CHAIR

GR - IF - 120.7
石头：葡萄牙米黄
加工：哑光面+自然边+防水
数量：1套

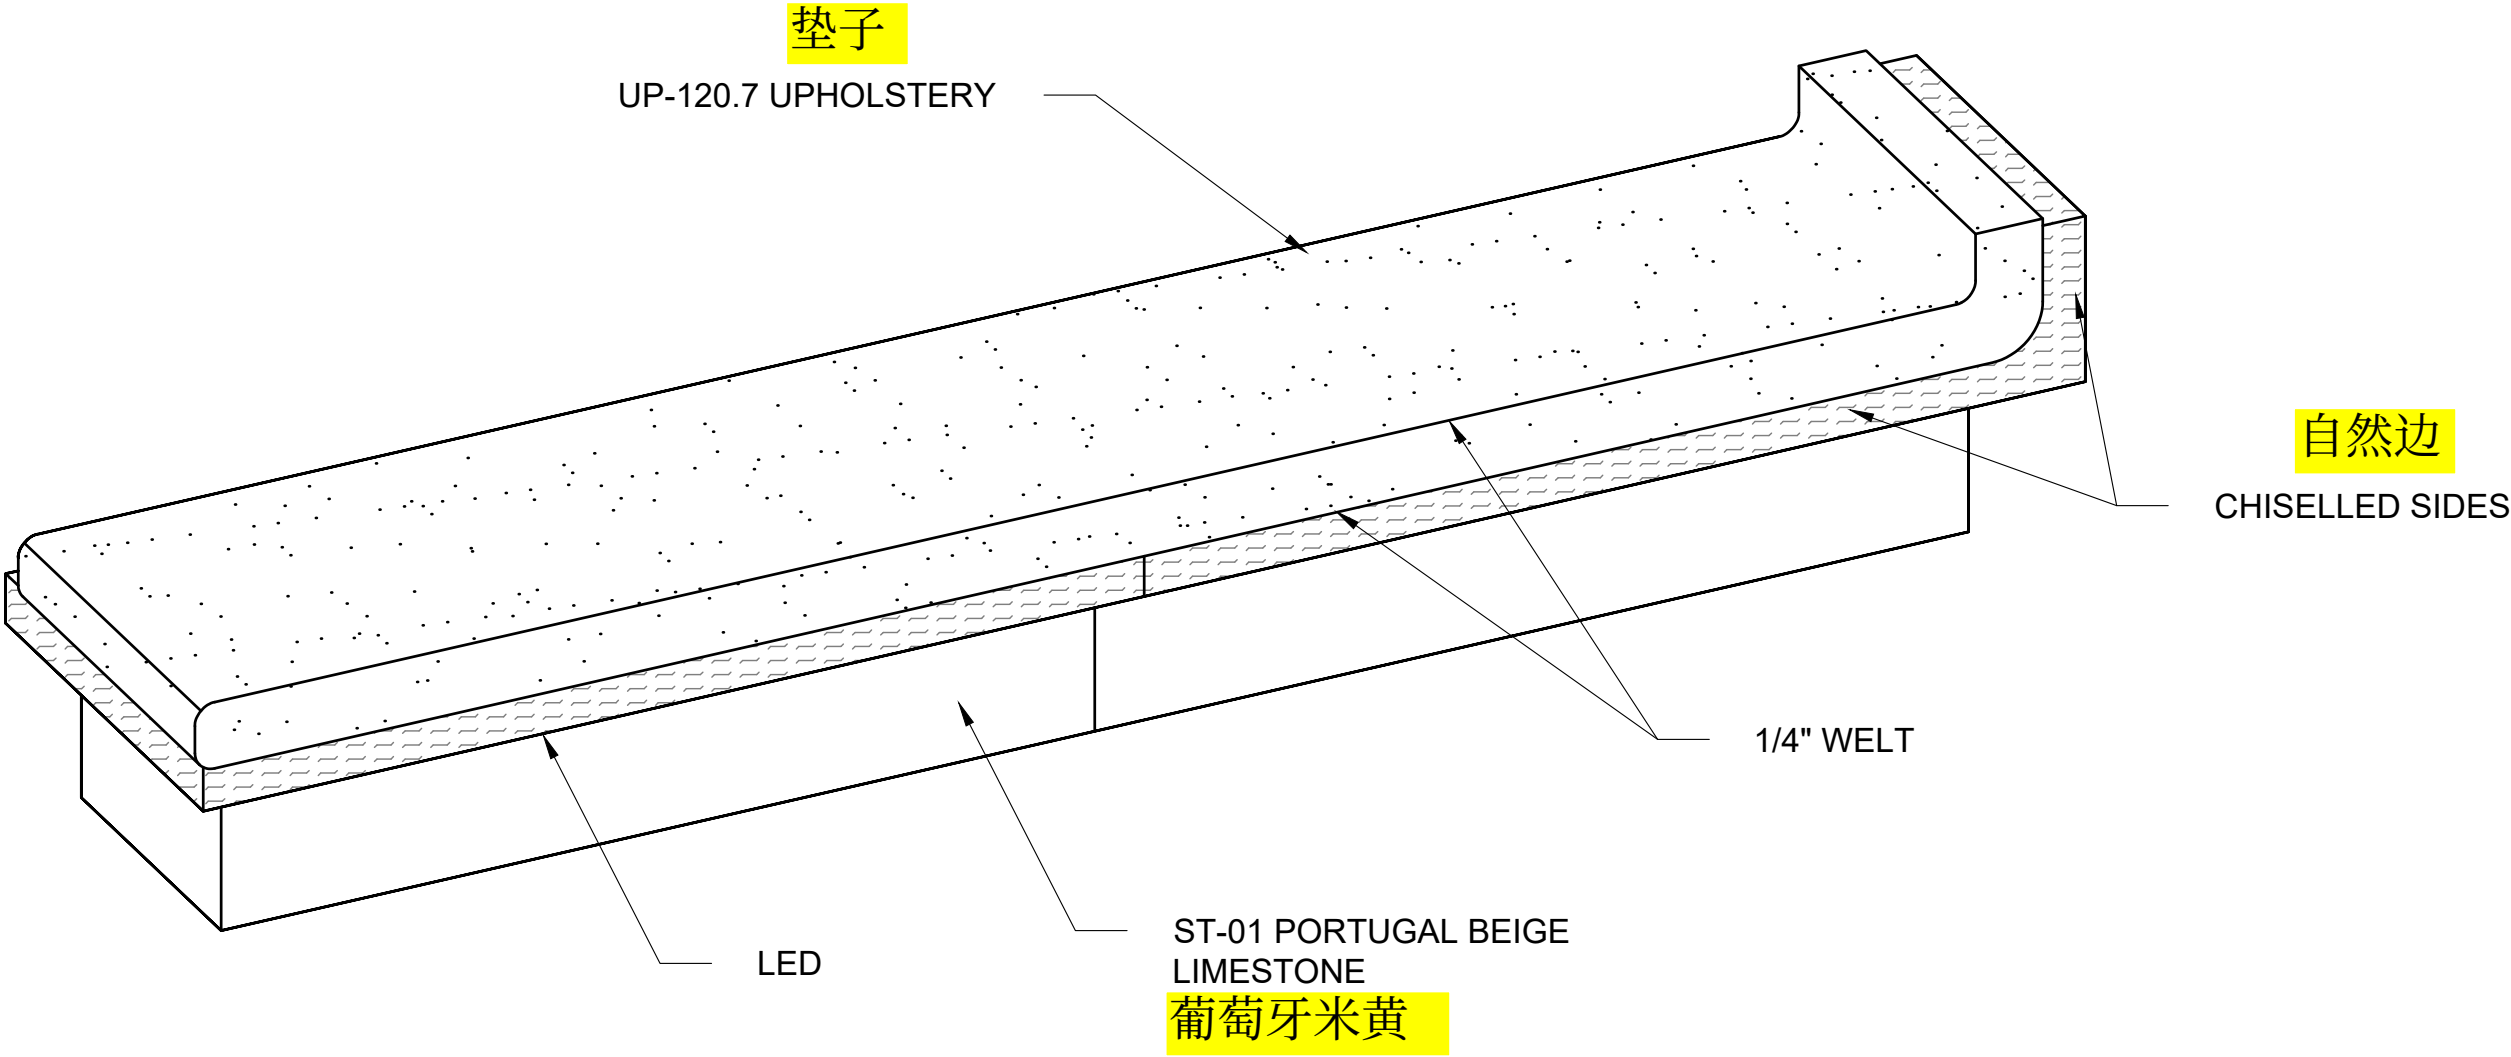

Reviewed No Exceptions Noted ()
Reviewed Exceptions Noted (X)
Revise and Resubmit ()
Rejected ()


By XAVIER ESCRIBU Date 6/30/2025

ISSUED FOR:	DATE:	BY:
DATE ISSUED	06/26/2025	MK

PROJECT TITLE:
WALLER CREEK
ITEM NUMBER:
GR-IF-120.7
DESCRIPTION:
BENCH
SPECIFICATIONS:
MATERIAL: ST-01: PORTUGAL BEIGE LIMESTONE UP-120.7: UPHOLSTERY
FINISH: STONE: HONED SURFACE CHISELLED SURFACE ALL SURFACES: MATTE PROTECTIVE SEALANT
NOTES:
JOB NO: 320C
DRAWN BY: MK/YA
DATE DRAWN: 6/26/2025
SCALE: AS NOTED
SHEET:


TOP VIEW

俯视图

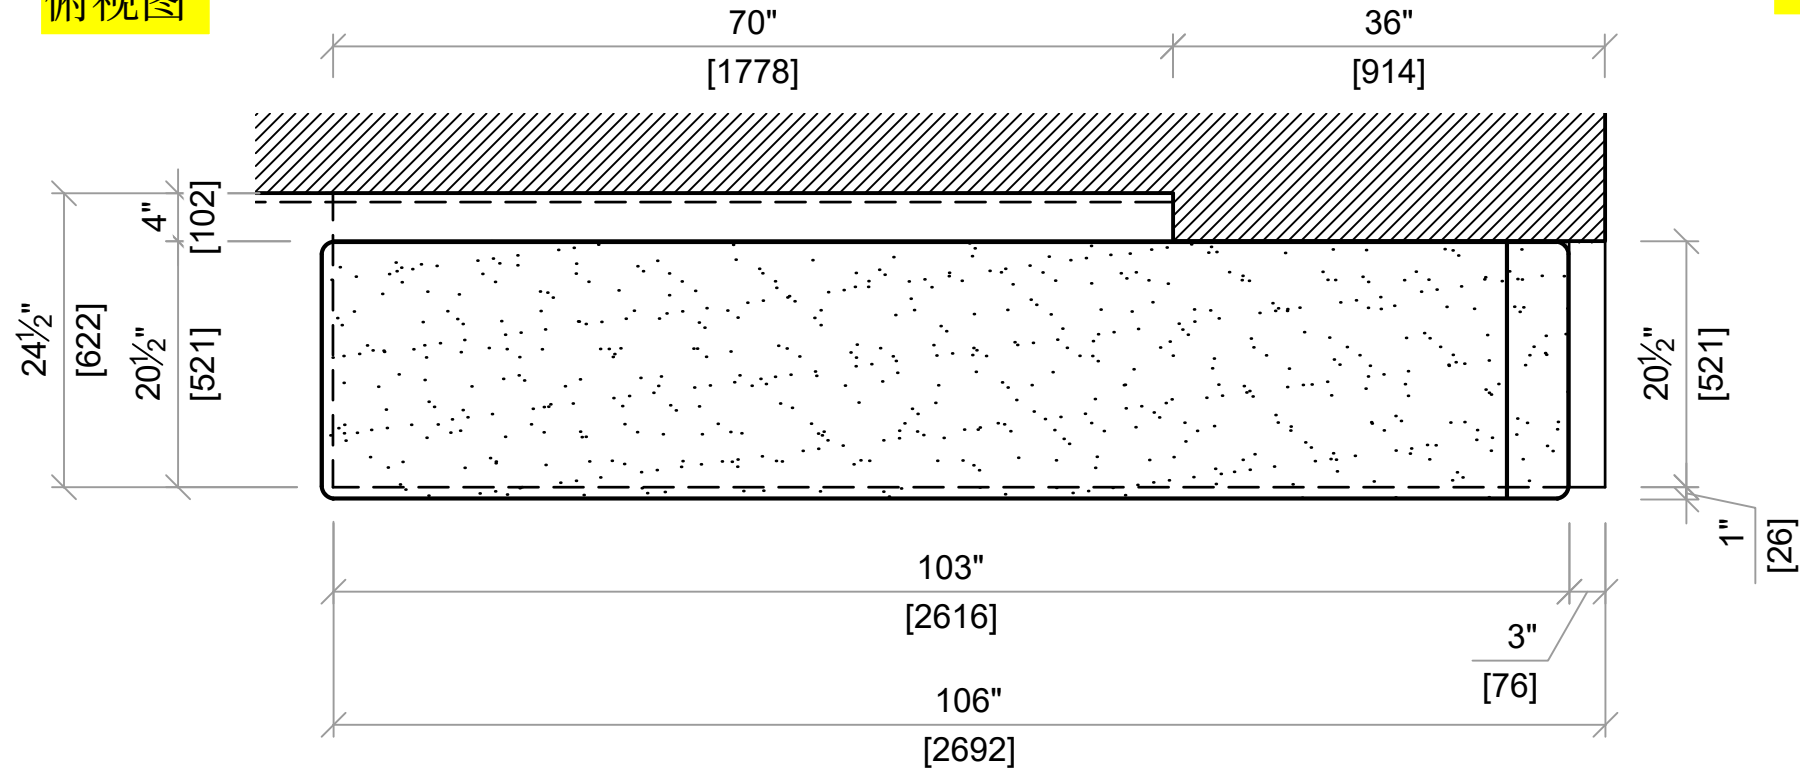


SIDE ELEVATION

侧面图

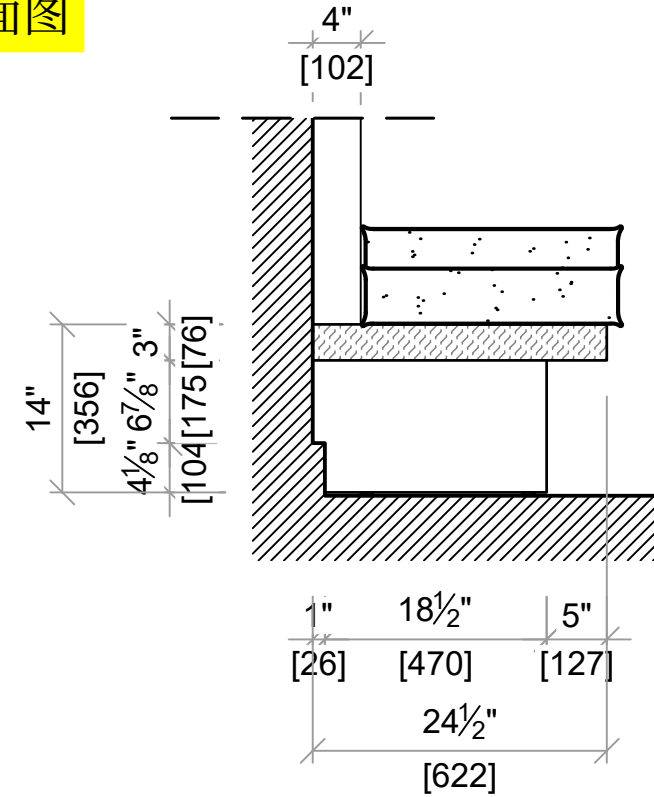


FRONT ELEVATION

正面图

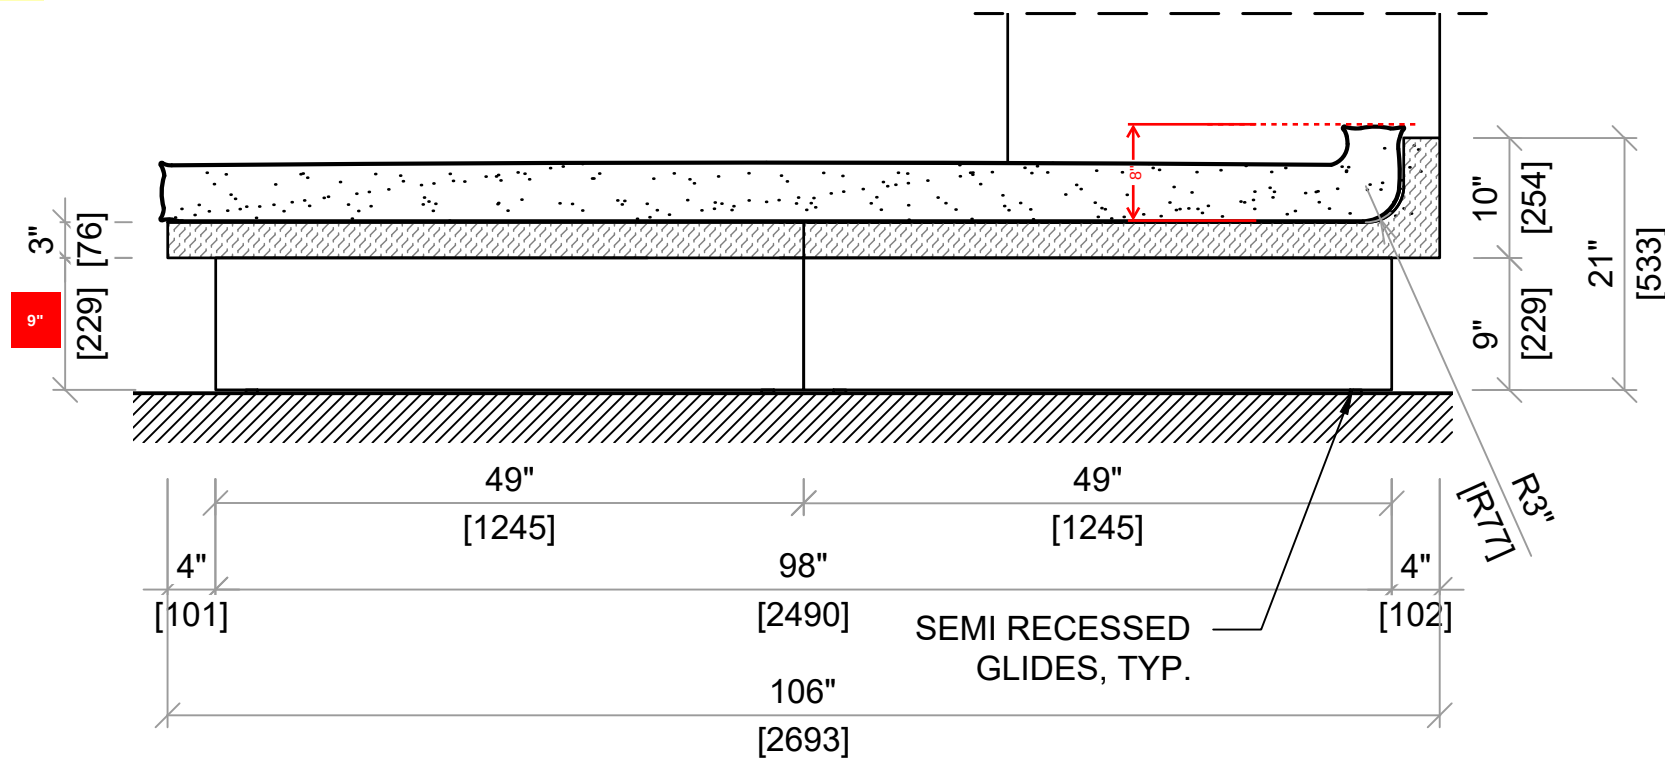

侧面图

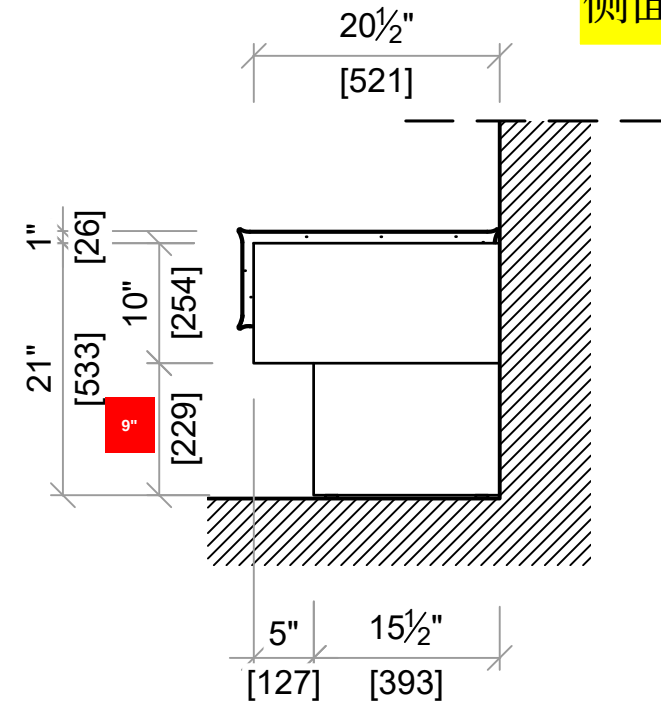

ISSUED FOR:	DATE:	BY:
DATE ISSUED	06/26/2025	MK

PROJECT TITLE:
WALLER CREEK

ITEM NUMBER:
GR-IF-120.7

DESCRIPTION:
BENCH

SPECIFICATIONS:
MATERIAL:
ST-01: PORTUGAL BEIGE LIMESTONE
UP-120.7: UPHOLSTERY


FINISH:
STONE: HONED SURFACE
CHISELED SURFACE ALL SURFACES:
MATTE PROTECTIVE SEALANT

NOTES:

JOB NO:	320C
DRAWN BY:	MK/YA
DATE DRAWN:	6/26/2025
SCALE:	AS NOTED
SHEET:	


PLAN VIEW

平面剖面图

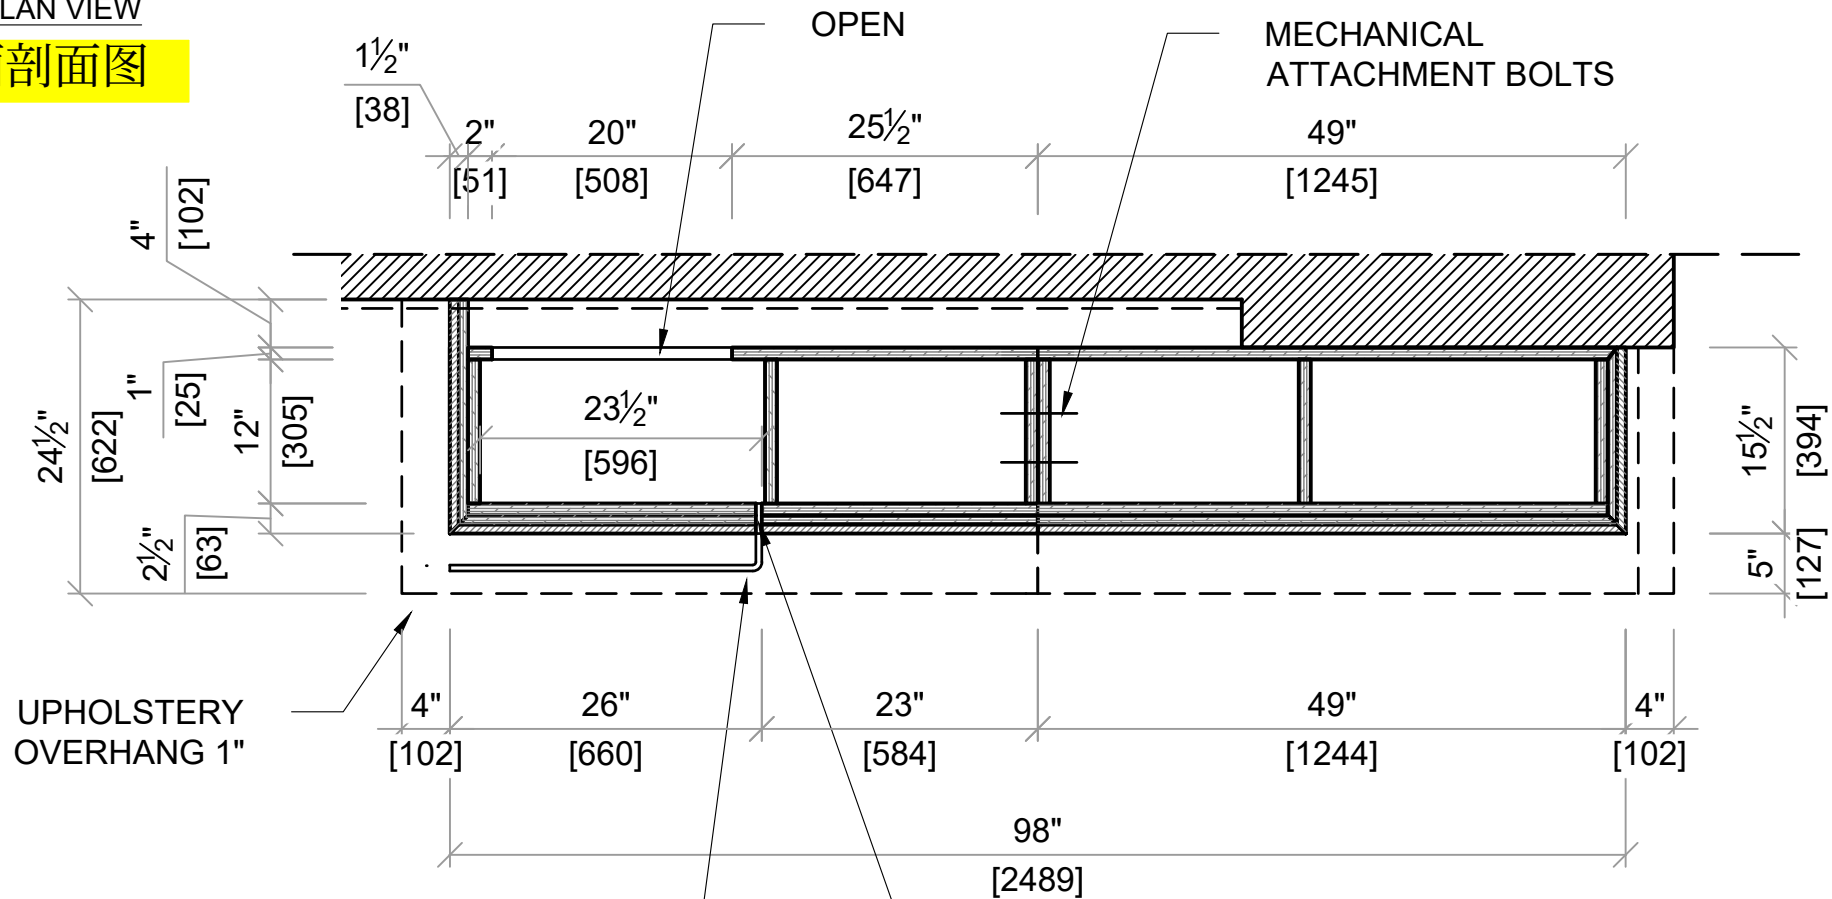

SECTION A

立面剖面图A

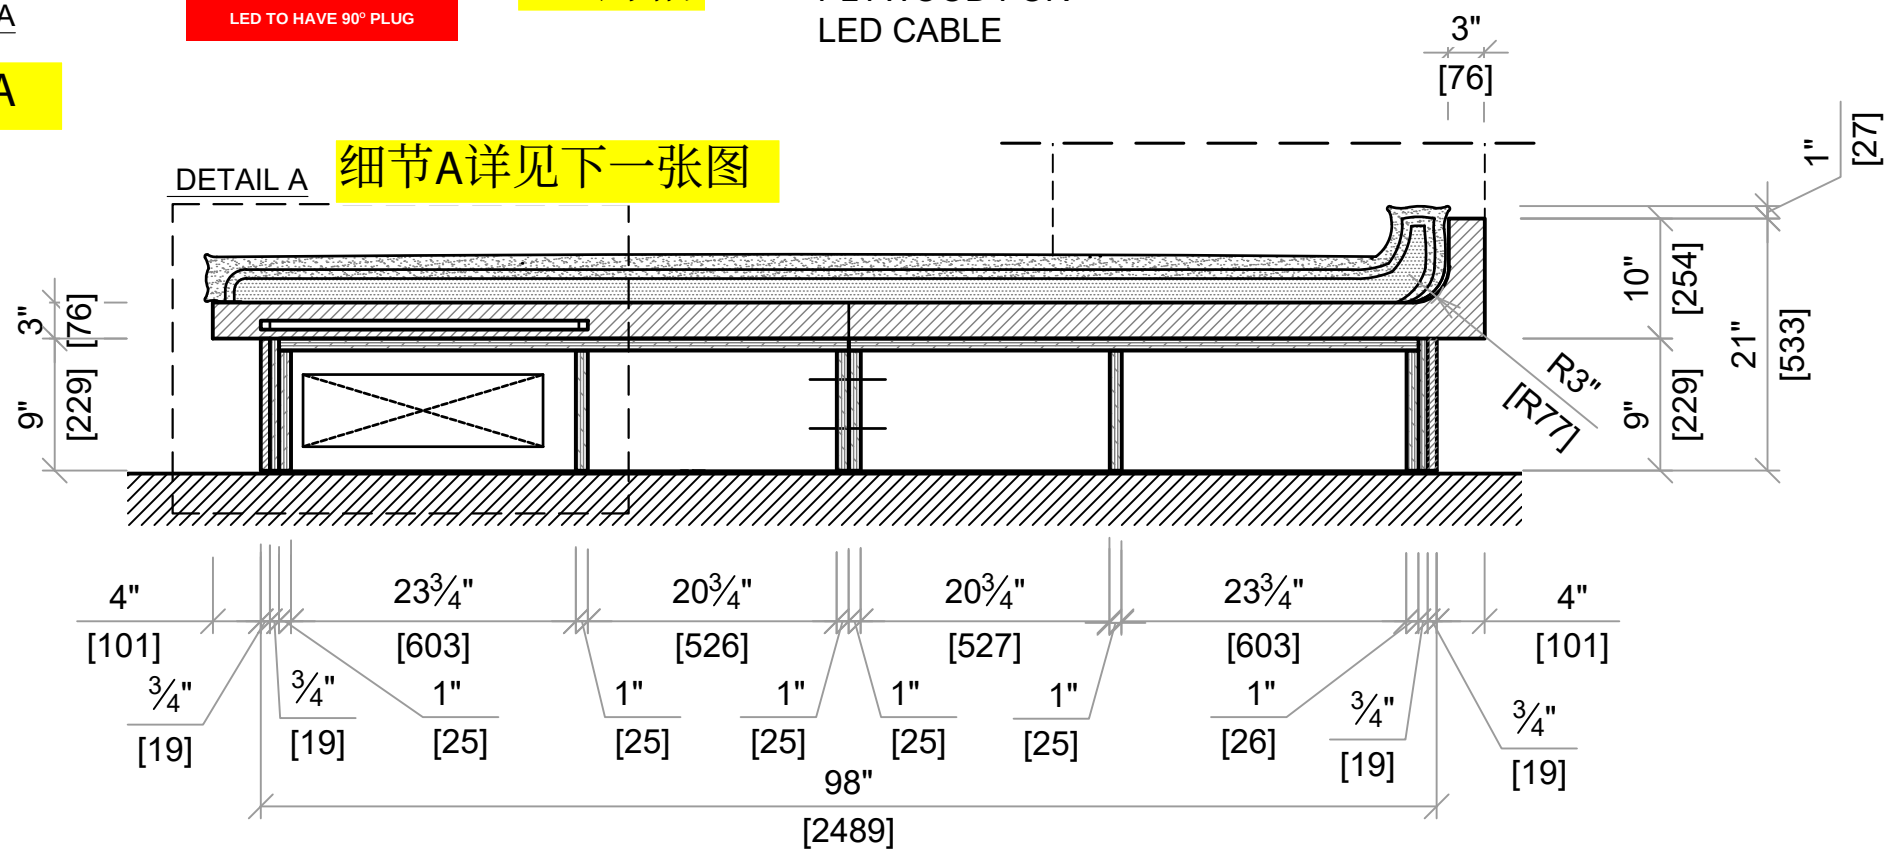

SCALE 3/4" = 1' 0"

ISSUED FOR:	DATE:	BY:
DATE ISSUED	06/26/2025	MK

PROJECT TITLE:

WALLER CREEK

ITEM NUMBER:

GR-IF-120.7

DESCRIPTION:

BENCH

SPECIFICATIONS:

MATERIAL:



ST-01: PORTUGAL BEIGE LIMESTONE
UP-120.7: UPHOLSTERY

FINISH:

STONE: HONED SURFACE
CHISELLED SURFACE ALL SURFACES:
MATTE PROTECTIVE SEALANT

NOTES:

JOB NO:	320C
DRAWN BY:	MK/YA
DATE DRAWN:	6/26/2025
SCALE:	AS NOTED
SHEET:	

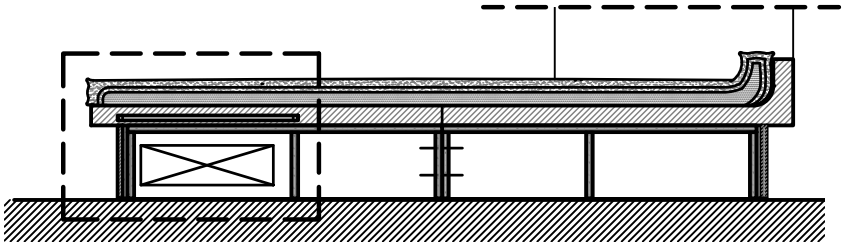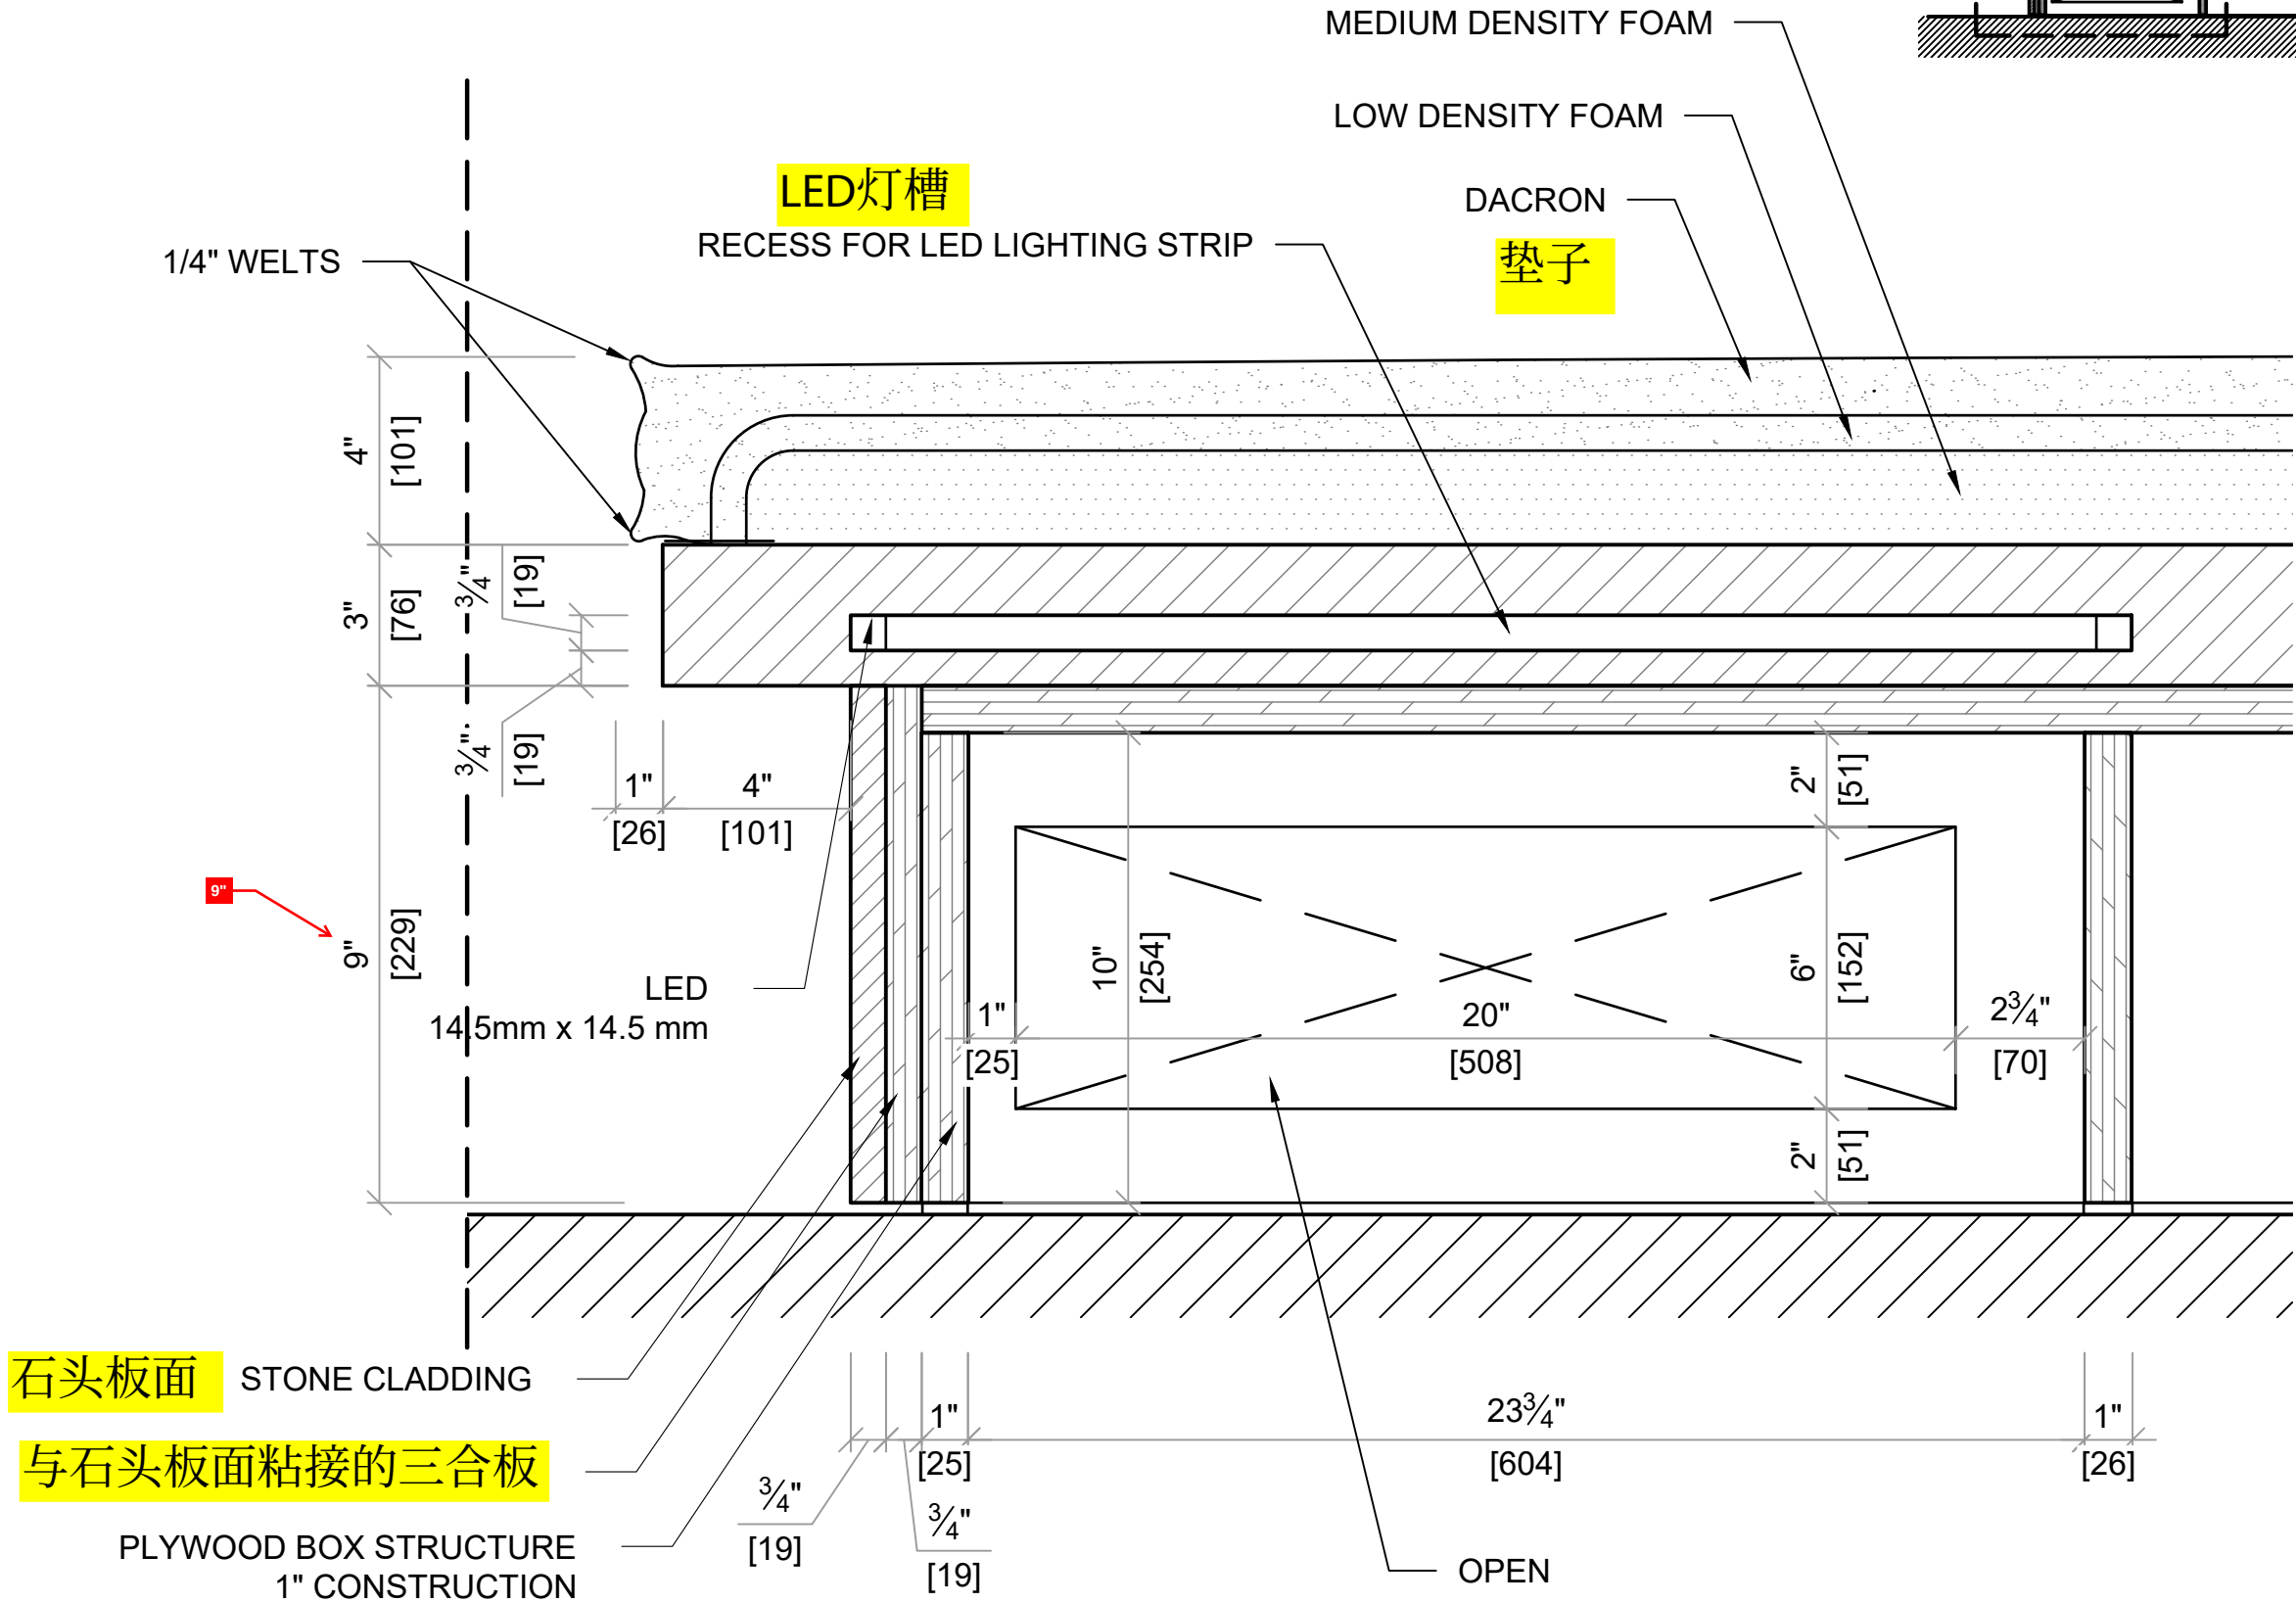

ISSUED FOR:	DATE:	BY:
DATE ISSUED	06/26/2025	MK


PROJECT TITLE:
WALLER CREEK
ITEM NUMBER:
GR-IF-120.7
DESCRIPTION:
BENCH

SPECIFICATIONS:
MATERIAL:
ST-01: PORTUGAL BEIGE LIMESTONE
UP-120.7: UPHOLSTERY
FINISH:
STONE: HONED SURFACE
CHISELLED SURFACE ALL SURFACES:
MATTE PROTECTIVE SEALANT

NOTES:
JOB NO:
320C
DRAWN BY:
MK/YA
DATE DRAWN:
6/26/2025
SCALE:
AS NOTED
SHEET:

SECTION B

侧面剖面图B

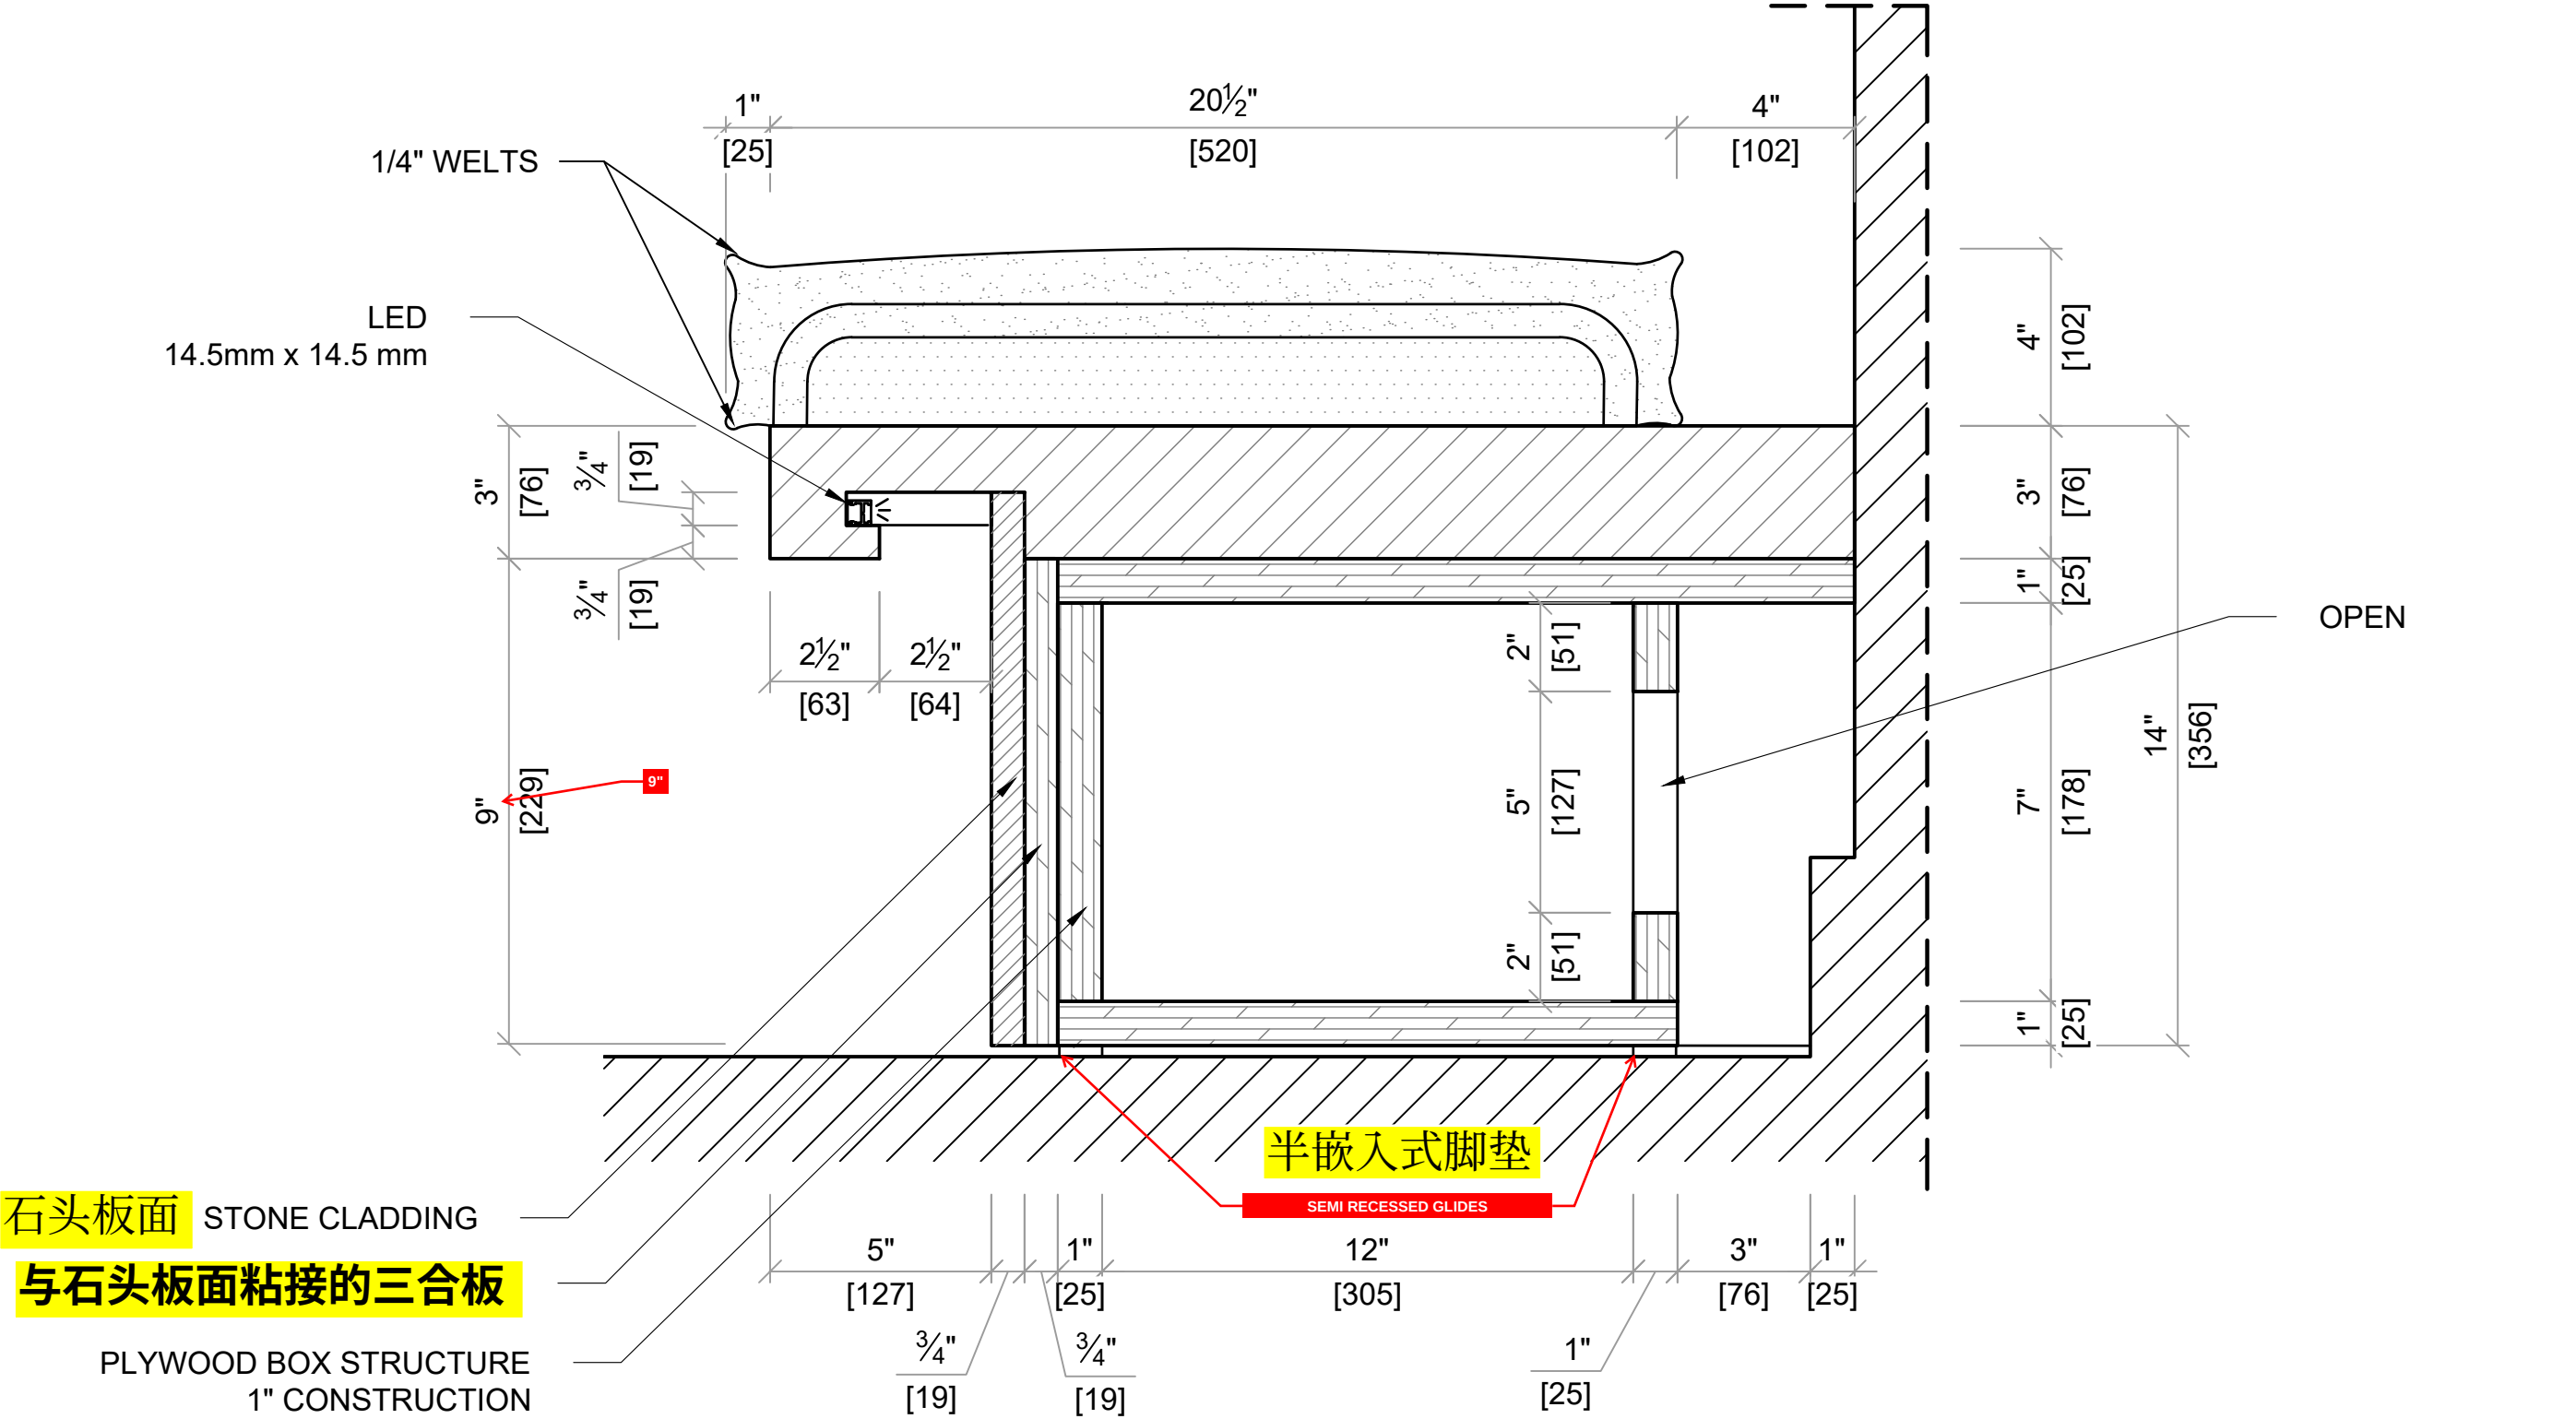

SCALE 3" = 1' 0"

ISSUED FOR:	DATE:	BY:
DATE ISSUED	06/26/2025	MK


PROJECT TITLE:
WALLER CREEK
ITEM NUMBER:
GR-IF-120.7
DESCRIPTION:
BENCH

SPECIFICATIONS:
MATERIAL:
ST-01: PORTUGAL BEIGE LIMESTONE
UP-120.7: UPHOLSTERY
FINISH:
STONE: HONED SURFACE
CHISELLED SURFACE ALL SURFACES:
MATTE PROTECTIVE SEALANT

NOTES:
JOB NO:
320C
DRAWN BY:
MK/YA
DATE DRAWN:
6/26/2025
SCALE:
AS NOTED
SHEET:

SECTION C

侧面剖面图C

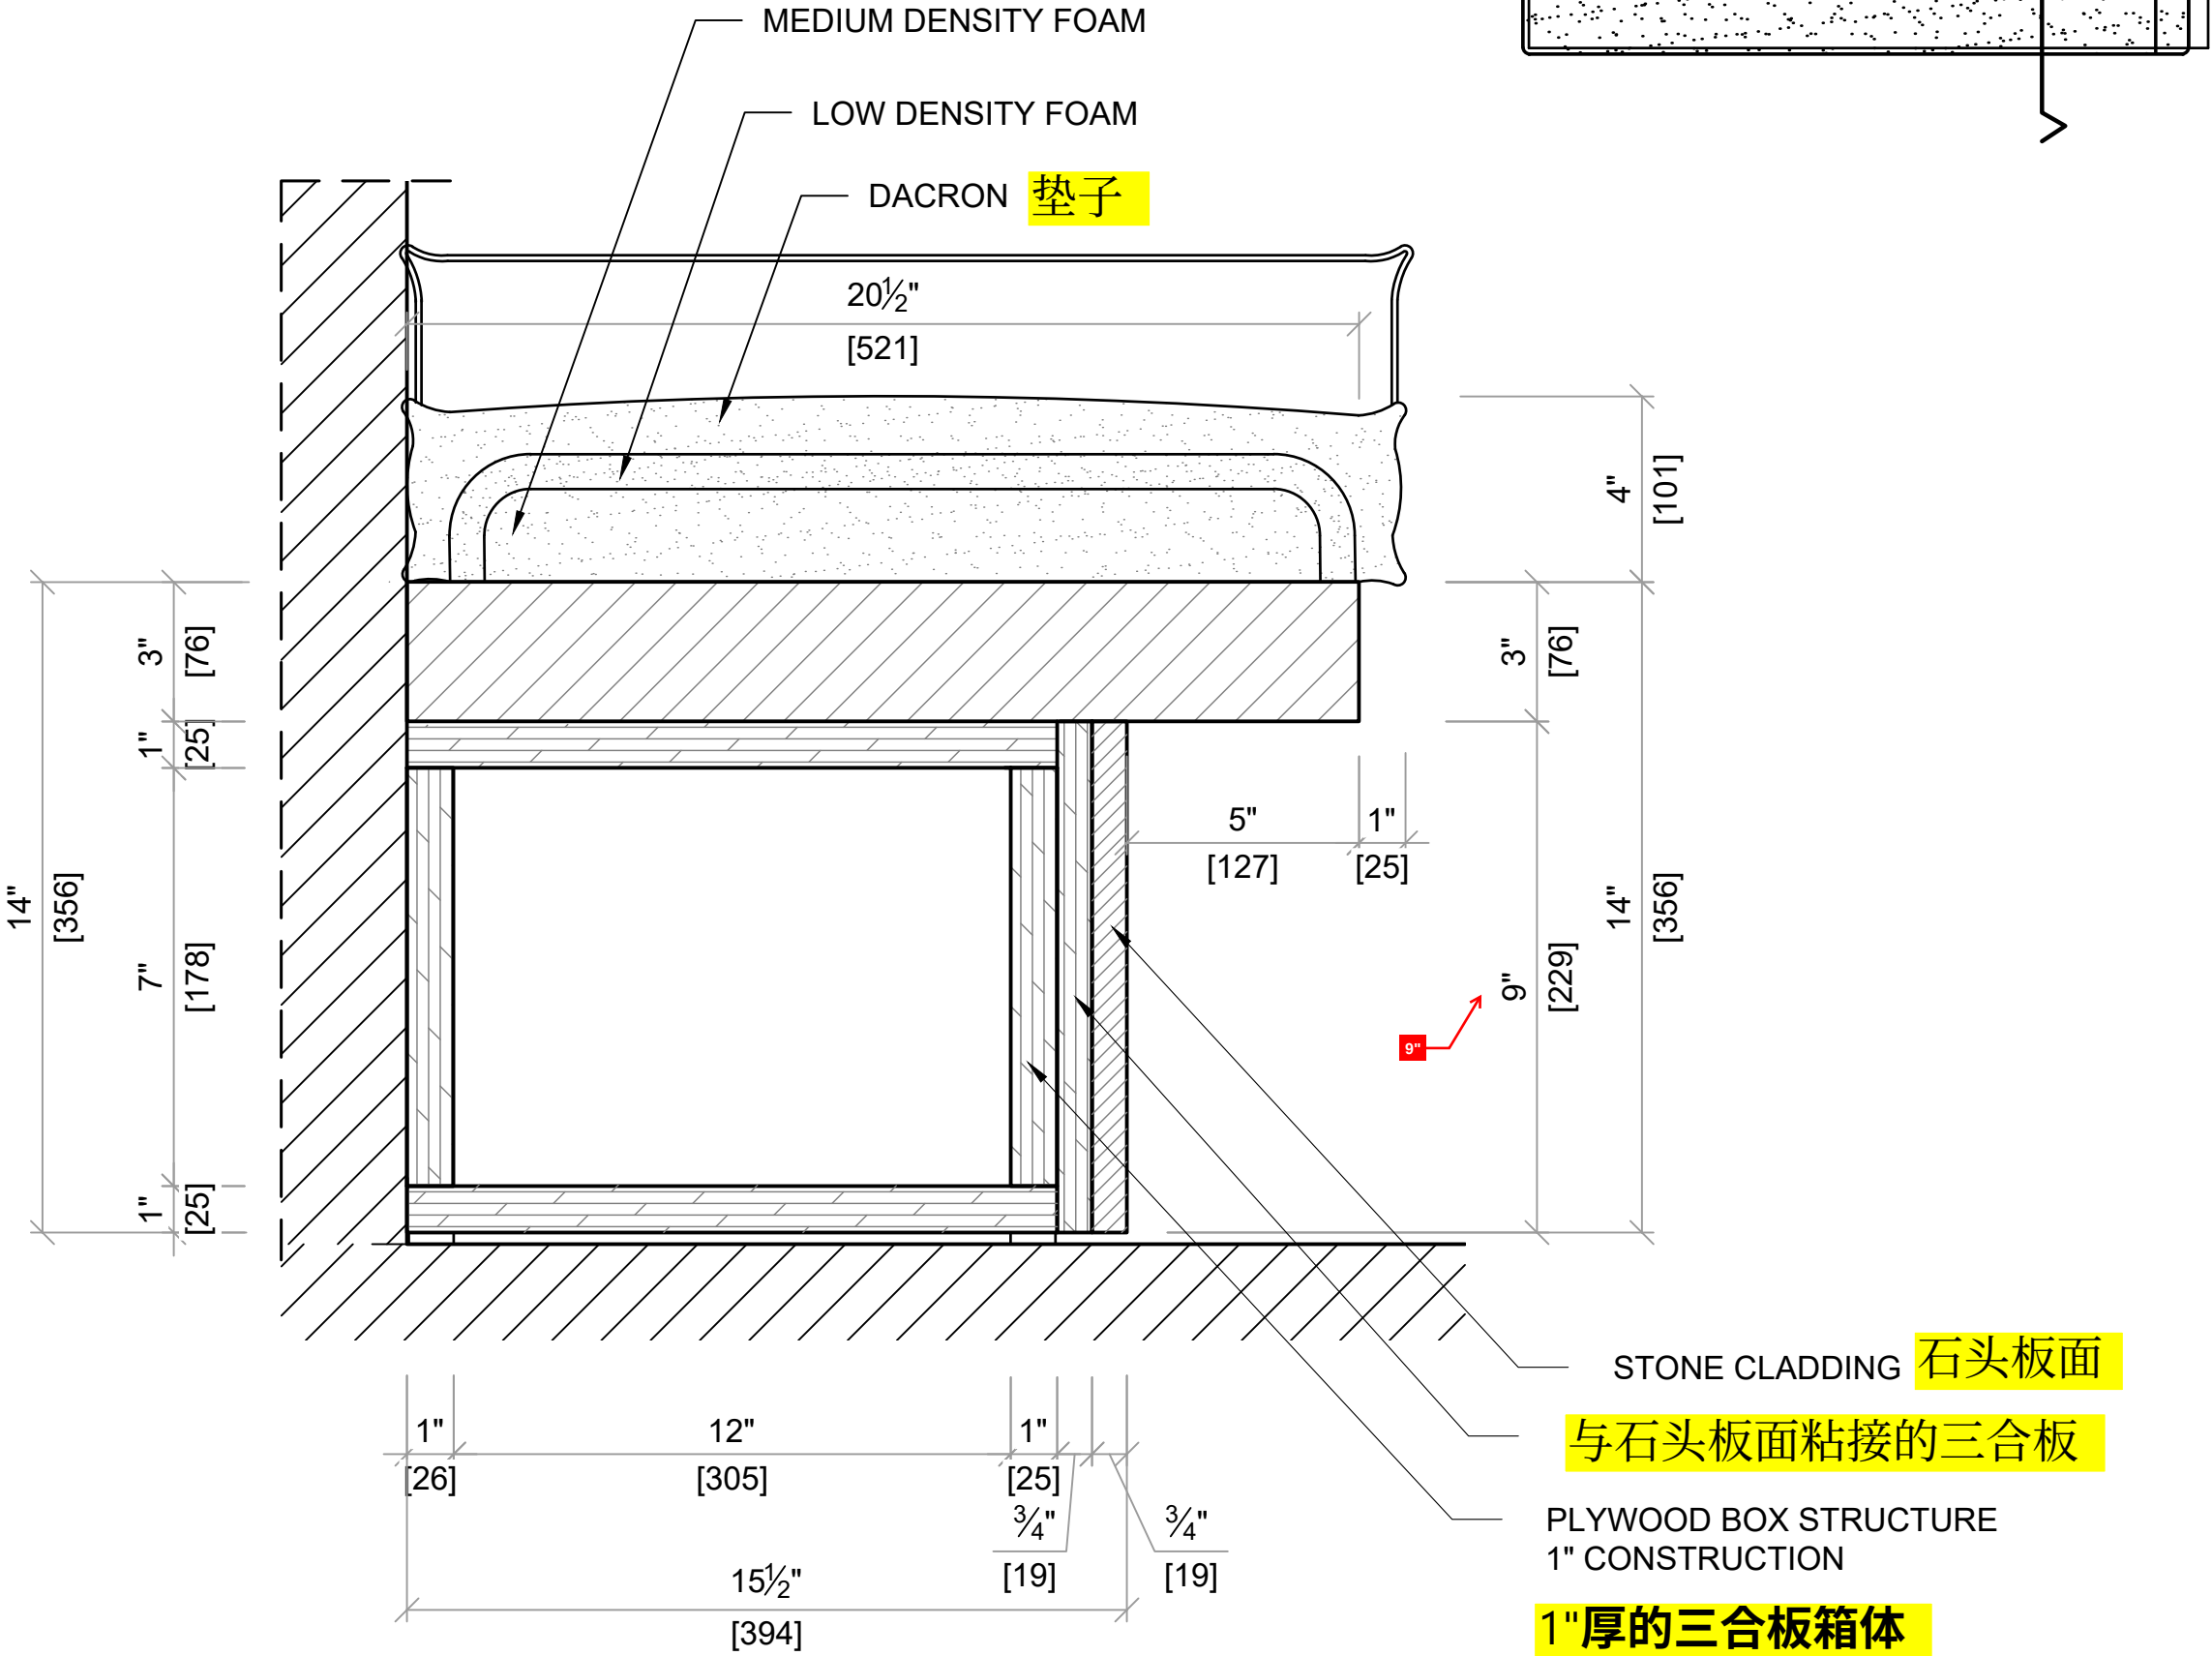

ISSUED FOR:	DATE:	BY:
DATE ISSUED	06/26/2025	MK

PROJECT TITLE:
WALLER CREEK
ITEM NUMBER:
GR-IF-120.7
DESCRIPTION:
BENCH


SPECIFICATIONS:
MATERIAL:
ST-01: PORTUGAL BEIGE LIMESTONE
UP-120.7: UPHOLSTERY
FINISH:
STONE: HONED SURFACE
CHISELLED SURFACE ALL SURFACES:
MATTE PROTECTIVE SEALANT

NOTES:

JOB NO:	320C
DRAWN BY:	MK/YA
DATE DRAWN:	6/26/2025
SCALE:	AS NOTED
SHEET:	

GENERAL NOTE
STUDY HEIGHT OF BENCH WITH TABLE AND CHAIR

GD - IF - 120R
石头：葡萄牙米黄
加工：哑光面+自然边+防水
数量：10套

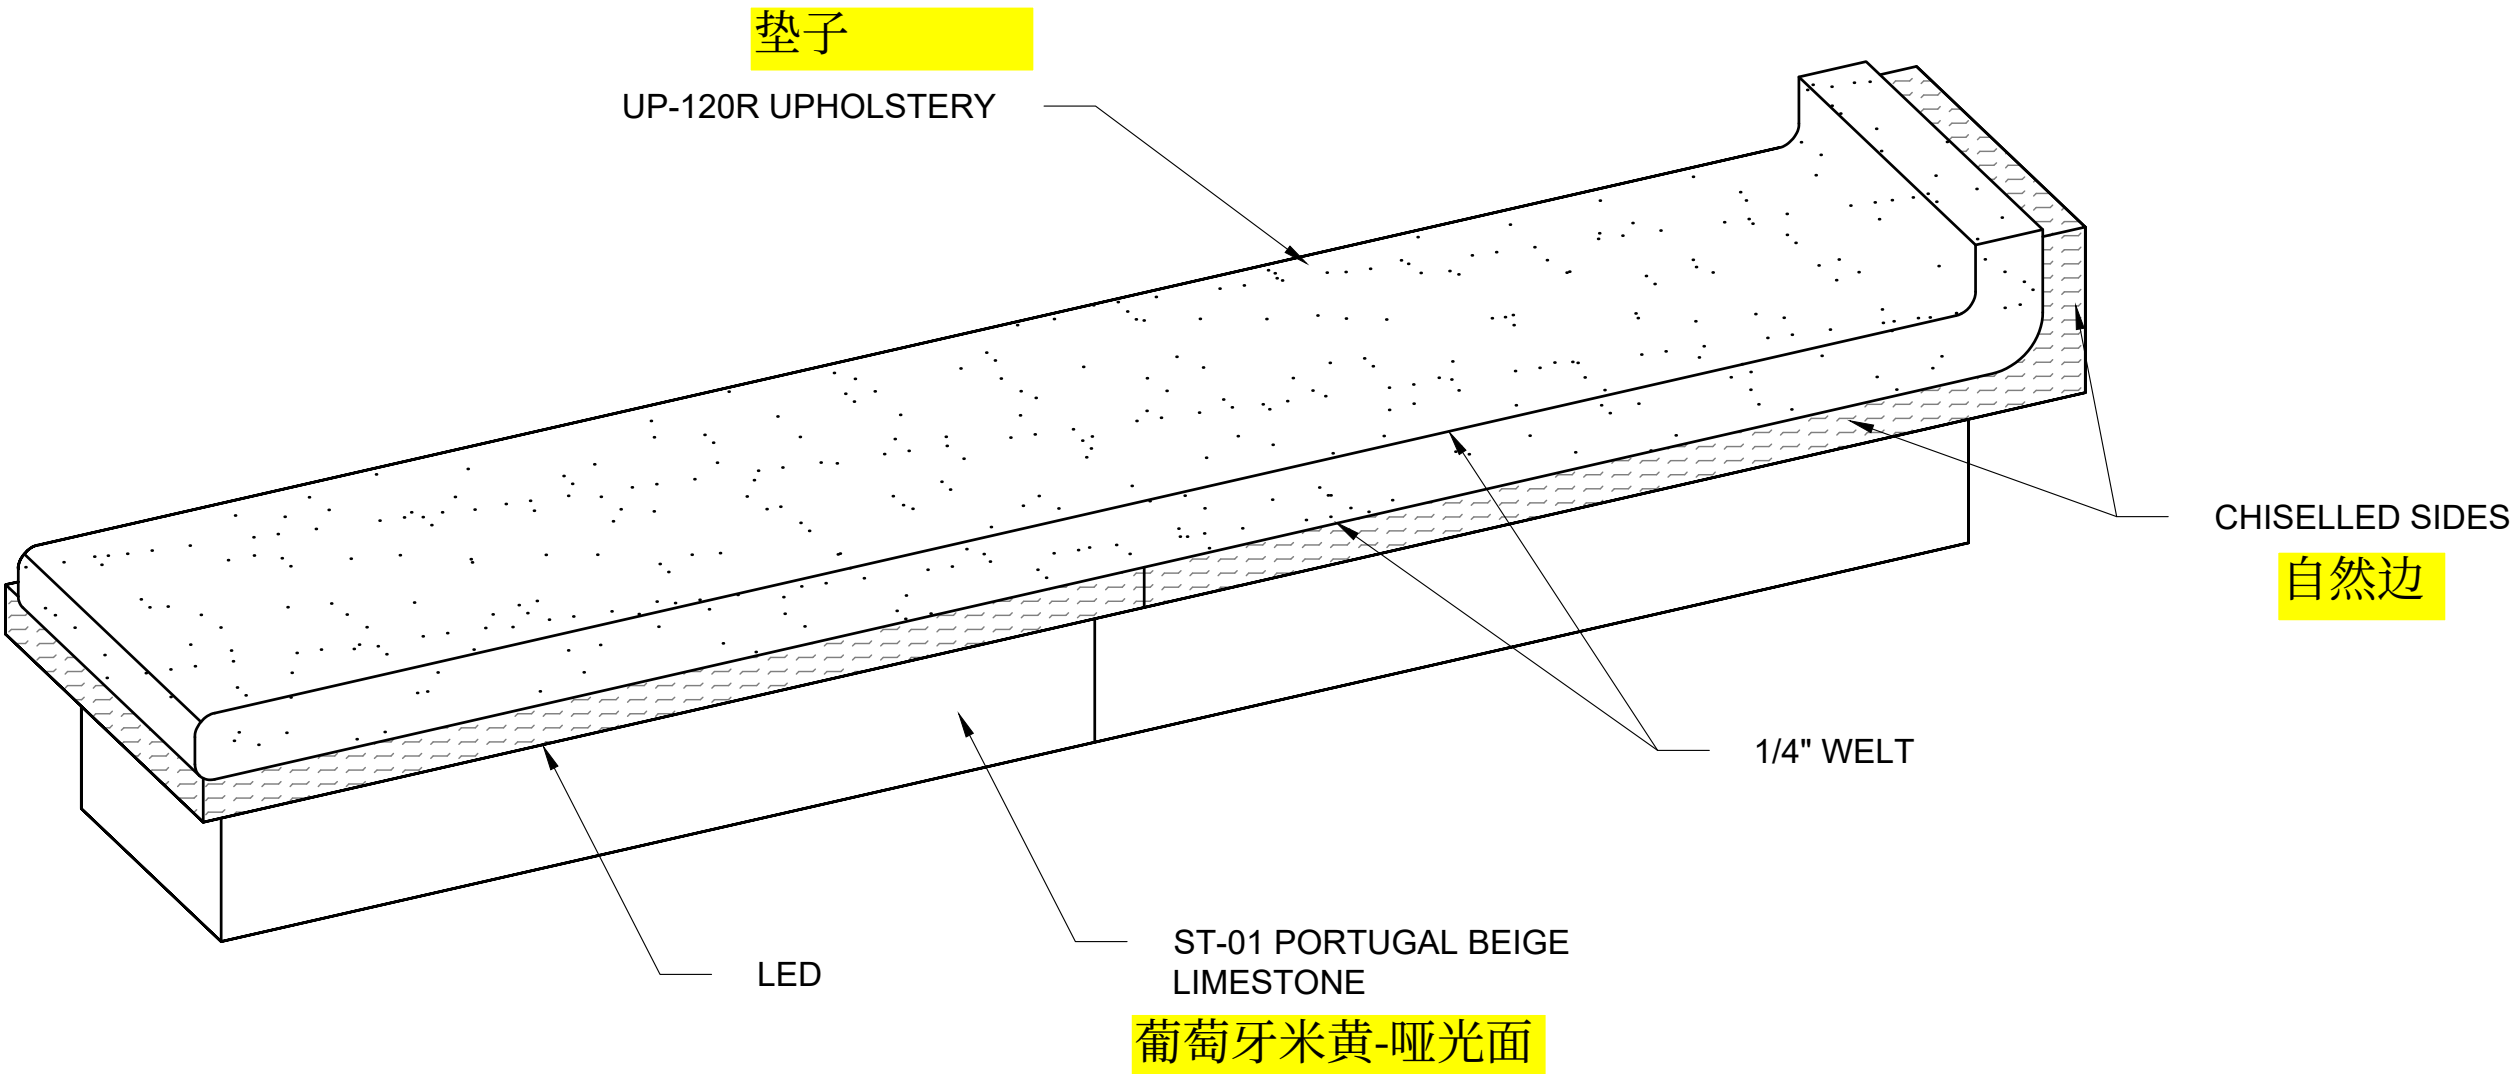


Reviewed No Exceptions Noted ()
Reviewed Exceptions Noted (X)
Revise and Resubmit ()
Rejected ()

By **XAVIER ESCRIBU** Date **6/30/2025**


ISSUED FOR:	DATE:	BY:
DATE ISSUED	06/25/2025	MK

PROJECT TITLE:
WALLER CREEK
ITEM NUMBER:
GR-IF-120R
DESCRIPTION:
BENCH
SPECIFICATIONS:
MATERIAL: ST-01: PORTUGAL BEIGE LIMESTONE UP-120R: UPHOLSTERY
FINISH: STONE: HONED SURFACE CHISELLED SURFACE ALL SURFACES: MATTE PROTECTIVE SEALANT
NOTES:
JOB NO: 320C
DRAWN BY: MK/YA
DATE DRAWN: 6/25/2025
SCALE: AS NOTED
SHEET:


TOP VIEW
俯视图

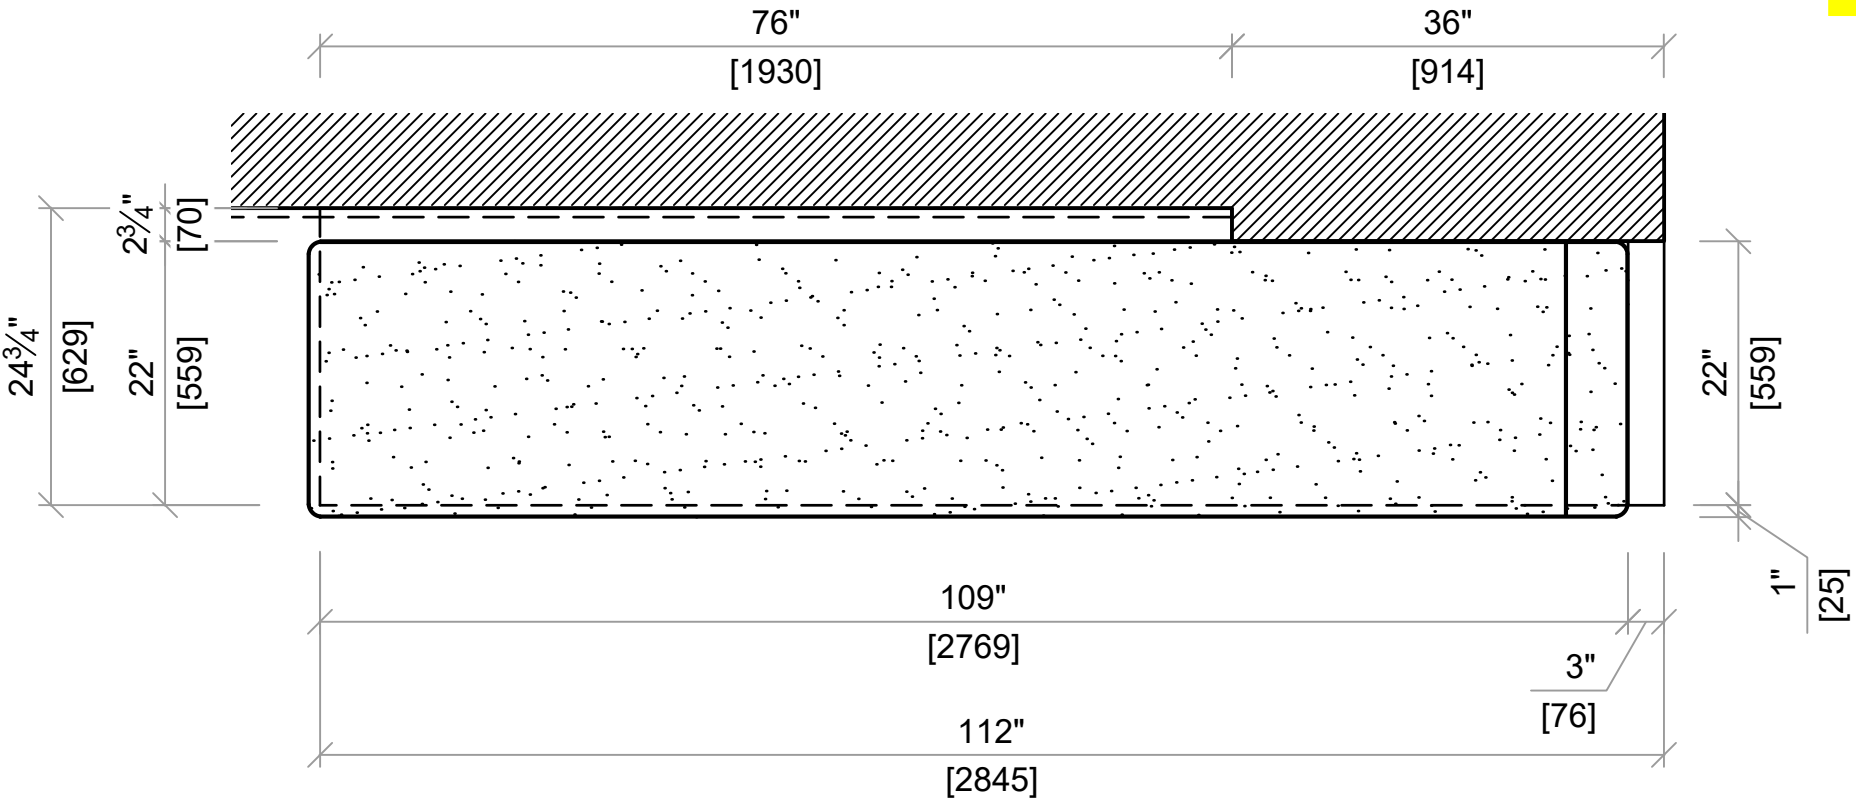


SIDE ELEVATION
侧面图

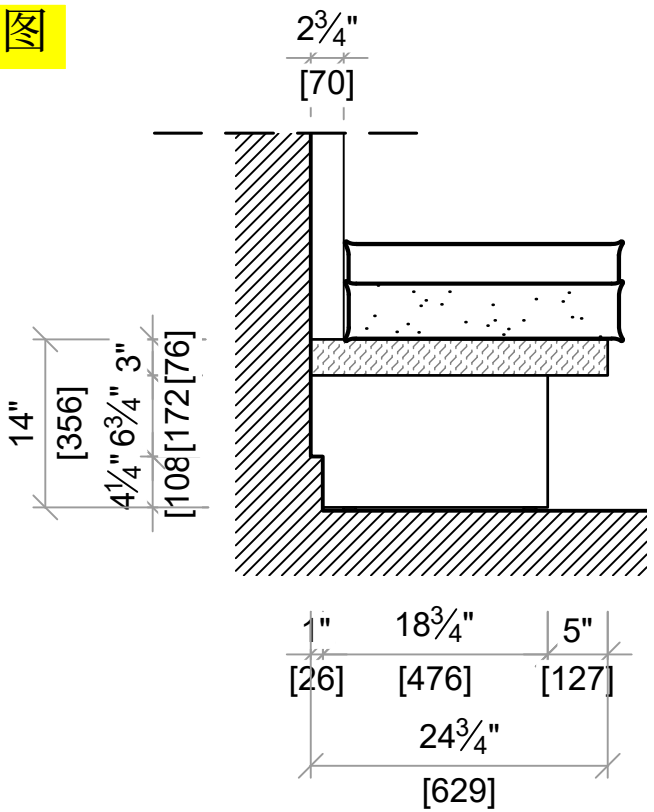

FRONT ELEVATION
正面图

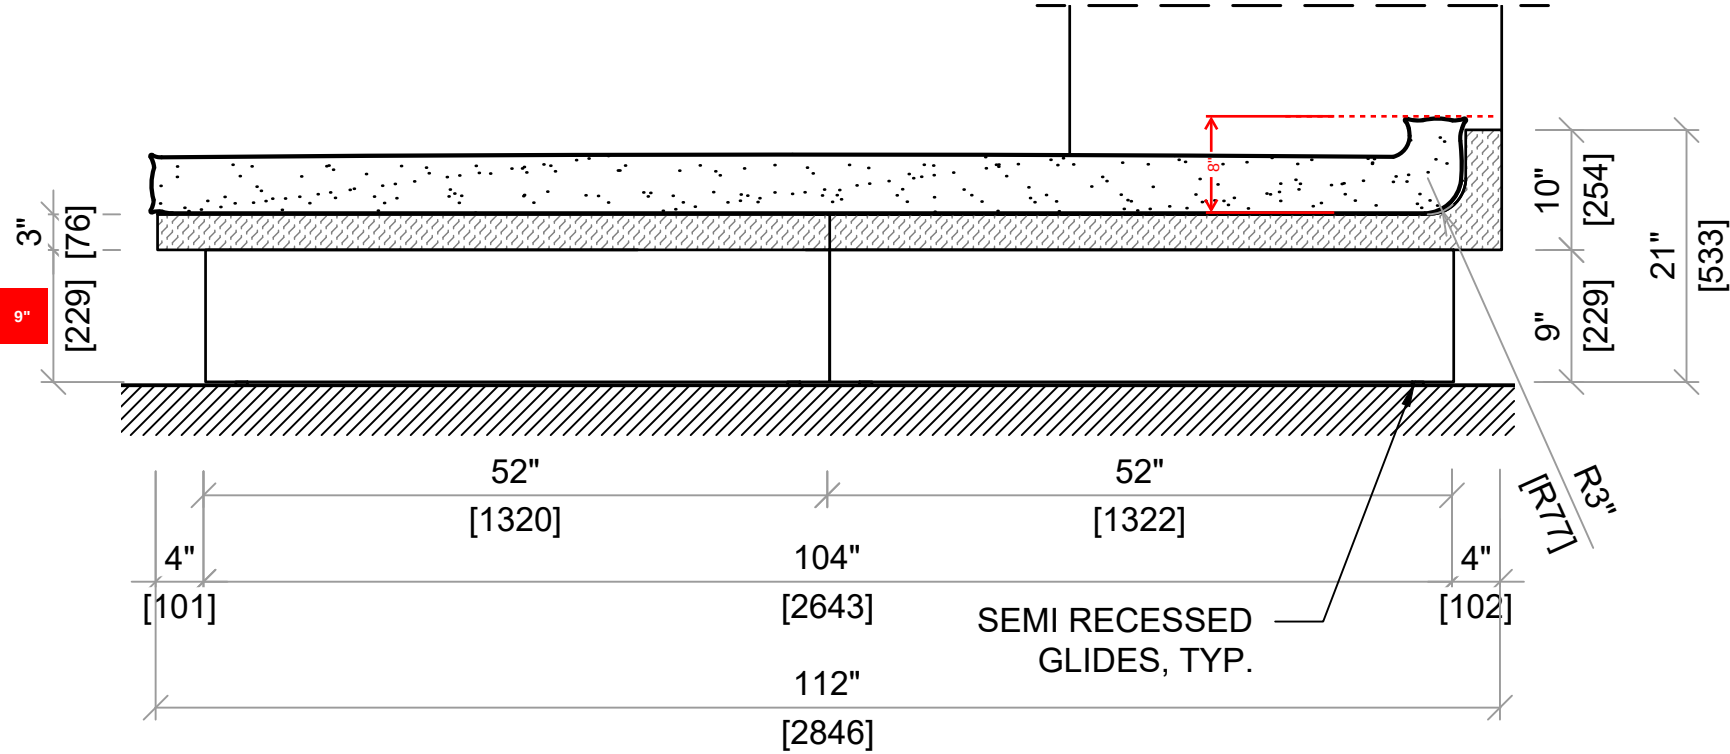

侧面图

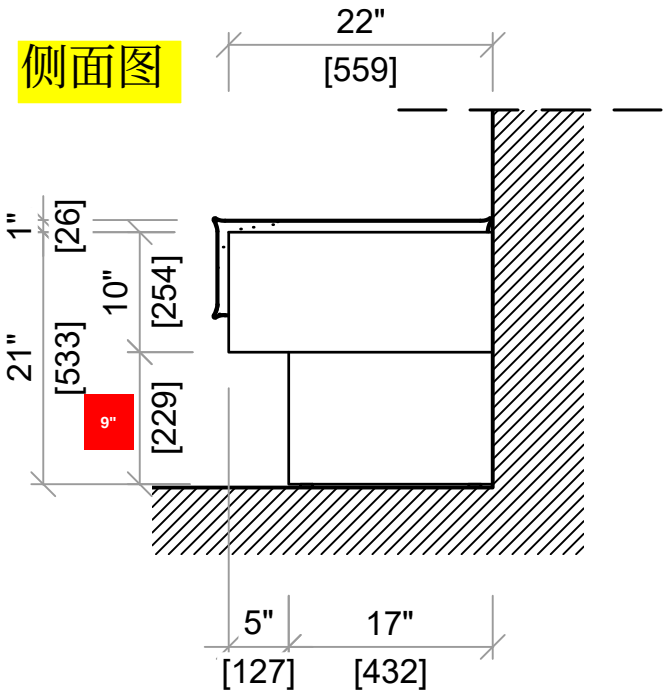

SCALE 3/4" = 1' 0"

ISSUED FOR:	DATE:	BY:
DATE ISSUED	06/25/2025	MK

PROJECT TITLE:
WALLER CREEK

ITEM NUMBER:
GR-IF-120R

DESCRIPTION:
BENCH

SPECIFICATIONS:
MATERIAL:
ST-01: PORTUGAL BEIGE LIMESTONE
UP-120R: UPHOLSTERY


FINISH:
STONE: HONED SURFACE
CHISELLED SURFACE ALL SURFACES:
MATTE PROTECTIVE SEALANT

NOTES:

JOB NO:	320C
DRAWN BY:	MK/YA
DATE DRAWN:	6/25/2025
SCALE:	AS NOTED
SHEET:	


PLAN VIEW

平面剖面图

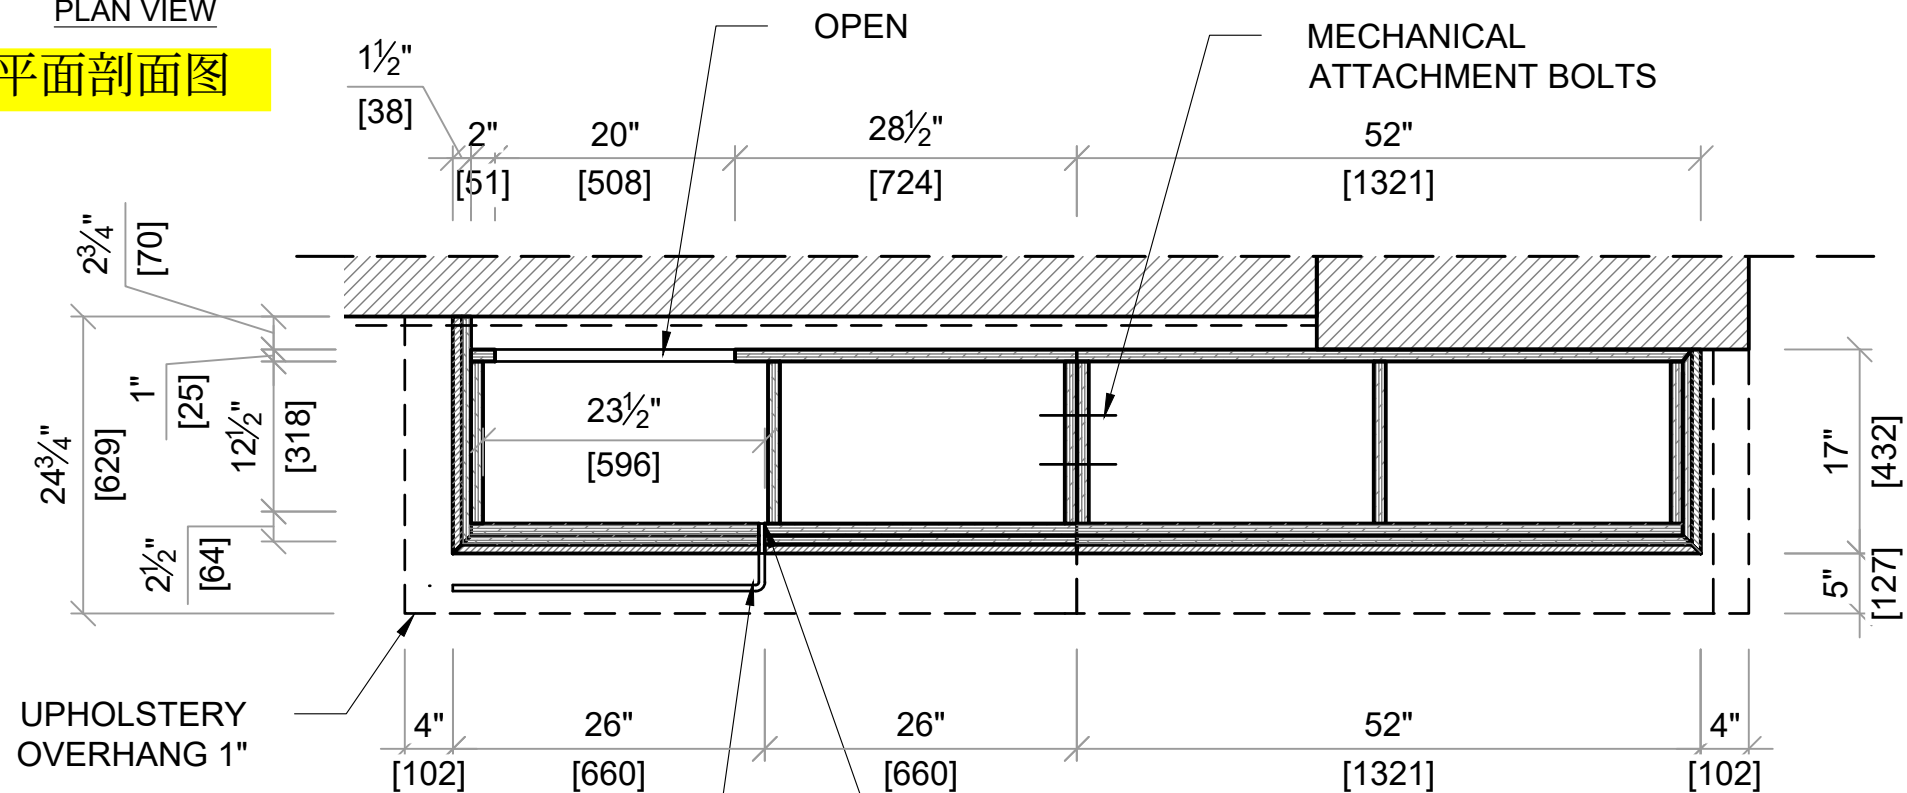

SECTION A

立面剖面图A

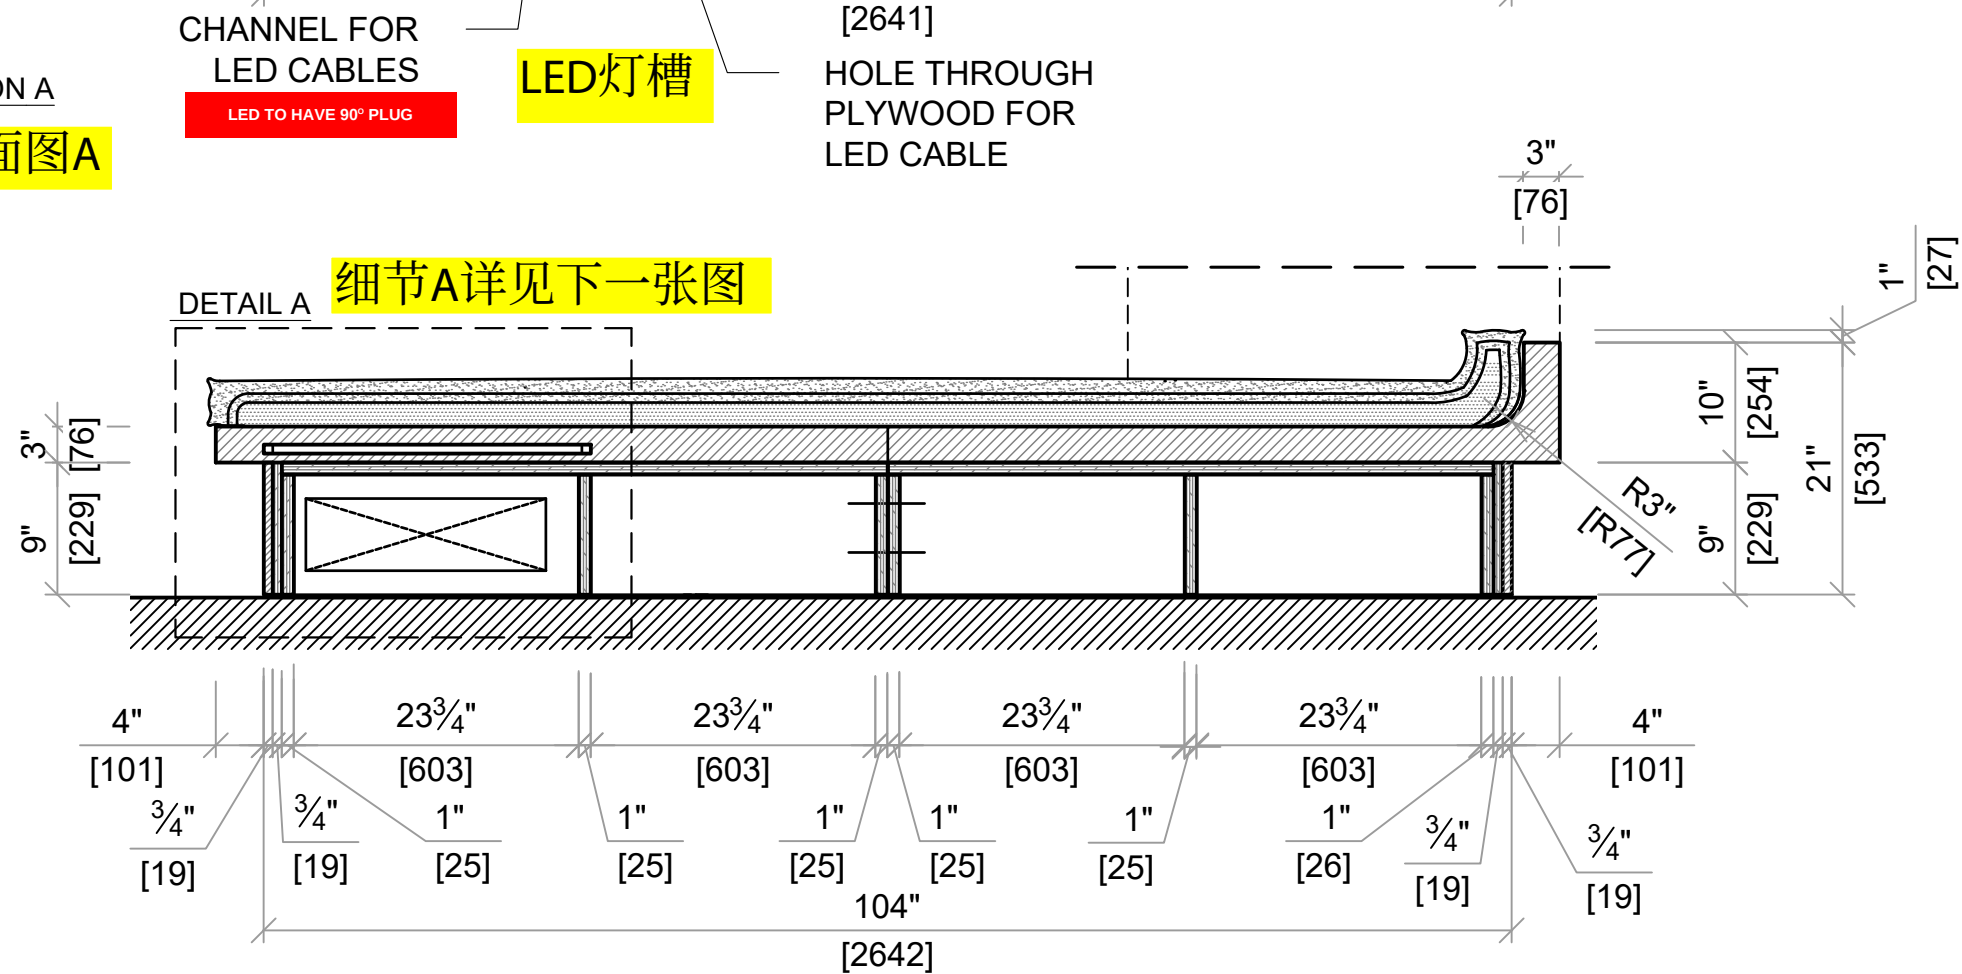

SCALE 3/4" = 1' 0"

ISSUED FOR:	DATE:	BY:
DATE ISSUED	06/25/2025	MK

PROJECT TITLE:

WALLER CREEK

ITEM NUMBER:

GR-IF-120R

DESCRIPTION:

BENCH

SPECIFICATIONS:

MATERIAL:
ST-01: PORTUGAL BEIGE LIMESTONE
UP-120R: UPHOLSTERY


FINISH:
STONE: HONED SURFACE
CHISELLED SURFACE ALL SURFACES:
MATTE PROTECTIVE SEALANT

NOTES:

JOB NO:	320C
DRAWN BY:	MK/YA
DATE DRAWN:	6/25/2025
SCALE:	AS NOTED
SHEET:	

03

细节A

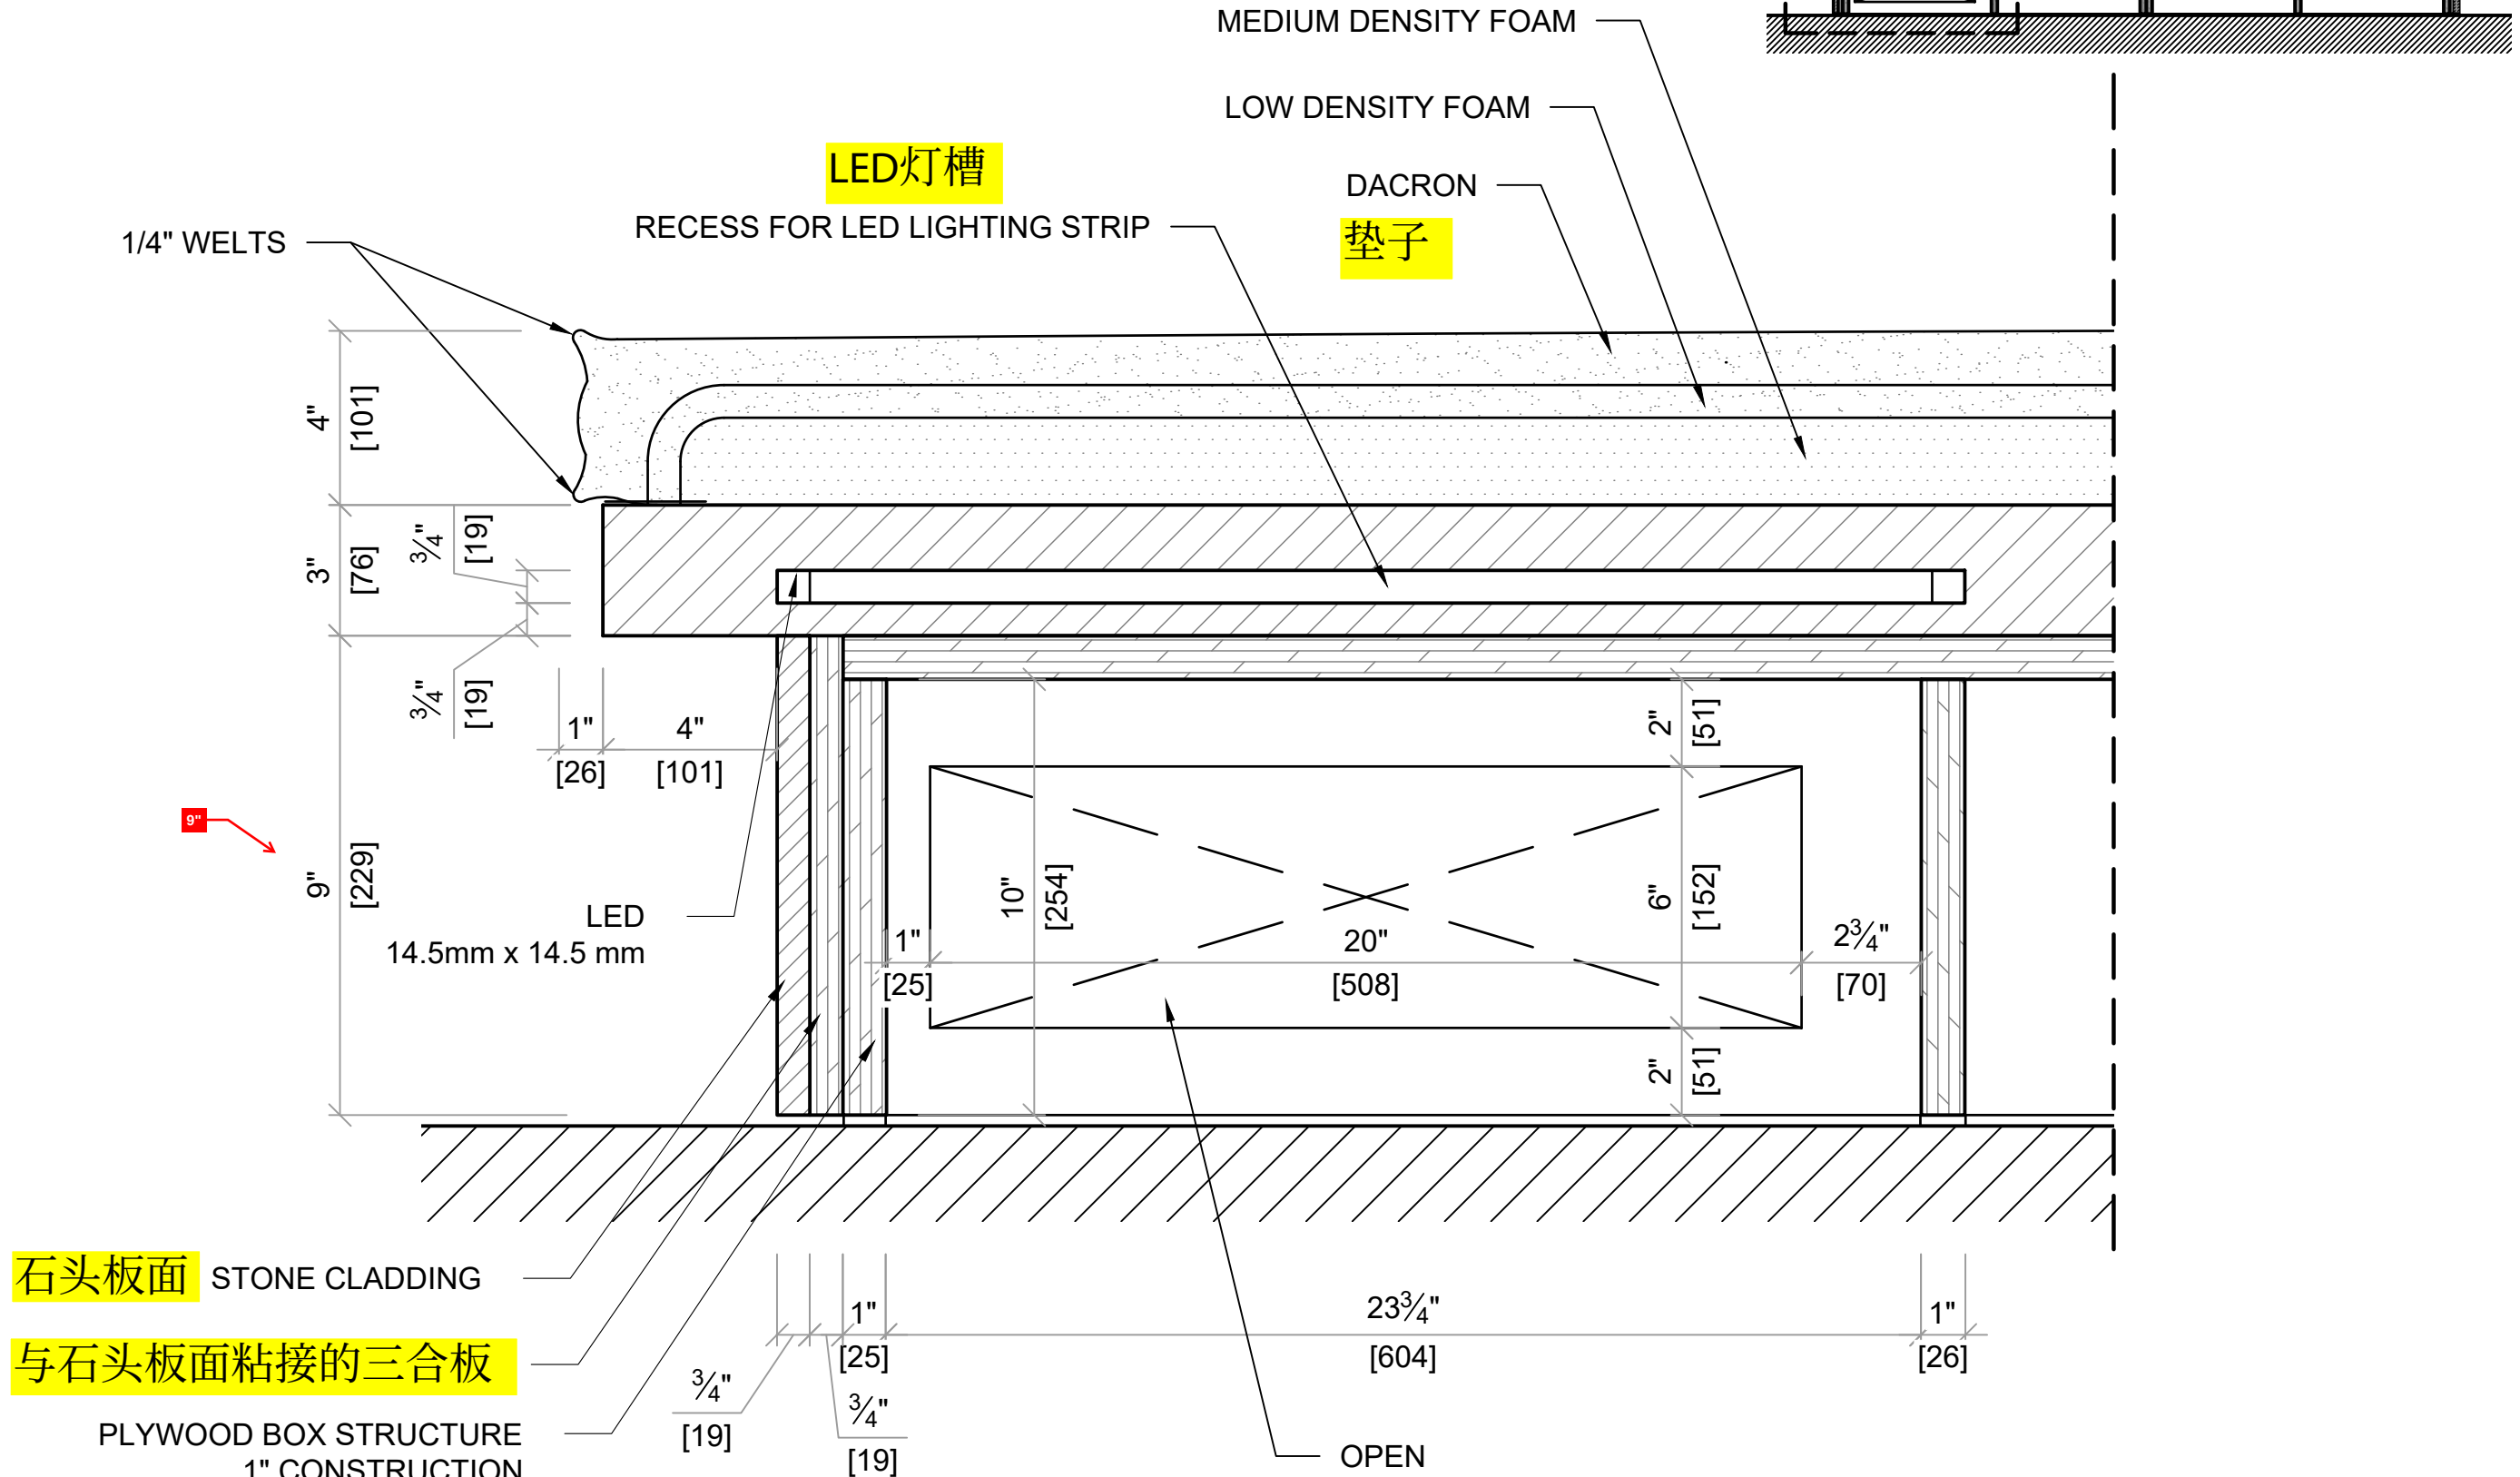

SCALE 3" = 1' 0"

ISSUED FOR:	DATE:	BY:
DATE ISSUED	06/25/2025	MK

PROJECT TITLE:
WALLER CREEK

ITEM NUMBER:
GR-IF-120R

DESCRIPTION:
BENCH


SPECIFICATIONS:
MATERIAL:
ST-01: PORTUGAL BEIGE LIMESTONE
UP-120R: UPHOLSTERY
FINISH:
STONE: HONED SURFACE
CHISELLED SURFACE ALL SURFACES:
MATTE PROTECTIVE SEALANT

NOTES:

JOB NO:	320C
DRAWN BY:	MK/YA
DATE DRAWN:	6/25/2025
SCALE:	AS NOTED
SHEET:	

SECTION B

侧面剖面图B

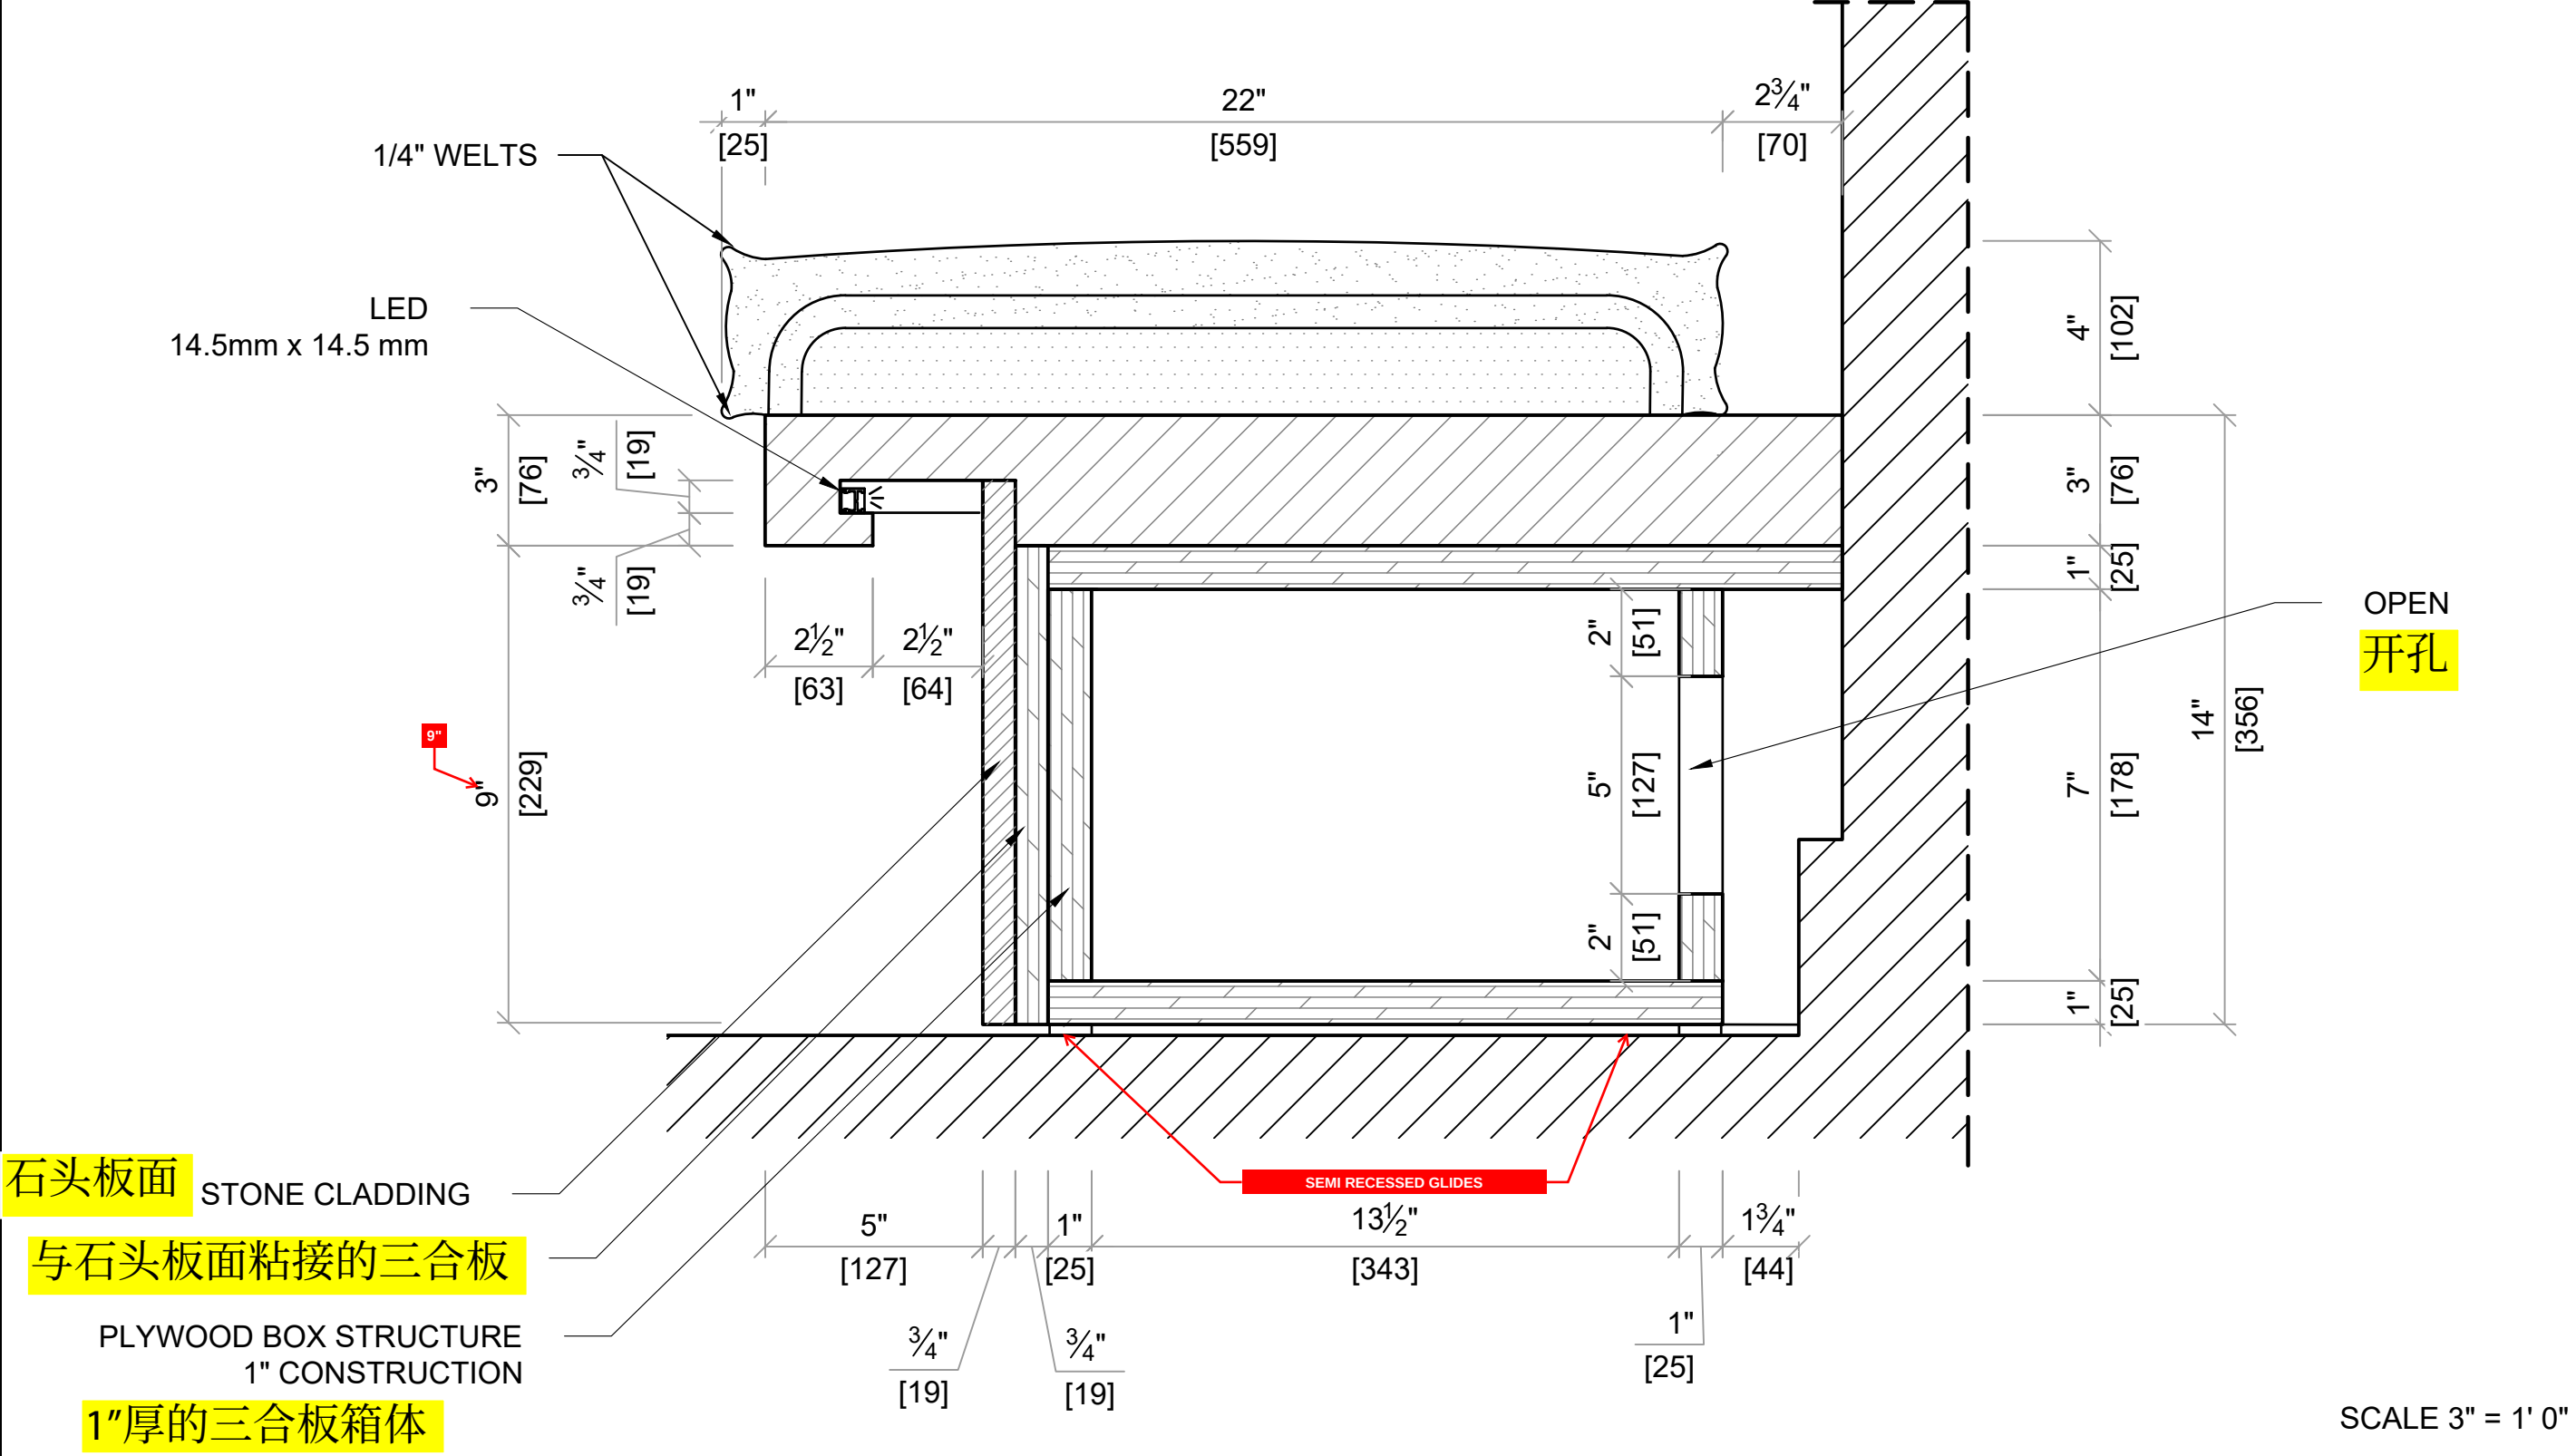

ISSUED FOR:	DATE:	BY:
DATE ISSUED	06/25/2025	MK


PROJECT TITLE:
WALLER CREEK
ITEM NUMBER:
GR-IF-120R
DESCRIPTION:
BENCH

SPECIFICATIONS:
MATERIAL:
ST-01: PORTUGAL BEIGE LIMESTONE
UP-120R: UPHOLSTERY
FINISH:
STONE: HONED SURFACE
CHISELLED SURFACE ALL SURFACES:
MATTE PROTECTIVE SEALANT

NOTES:

JOB NO:	320C
DRAWN BY:	MK/YA
DATE DRAWN:	6/25/2025
SCALE:	AS NOTED
SHEET:	

侧面剖面图C

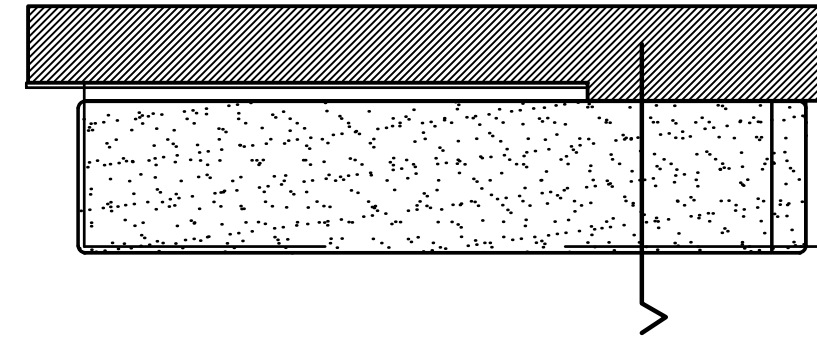

ISSUED FOR:	DATE:	BY:
DATE ISSUED	06/25/2025	MK

WALLER CREEK

GR-IF-120R

BENCH

MATERIAL:
ST-01: PORTUGAL BEIGE LIMESTONE
UP-120R: UPHOLSTERY

FINISH:
STONE: HONED SURFACE
CHISELLED SURFACE ALL SURFACES:
MATTE PROTECTIVE SEALANT

NOTES:

JOB NO: 320C

DRAWN BY: MK/YA

DATE DRAWN: 6/25/2025

SCALE: AS NOTED


SHEET: _____

06

SCALE 3" = 1' 0"

GENERAL NOTE
STUDY HEIGHT OF BENCH WITH TABLE AND CHAIR

GR - IF - 120L
石头：葡萄牙米黄
加工：哑光面+自然边
数量：32套

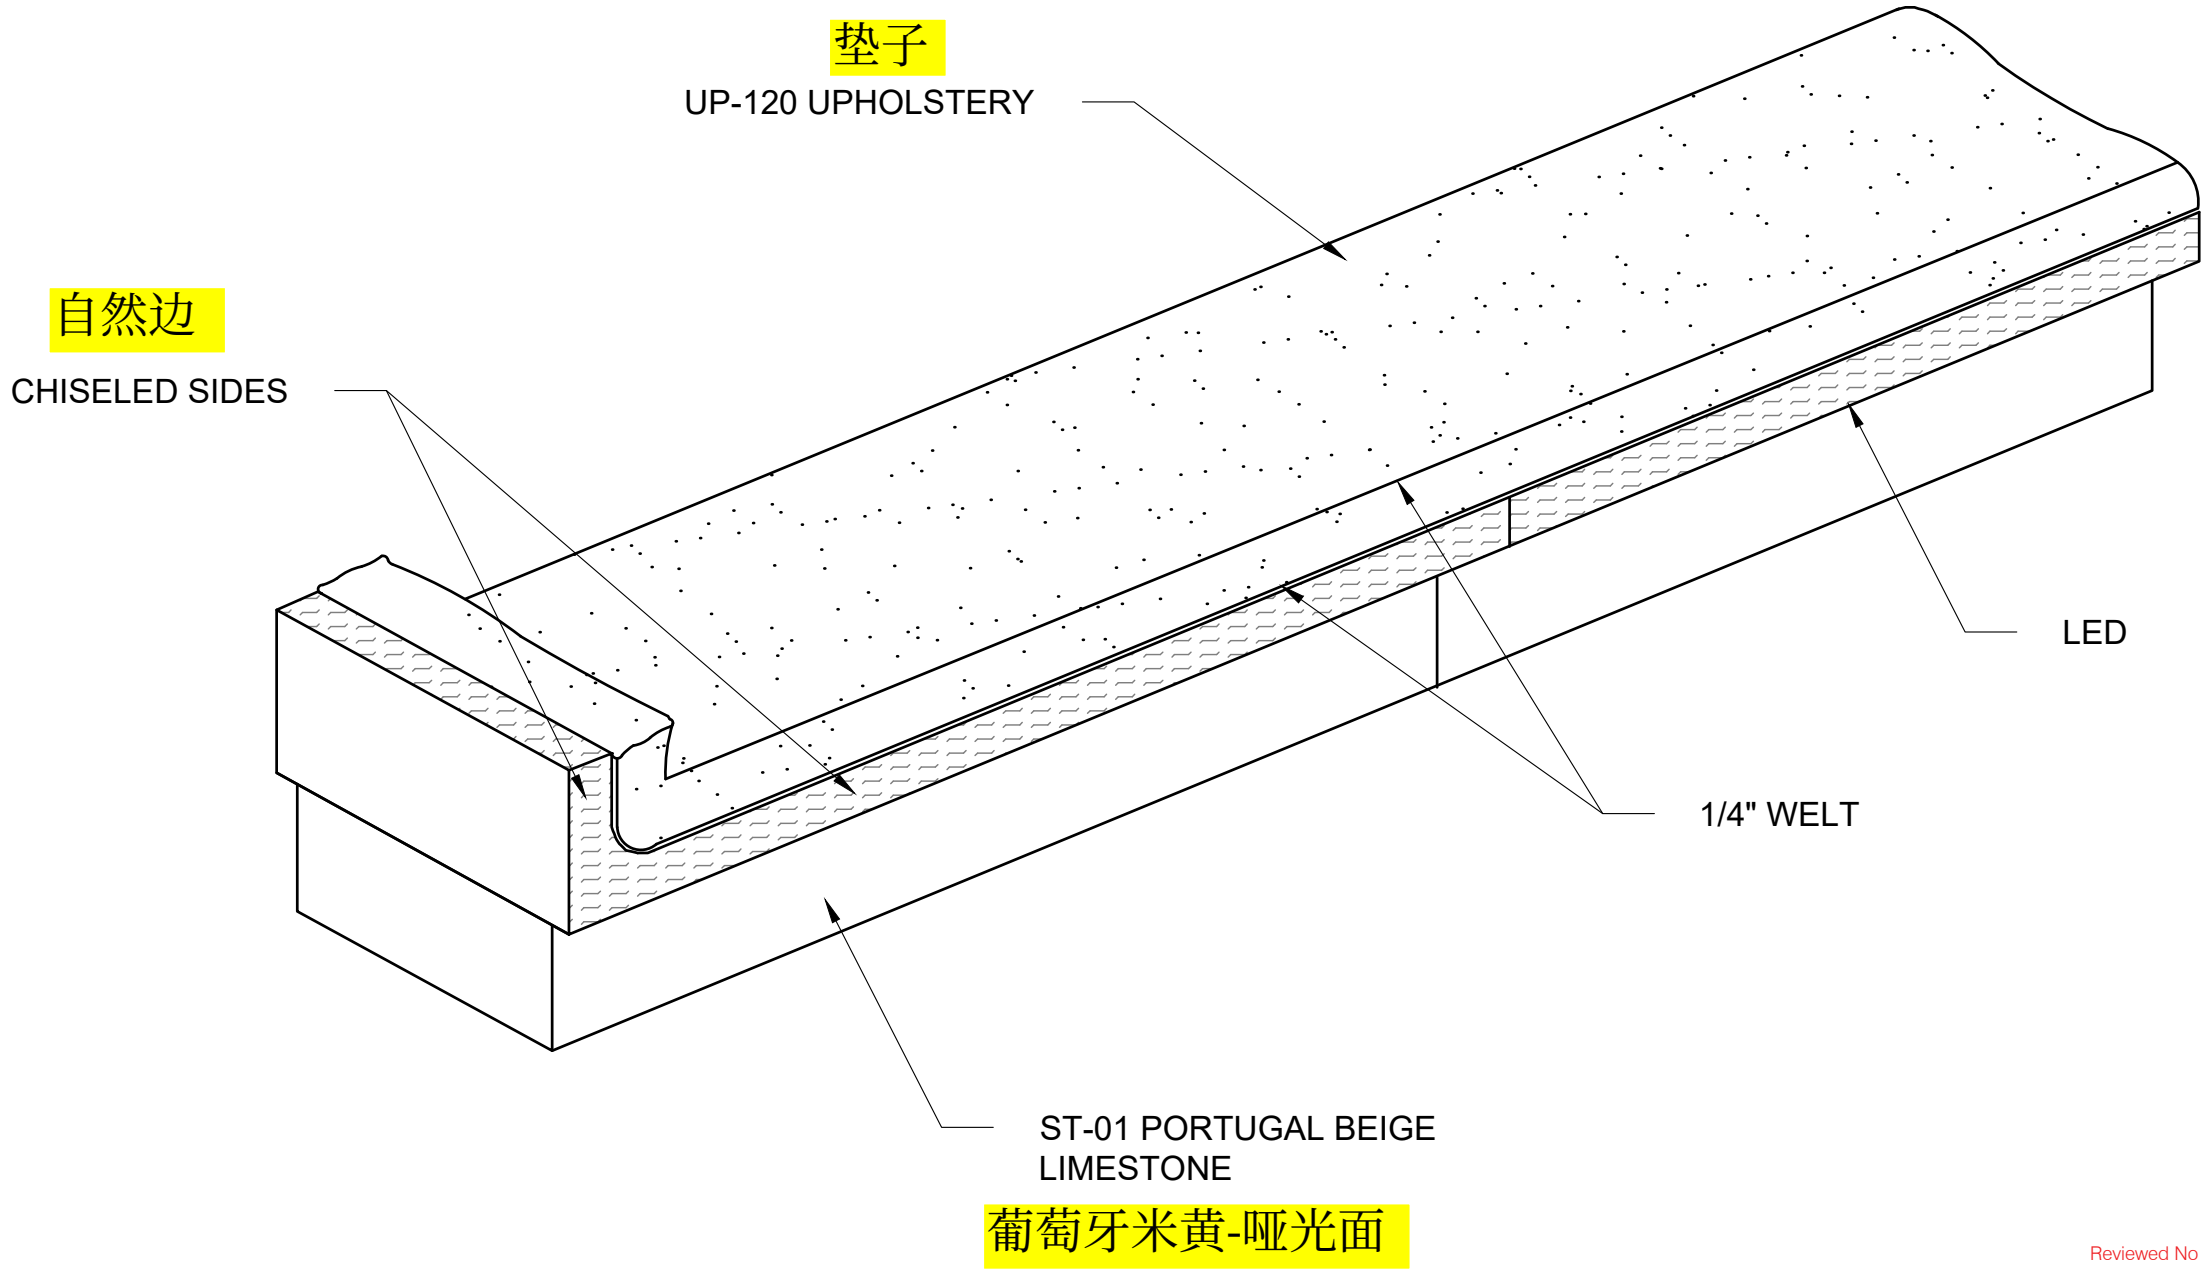


Reviewed No Exceptions Noted ()
Reviewed Exceptions Noted (X)
Revise and Resubmit ()
Rejected ()

By **XAVIER ESCRIBU** Date **6/30/2025**

ISSUED FOR:	DATE:	BY:
DATE ISSUED	06/24/2025	MK

PROJECT TITLE:
WALLER CREEK
ITEM NUMBER:
GR-IF-120L
DESCRIPTION:
BENCH
SPECIFICATIONS:
MATERIAL: ST-01: PORTUGAL BEIGE LIMESTONE UP-120: UPHOLSTERY
FINISH: STONE: HONED SURFACE CHISELED SURFACE ALL SURFACES: MATTE PROTECTIVE SEALANT
NOTES:
JOB NO:
320C
DRAWN BY:
MK/YA/BD
DATE DRAWN:
6/25/2025
SCALE:
AS NOTED
SHEET:

俯视图

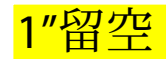


02


JOB NO:	320C
DRAWN BY:	MK/YA/BD
DATE DRAWN:	6/25/2025
SCALE:	AS NOTED

SHEET:


PLAN VIEW
平面剖面图

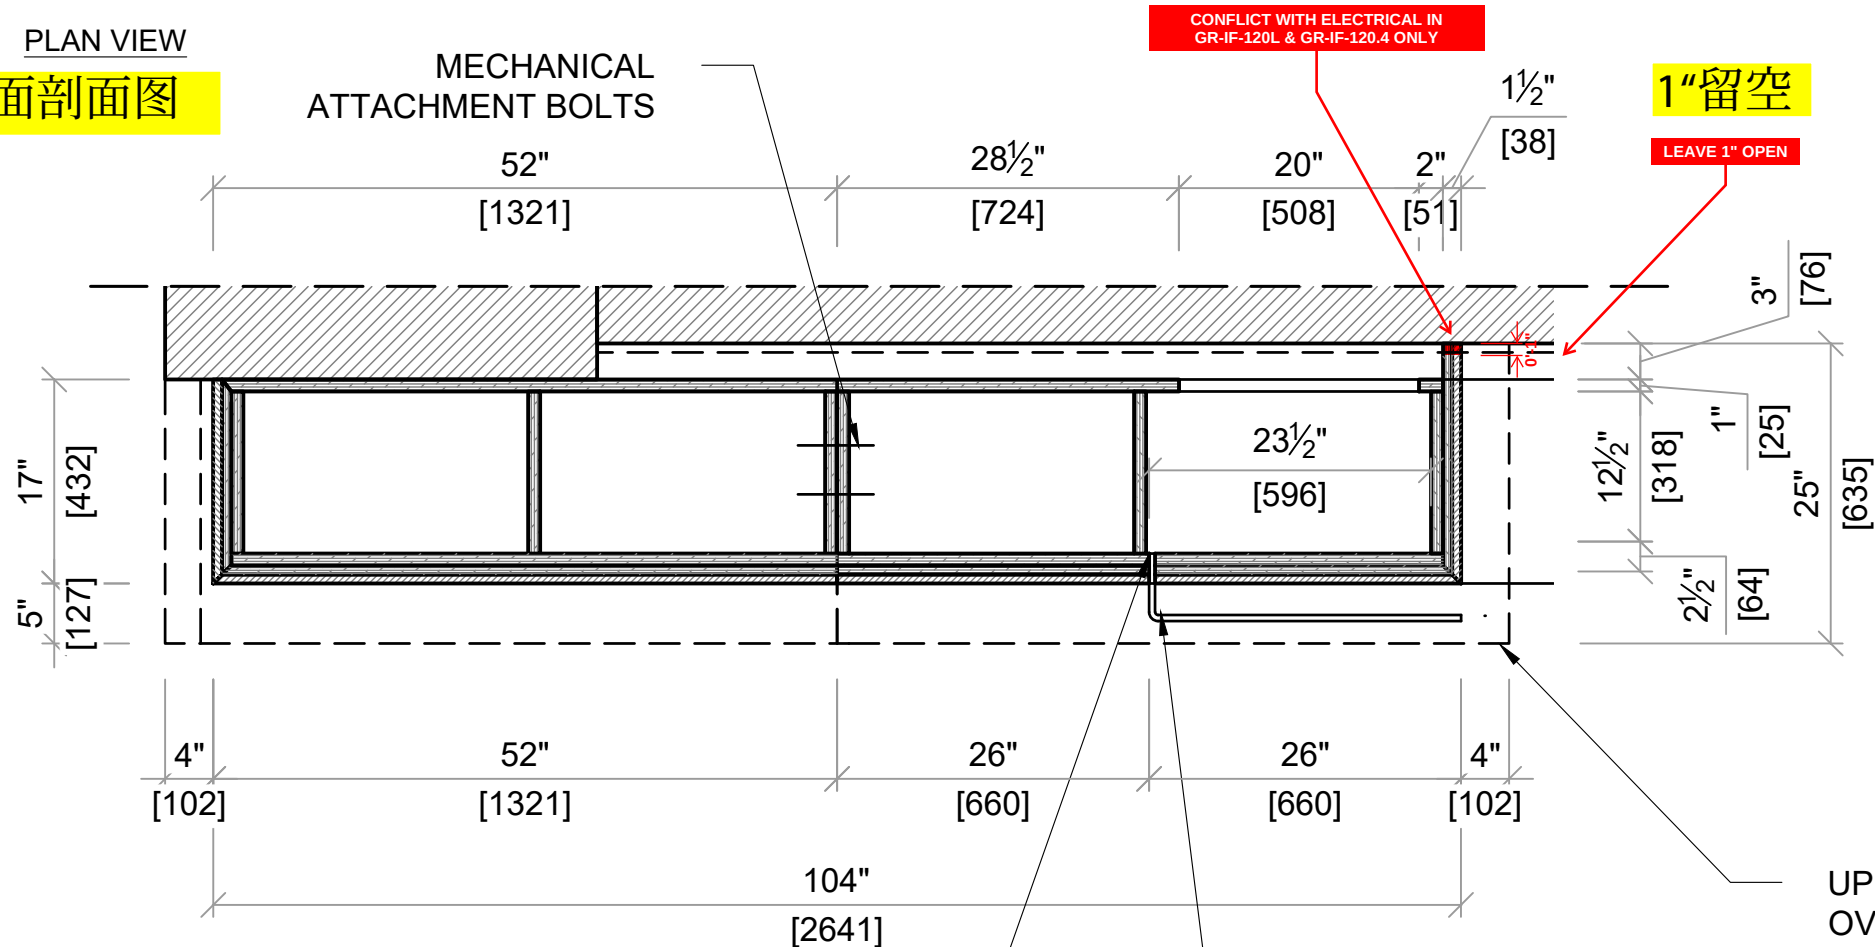

SECTION A
侧面剖面图A

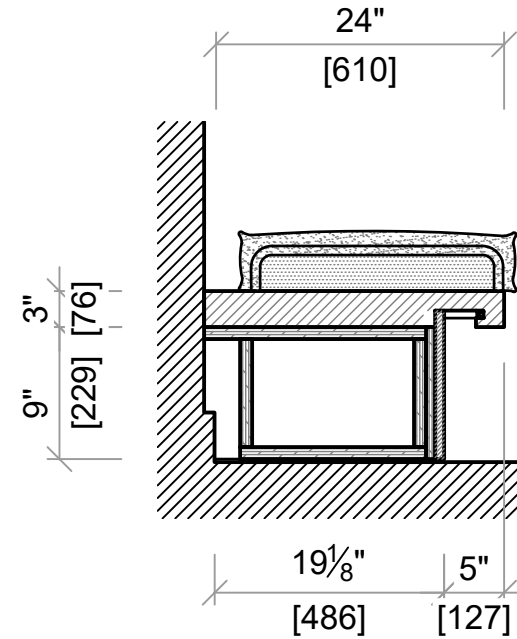

SECTION B
正面剖面图B

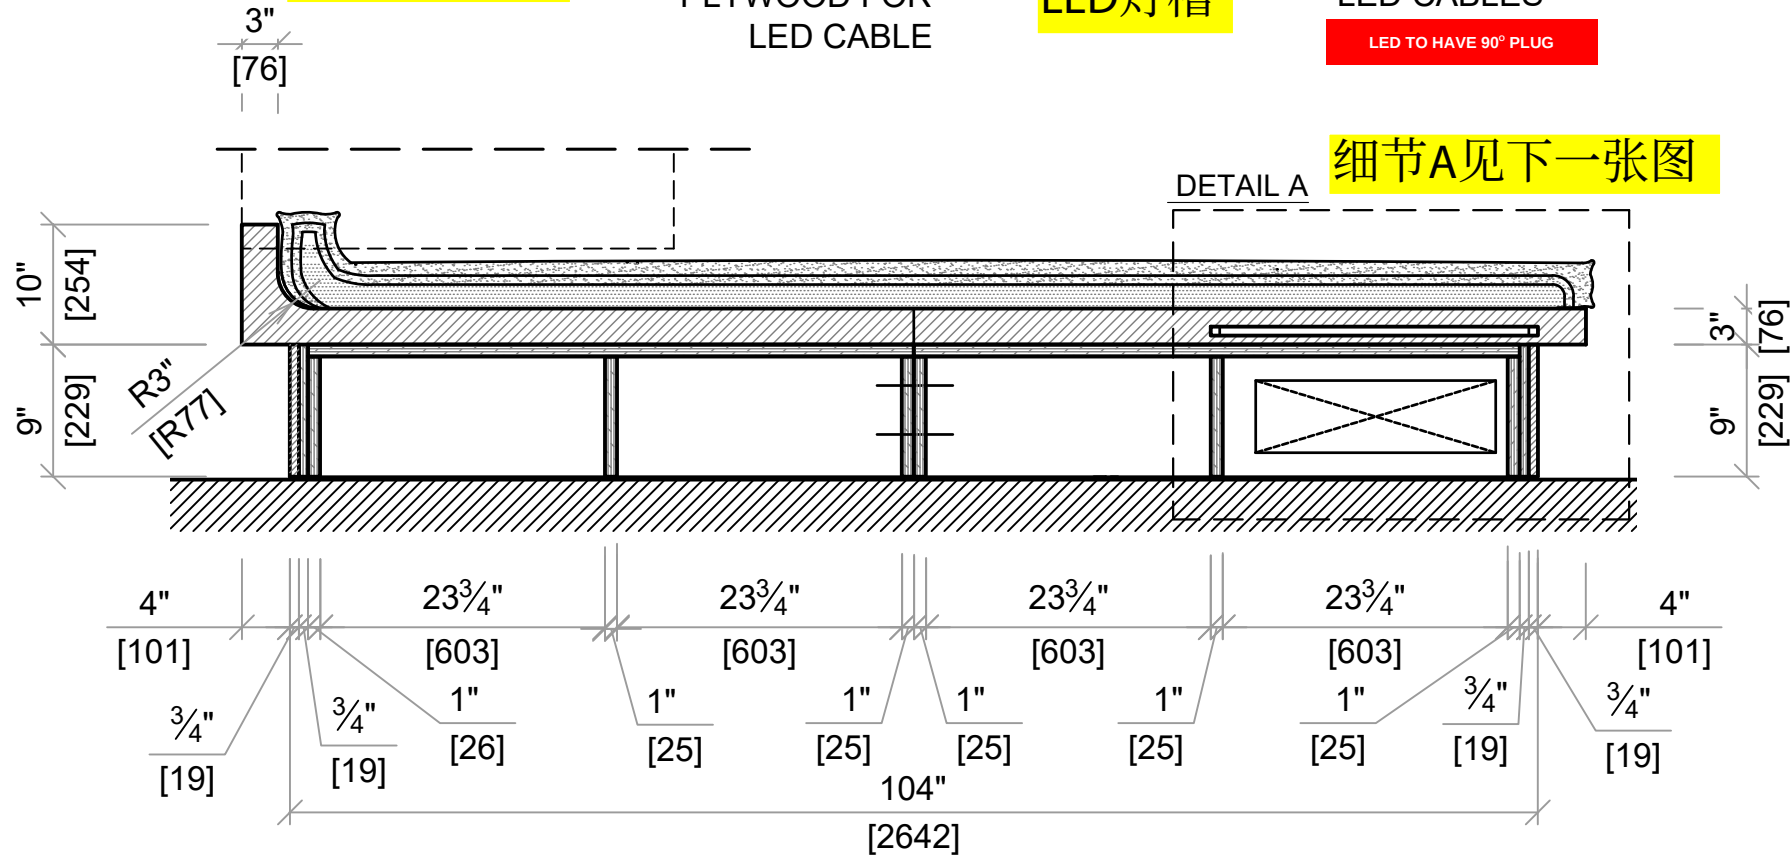


SCALE 3/4" = 1' 0"

ISSUED FOR:	DATE:	BY:
DATE ISSUED	06/24/2025	MK

PROJECT TITLE:
WALLER CREEK
ITEM NUMBER:
GR-IF-120L
DESCRIPTION:
BENCH

SPECIFICATIONS:
MATERIAL:
ST-01: PORTUGAL BEIGE LIMESTONE
UP-120: UPHOLSTERY
FINISH:
STONE: HONED SURFACE
CHISELLED SURFACE ALL SURFACES:
MATTE PROTECTIVE SEALANT

NOTES:
JOB NO:
320C
DRAWN BY:
MK/YA/BD
DATE DRAWN:
6/25/2025
SCALE:
AS NOTED
SHEET:

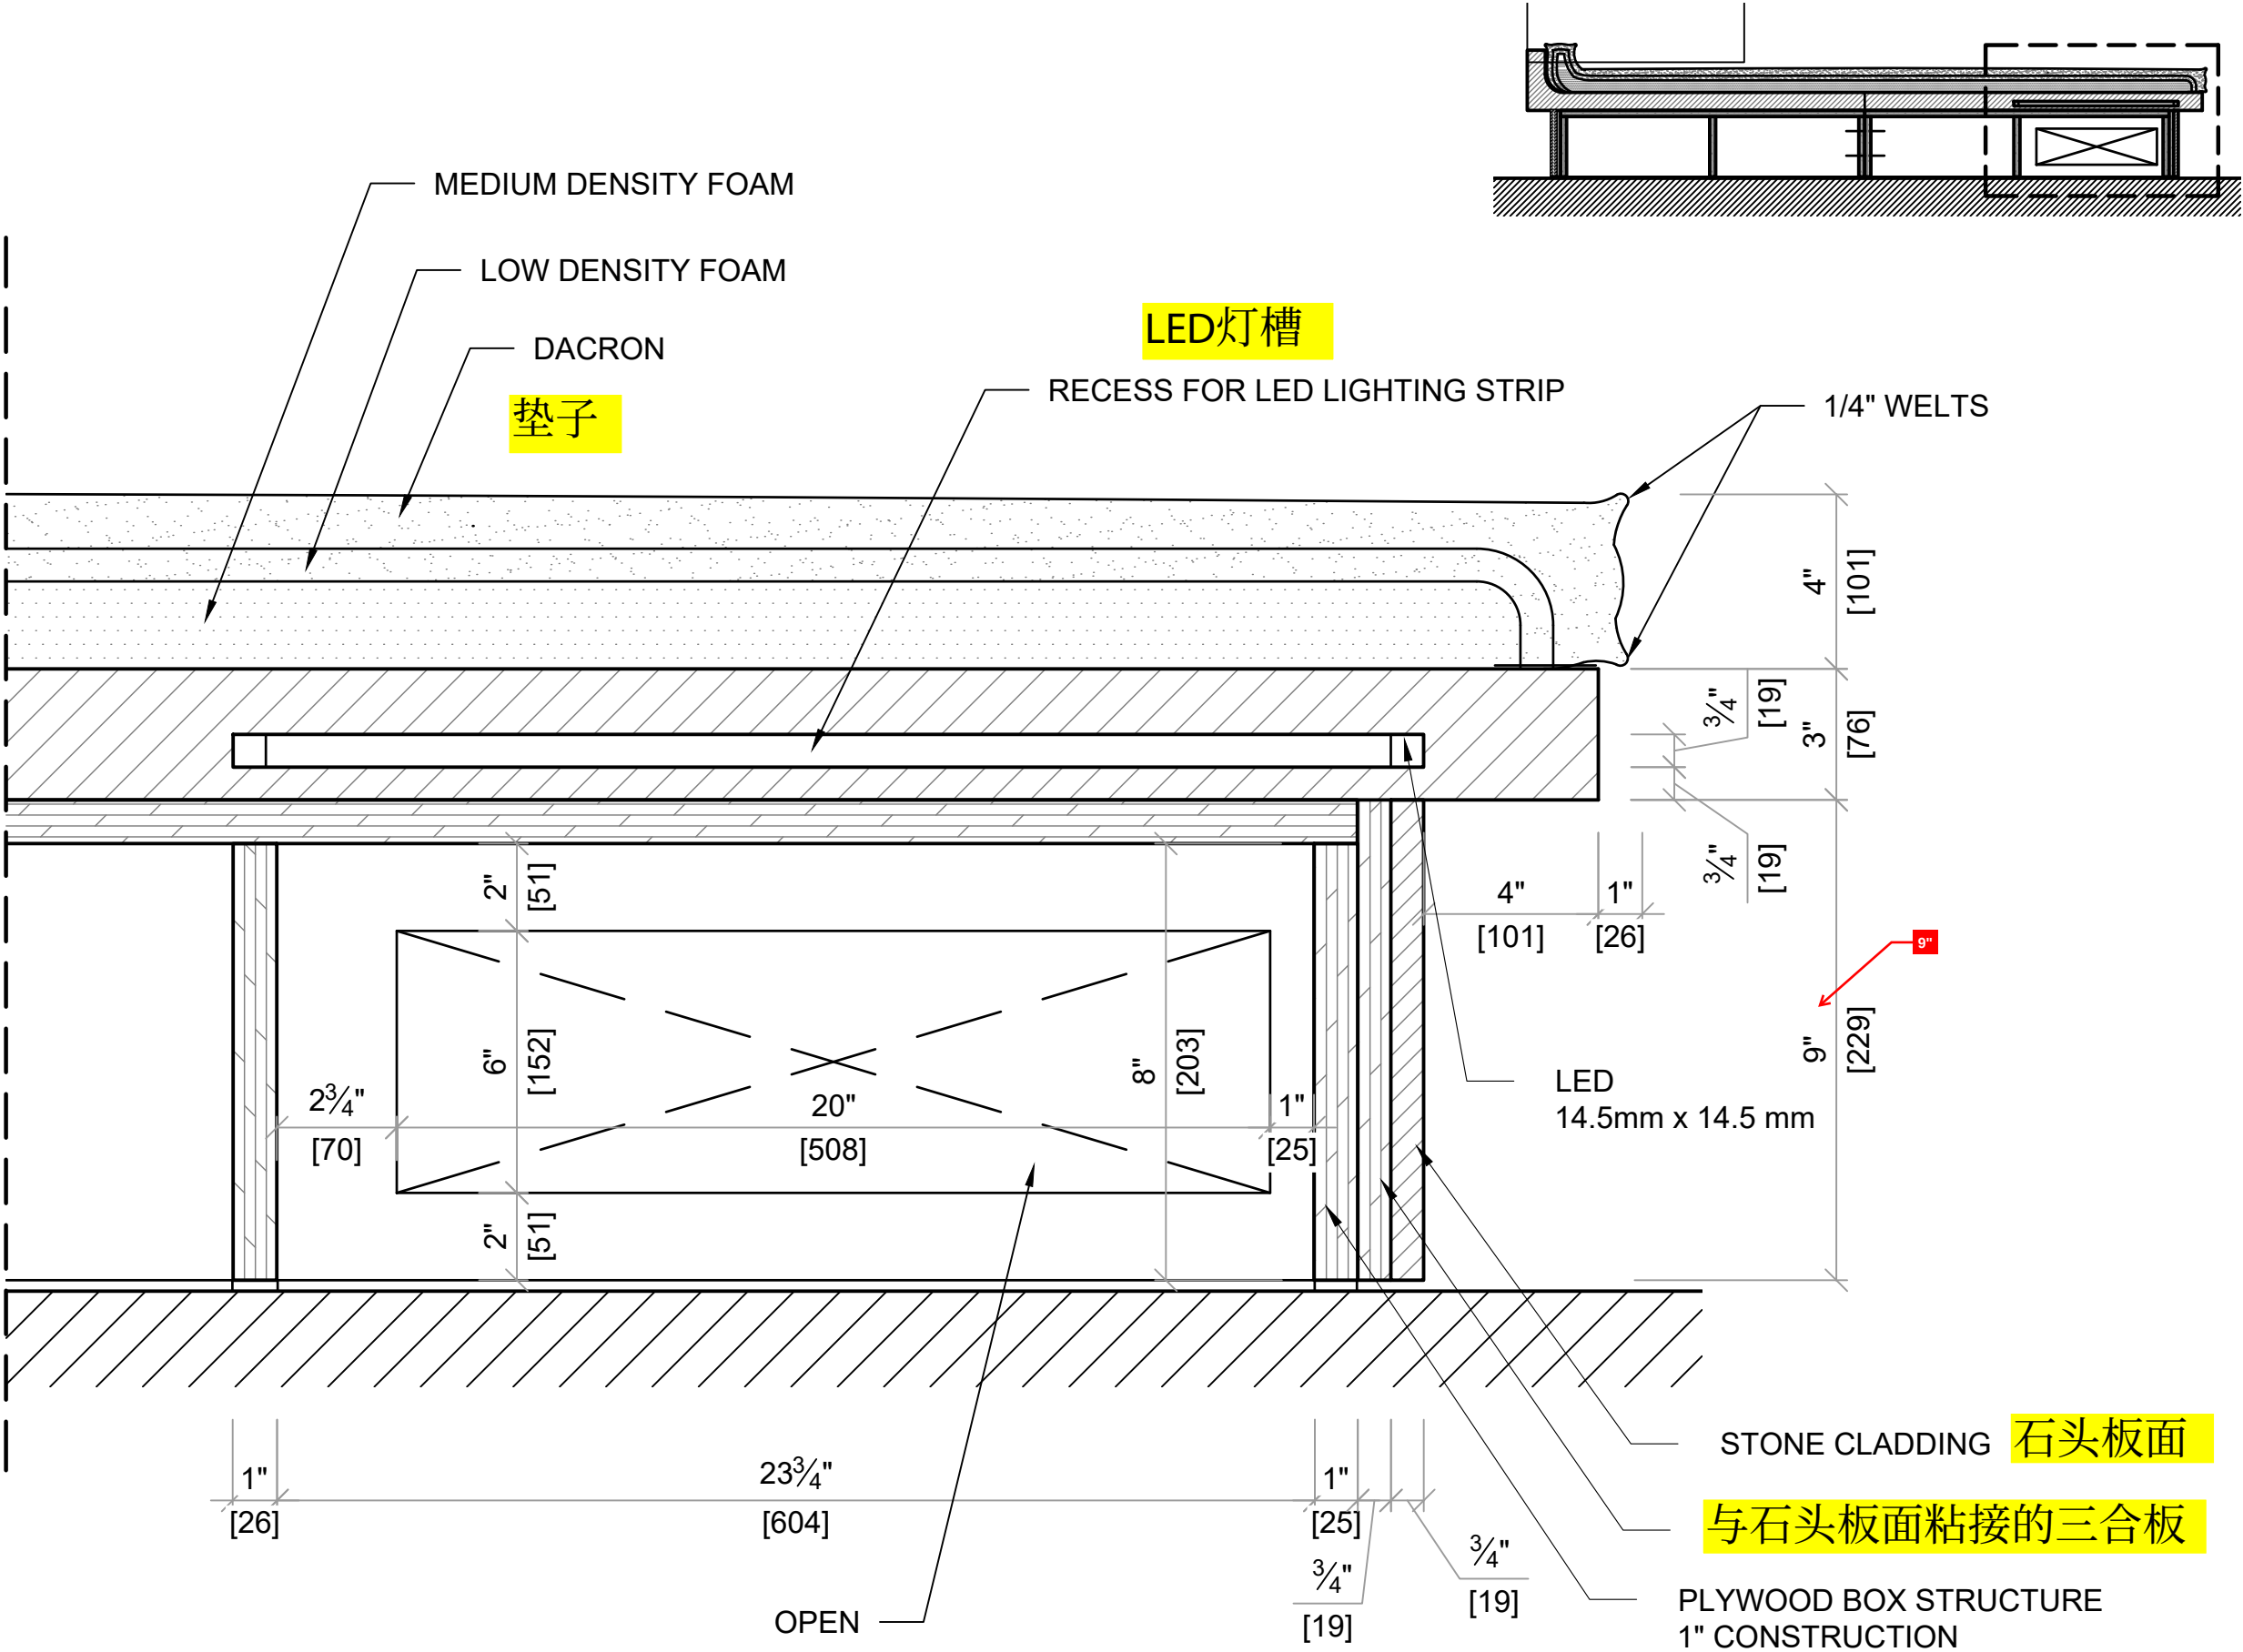

ISSUED FOR:	DATE:	BY:
DATE ISSUED	06/24/2025	MK

PROJECT TITLE:
WALLER CREEK
ITEM NUMBER:
GR-IF-120L
DESCRIPTION:
BENCH


SPECIFICATIONS:
MATERIAL:
ST-01: PORTUGAL BEIGE LIMESTONE
UP-120: UPHOLSTERY
FINISH:
STONE: HONED SURFACE
CHISELLED SURFACE ALL SURFACES:
MATTE PROTECTIVE SEALANT

NOTES:

JOB NO:	320C
DRAWN BY:	MK/YA/BD
DATE DRAWN:	6/25/2025
SCALE:	AS NOTED
SHEET:	

SECTION B

侧面剖面图B

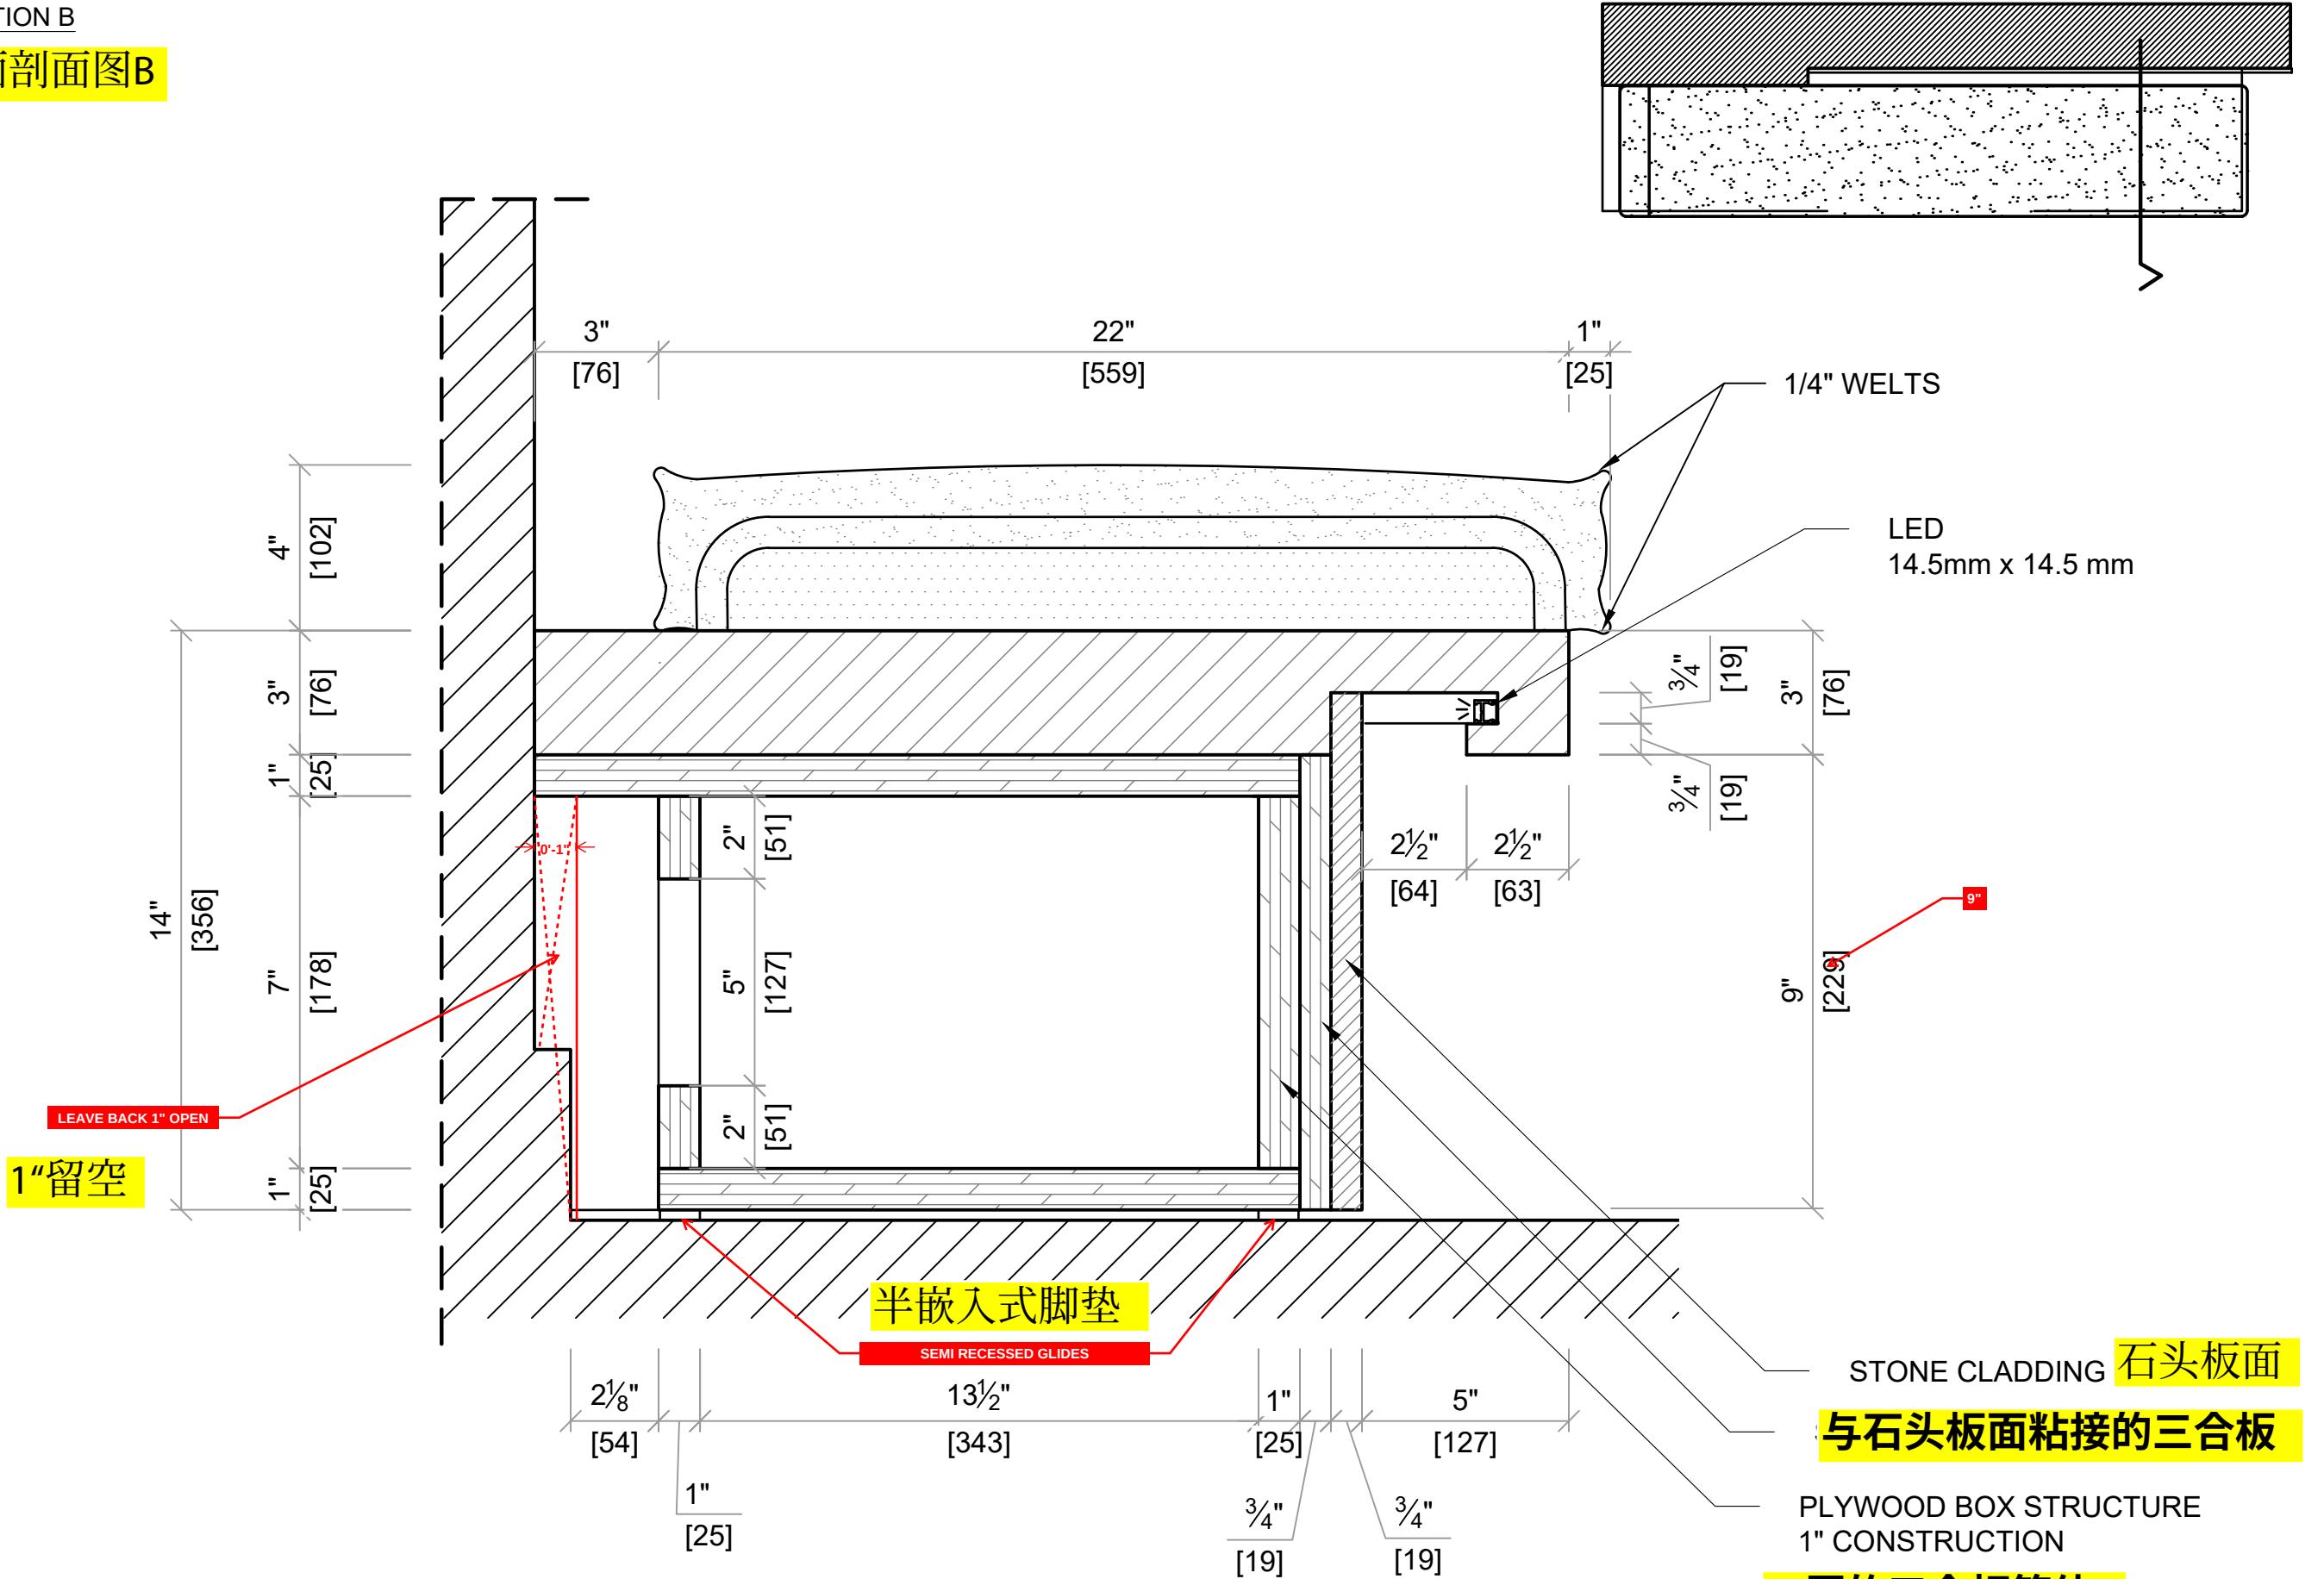


ISSUED FOR:	DATE:	BY:
DATE ISSUED	06/24/2025	MK

PROJECT TITLE:
WALLER CREEK
ITEM NUMBER:
GR-IF-120L
DESCRIPTION:
BENCH

SPECIFICATIONS:
MATERIAL:
ST-01: PORTUGAL BEIGE LIMESTONE UP-120: UPHOLSTERY
FINISH:
STONE: HONED SURFACE CHISELLED SURFACE ALL SURFACES: MATTE PROTECTIVE SEALANT
NOTES:

JOB NO:	320C
DRAWN BY:	MK/YA/BD
DATE DRAWN:	6/25/2025
SCALE:	AS NOTED
SHEET:	

侧面剖面图

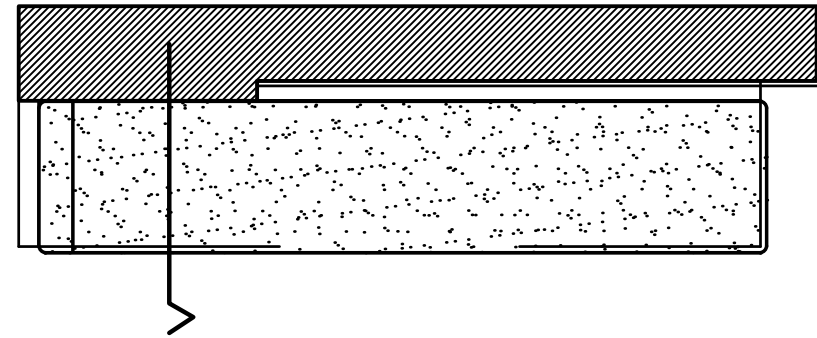

ISSUED FOR:	DATE:	BY:
DATE ISSUED	06/24/2025	MK

PROJECT TITLE:

WALLER CREEK

ITEM NUMBER:

GR-IF-120L

DESCRIPTION:

BENCH

SPECIFICATIONS:

MATERIAL:

ST-01: PORTUGAL BEIGE LIMESTONE

UP-120: UPHOLSTERY

FINISH:
STONE: HONED SURFACE
CHISELLED SURFACE ALL SURFACES:
MATTE PROTECTIVE SEALANT

NOTES:

JOB NO:	320C
DRAWN BY:	MK/YA/BD
DATE DRAWN:	6/25/2025
SCALE:	AS NOTED
SHEET:	

SCALE 3" = 1' 0"