

表面哑光

CUT AND HONED SURFACE

ST-01

LIVE STONE EDGE

自然边

WD-01

NYLON GLIDES X4

GR - -IF- 160

石头：葡萄牙米黄

数量：179个

整个石头都要做防水

Reviewed No Exceptions Noted

Reviewed Exceptions Noted

Revise and Resubmit

Rejected

(

(X)

()

()

By

XAVIER ESCRIBU

Date

3/17/2025

ISSUED FOR:			DATE:	BY:
DATE ISSUED			03/12/2025	MK

PROJECT TITLE:

WALLER CREEK

ITEM NUMBER:

GR-IF-160

DESCRIPTION:

BESIDE TABLE

SPECIFICATIONS:

MATERIAL:

WD -01 - EUROPEAN OAK

ST- 01 - PORTUGAL BEIGE LIMESTONE

FINISH:

WOOD: BONA NATURALE MATTE SEALANT

STONE: ~~MATTE ATER RESISTANT~~

STONE SEALANT

NOTES:

JOB NO:

320C

DRAWN BY:

MK/YA

DATE DRAWN:

03/10/2025

SCALE:


AS NOTED

SHEET:

01


TOP VIEW

俯视图

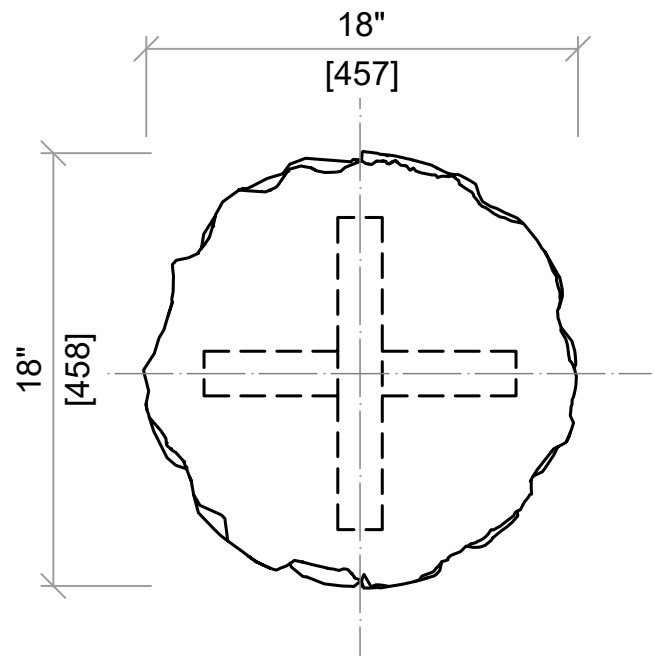


PLAN VIEW

平面剖面图

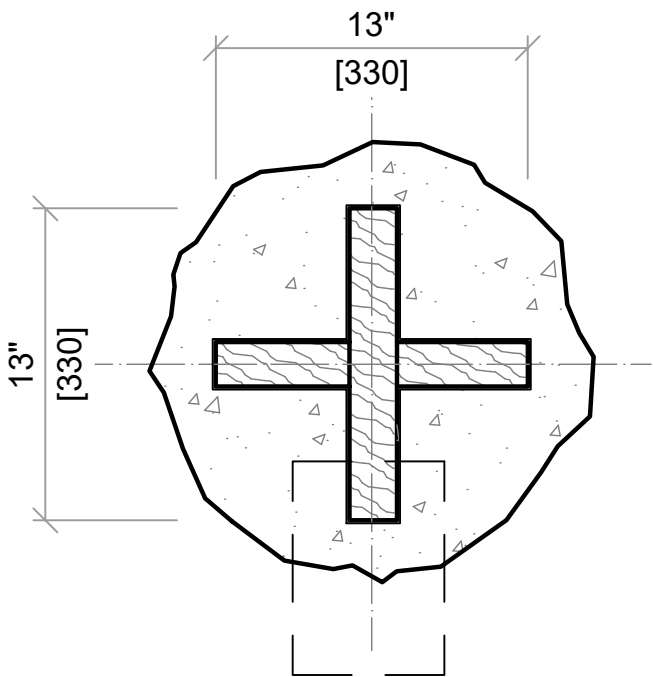


DETAIL VIEW

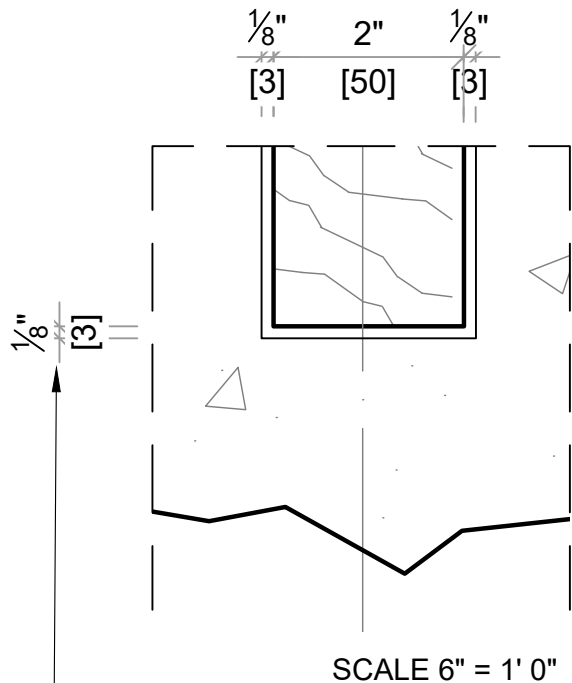


FRONT VIEW

正面图

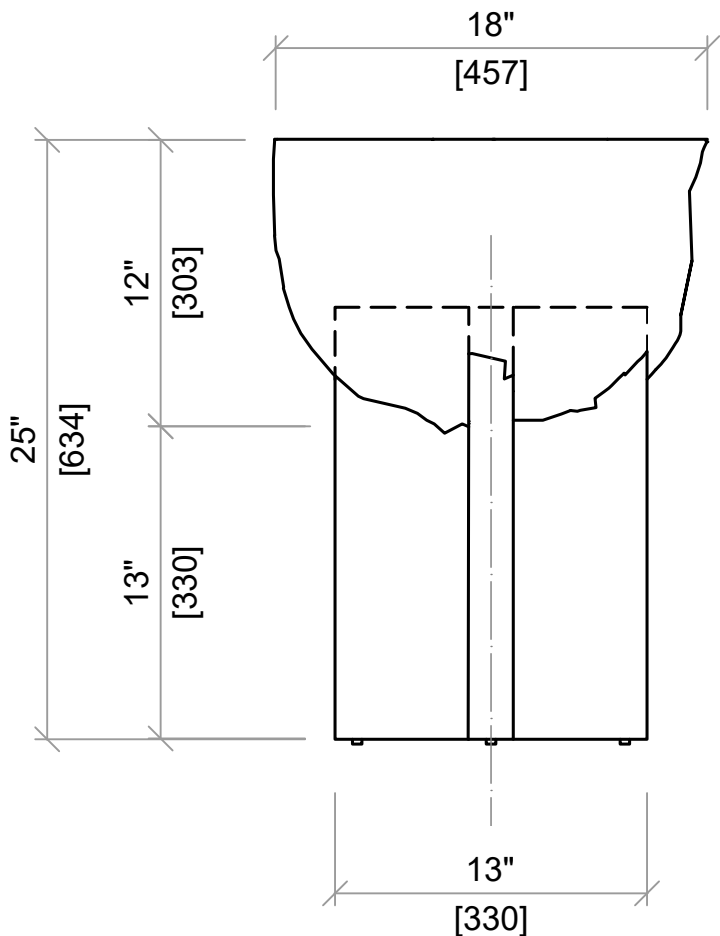

SECTION VIEW

侧面剖面图

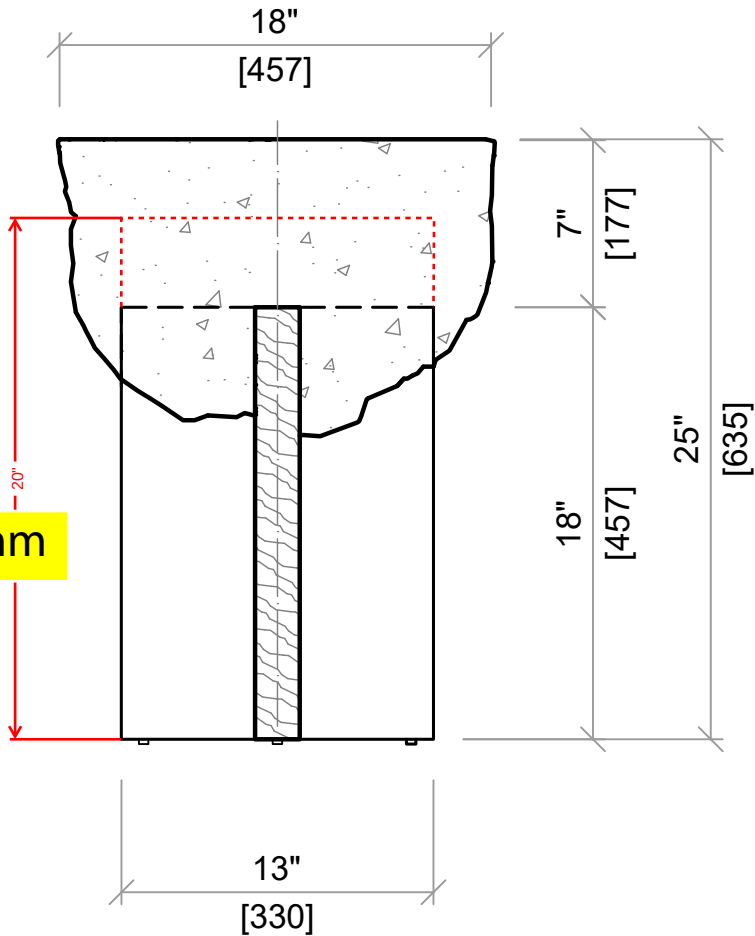

桌腿深度改为18mm

ADDITIONAL
CUT-OUT TO
ENSURE FITS

SCALE 1 1/2 inch = 1 foot 0 inch

ISSUED FOR:	DATE:	BY:
DATE ISSUED	03/12/2025	MK


PROJECT TITLE:
WALLER CREEK
ITEM NUMBER:
GR-IF-160

DESCRIPTION:
BESIDES TABLE

SPECIFICATIONS:
MATERIAL:
WD -01 - EUROPEAN OAK
ST- 01 - PORTUGAL BEIGE
LIMESTONE
FINISH:
WOOD: BONA NATURALE MATTE
SEALANT
STONE: MATTE ATER RESISTANT
STONE SEALANT

NOTES:

JOB NO:	320C
DRAWN BY:	MK/YA
DATE DRAWN:	03/10/2025
SCALE:	AS NOTED
SHEET:	

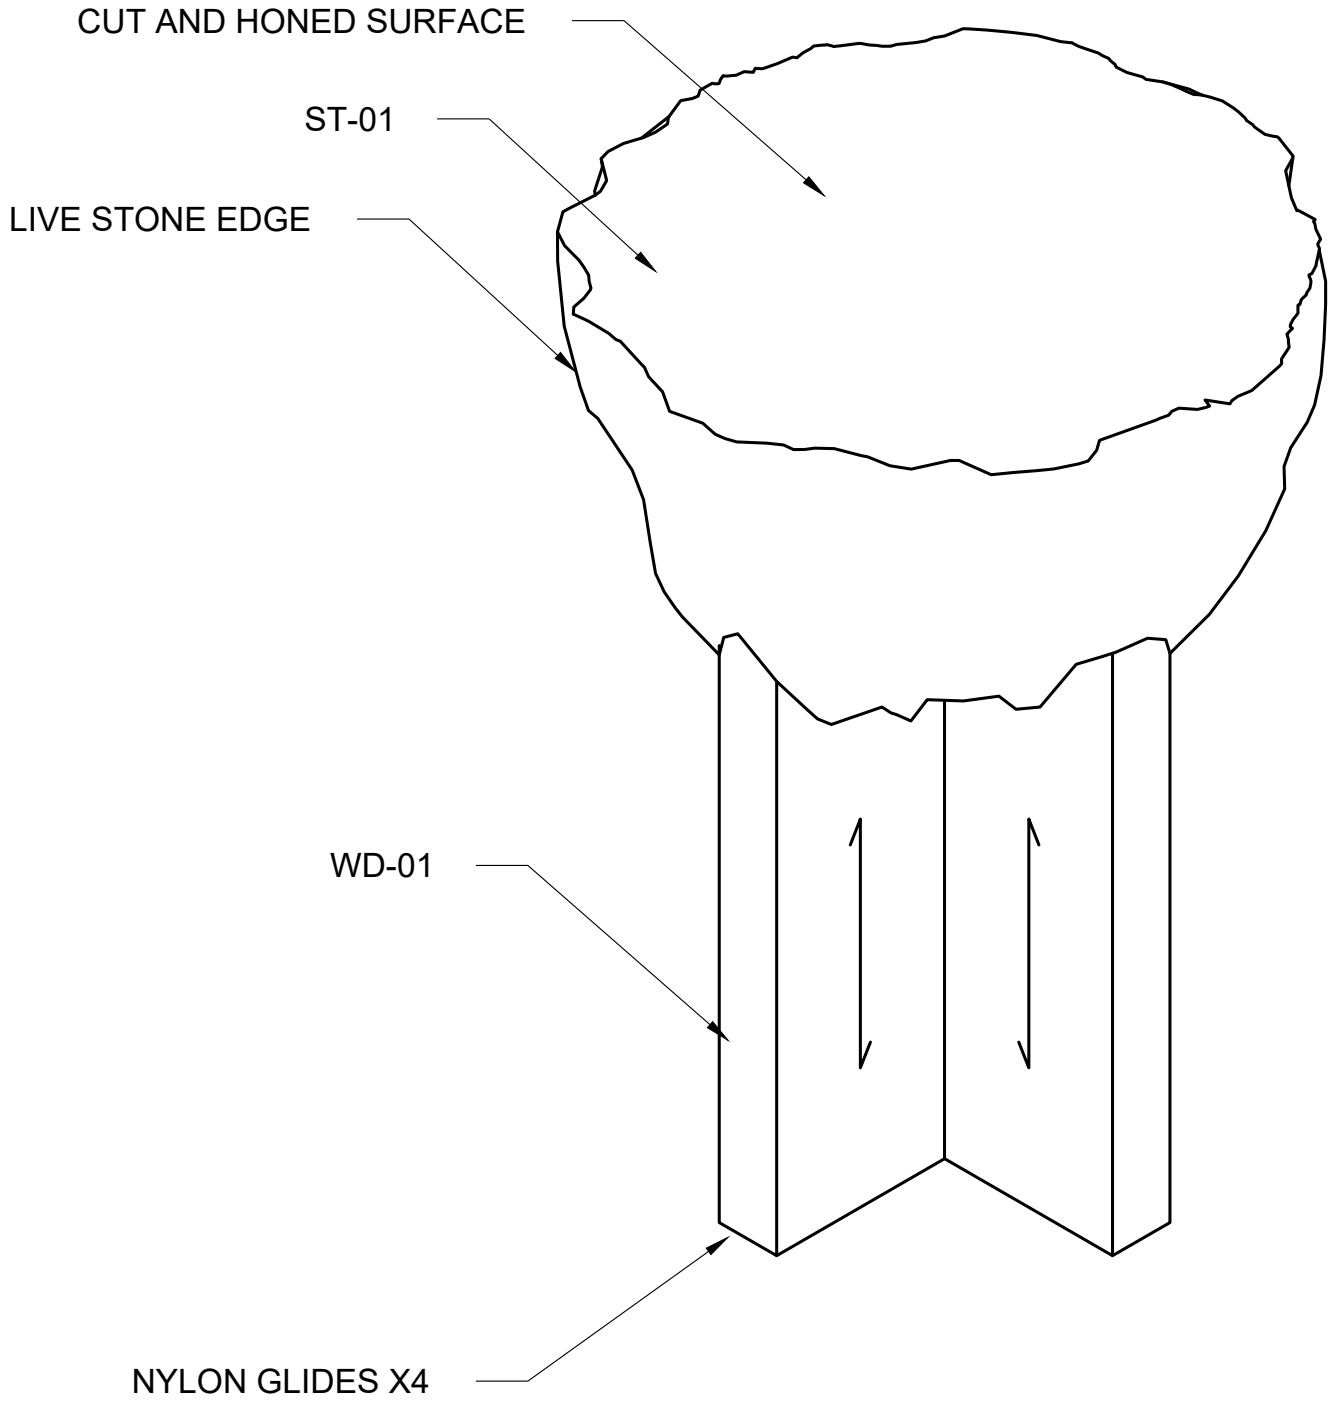

GR - -IF- 360
石头：葡萄牙米黄
数量：110个
整个石头都要做防水

PENETRATING STONE
SEALANT

Reviewed No Exceptions Noted ()
Reviewed Exceptions Noted (X)
Revise and Resubmit ()
Rejected ()

By XAVIER ESCRIBU Date 5/30/2025

ISSUED FOR:	DATE:	BY:
DATE ISSUED	03/12/2025	MK

PROJECT TITLE:
WALLER CREEK

ITEM NUMBER:
GR-IF-360

DESCRIPTION:
BESIDE TABLE

SPECIFICATIONS:

MATERIAL:
WD -01 - EUROPEAN OAK
ST- 01 - PORTUGAL BEIGE
LIMESTONE

FINISH:
WOOD: BONA NATURALE MATTE
SEALANT
STONE: ~~MATTE ATER RESISTANT~~
~~STONE SEALANT~~

NOTES:

JOB NO: **320C**


DRAWN BY: **MK/YA**

DATE DRAWN: **03/10/2025**


SCALE: **AS NOTED**

SHEET:
01


TOP VIEW
俯视图

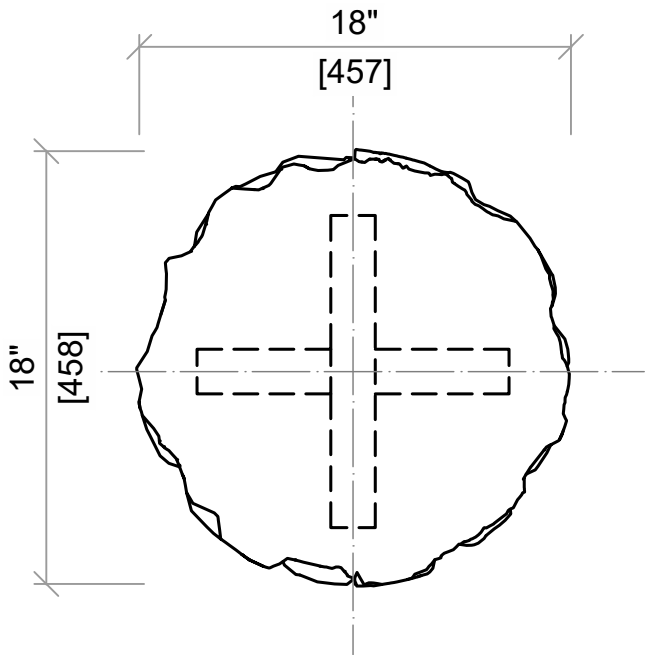


PLAN VIEW
平面剖面图

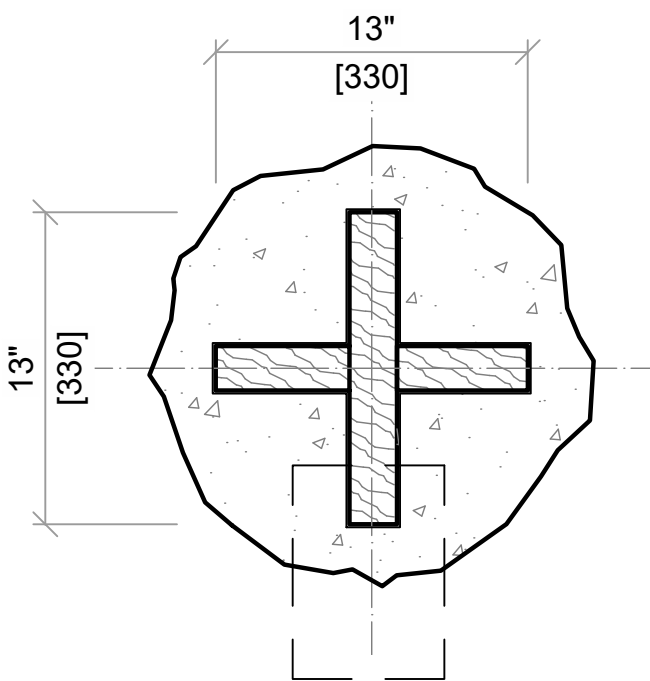


DETAIL VIEW

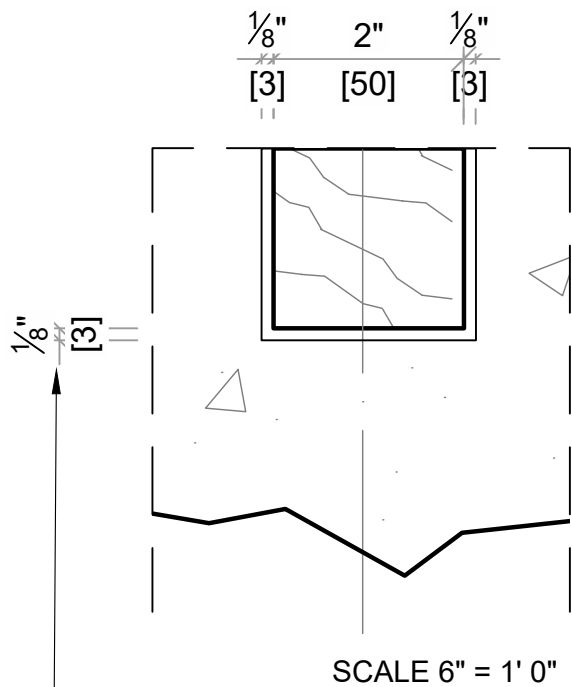

FRONT VIEW
正面图

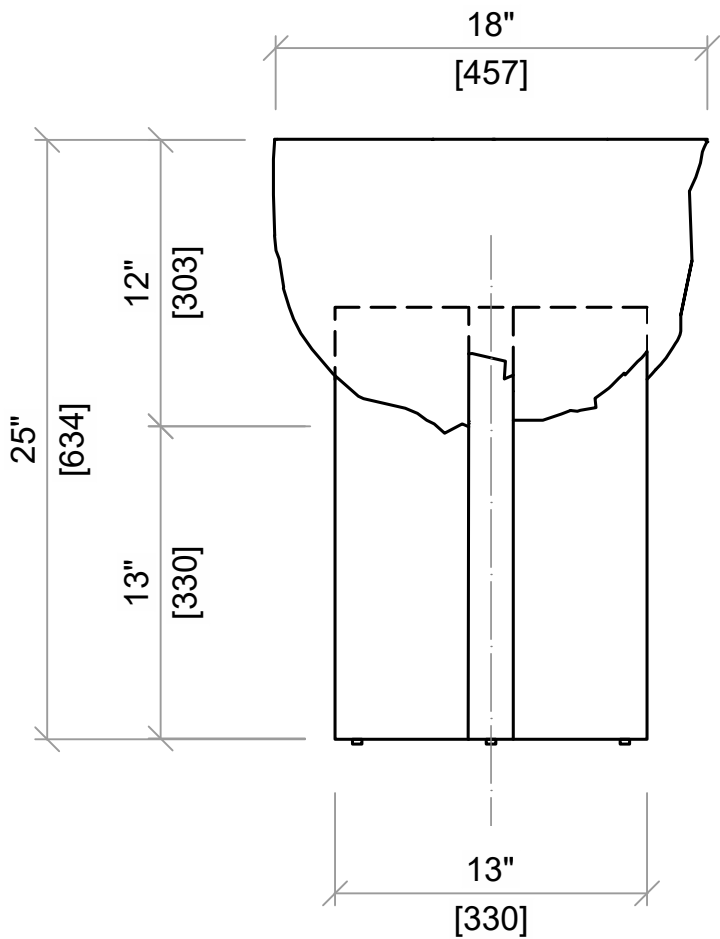

SECTION VIEW
侧面剖面图

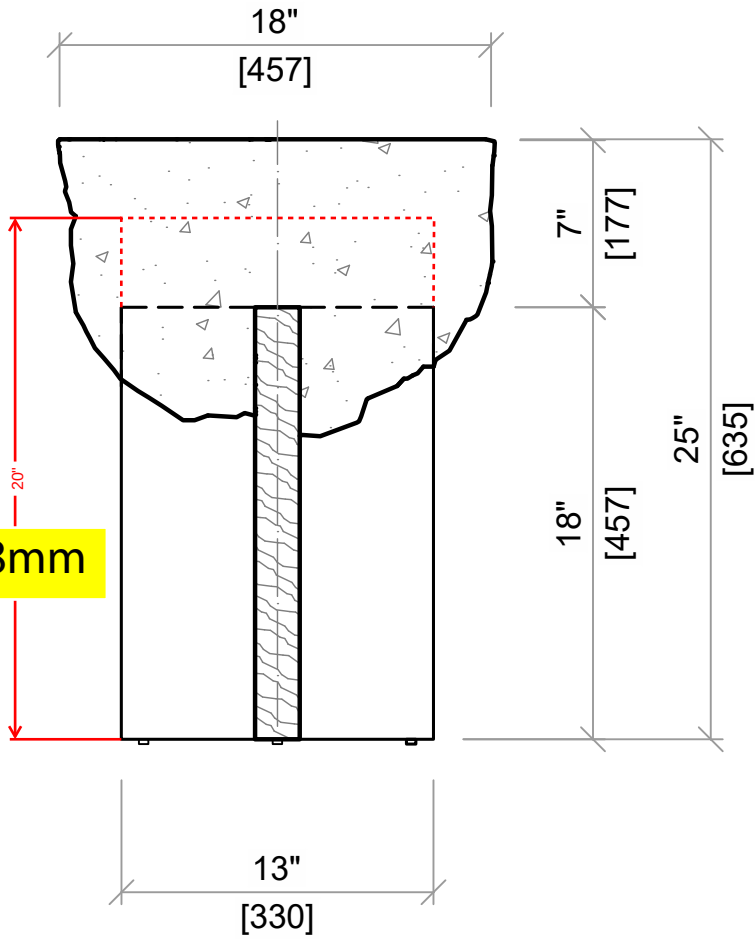

桌腿深度改为18mm

ADDITIONAL
CUT-OUT TO
ENSURE FITS

SCALE 1 1/2 inch = 1 foot 0 inch

ISSUED FOR:	DATE:	BY:
DATE ISSUED	03/12/2025	MK

PROJECT TITLE:
WALLER CREEK

ITEM NUMBER:
GR-IF-360

DESCRIPTION:
BESIDES TABLE


SPECIFICATIONS:
MATERIAL:
WD -01 - EUROPEAN OAK
ST- 01 - PORTUGAL BEIGE
LIMESTONE

FINISH:
WOOD: BONA NATURALE MATTE
SEALANT
STONE: MATTE ATER RESISTANT
STONE SEALANT


NOTES:

JOB NO:	320C
DRAWN BY:	MK/YA
DATE DRAWN:	03/10/2025
SCALE:	AS NOTED
SHEET:	


TOP VIEW

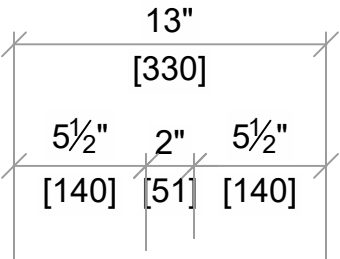

LEGS , MORTISE AND TENON

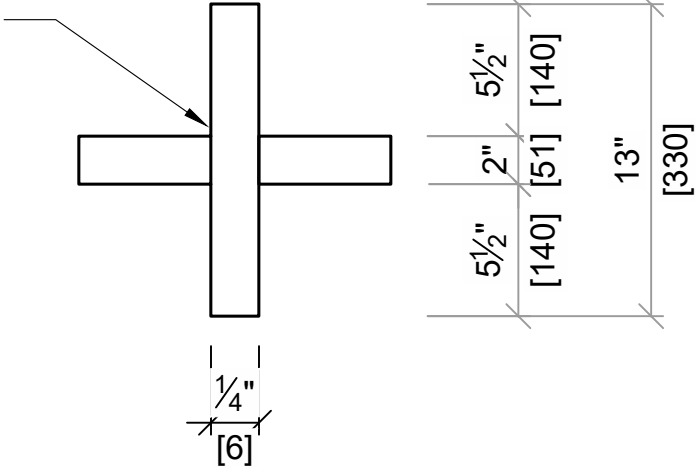


FRONT VIEW

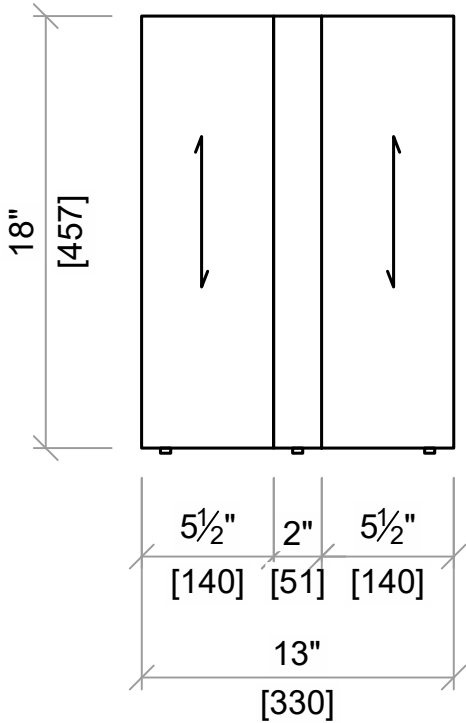

桌腿图纸

SIDE VIEW

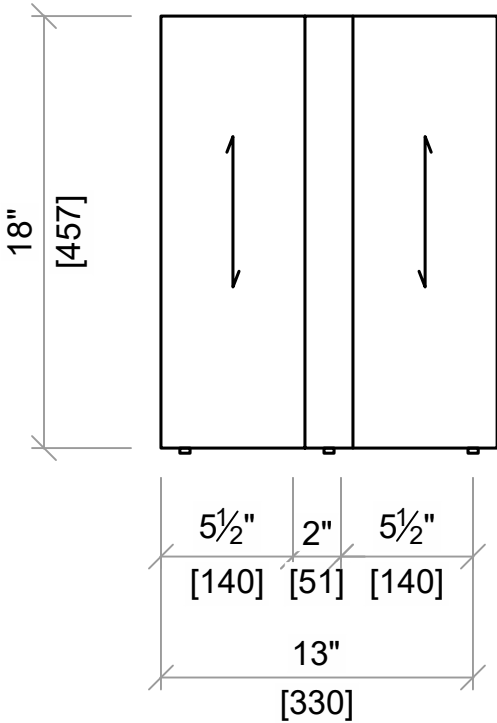

SCALE 1 1/2" = 1' 0"

ISSUED FOR:	DATE:	BY:
DATE ISSUED	03/12/2025	MK

PROJECT TITLE:
WALLER CREEK

ITEM NUMBER:
GR-IF-360

DESCRIPTION:
BESIDES TABLE

SPECIFICATIONS:
MATERIAL:
WD -01 - EUROPEAN OAK
ST- 01 - PORTUGAL BEIGE
LIMESTONE


FINISH:
WOOD: BONA NATURALE MATTE
SEALANT
STONE: MATTE ATER RESISTANT
STONE SEALANT

NOTES:

JOB NO:	320C
DRAWN BY:	MK/YA
DATE DRAWN:	03/10/2025
SCALE:	AS NOTED


SHEET:
03

TOP VIEW

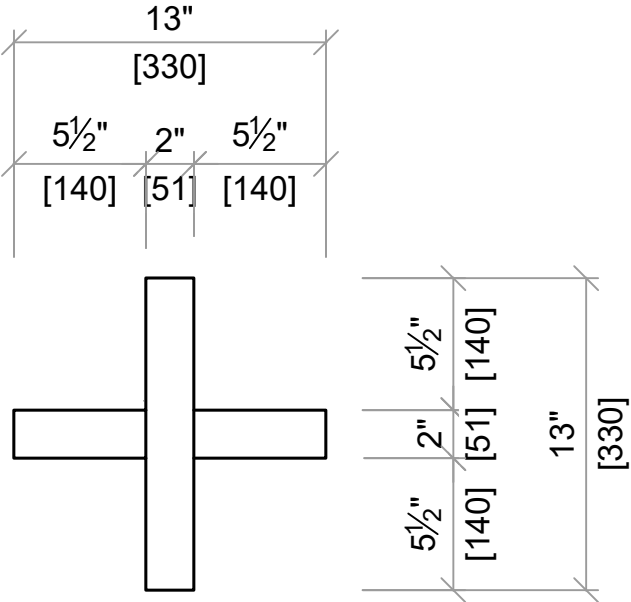


桌腿图纸

FRONT VIEW

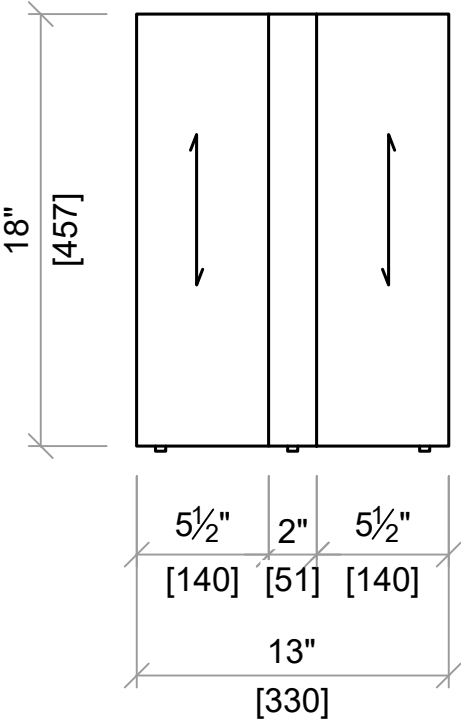

SIDE VIEW

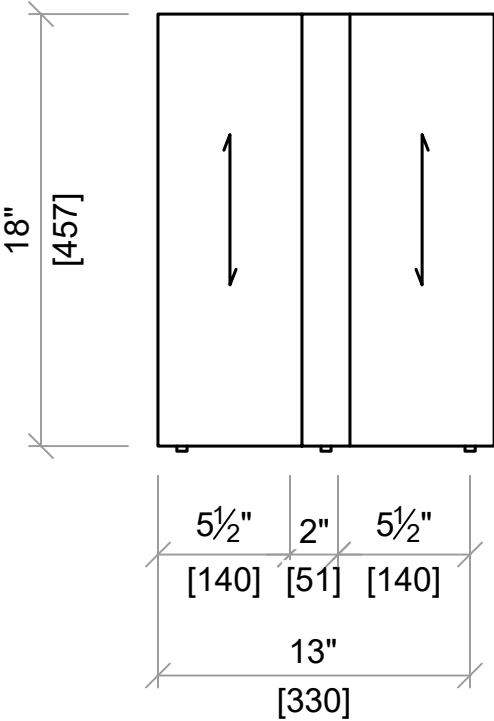

SCALE 1 1/2" = 1' 0"

ISSUED FOR:	DATE:	BY:
DATE ISSUED	03/12/2025	MK


PROJECT TITLE:
WALLER CREEK
ITEM NUMBER:
GR-IF-160
DESCRIPTION:
BESIDES TABLE

SPECIFICATIONS:
MATERIAL:
WD -01 - EUROPEAN OAK
ST- 01 - PORTUGAL BEIGE
LIMESTONE
FINISH:
WOOD: BONA NATURALE MATTE
SEALANT
STONE: MATTE ATER RESISTANT
STONE SEALANT
NOTES:

JOB NO:	320C
DRAWN BY:	MK/YA
DATE DRAWN:	03/10/2025
SCALE:	AS NOTED

SHEET:
03

GR - -IF- 161
石头：葡萄牙米黄
数量：185个
整个石头都要做防水

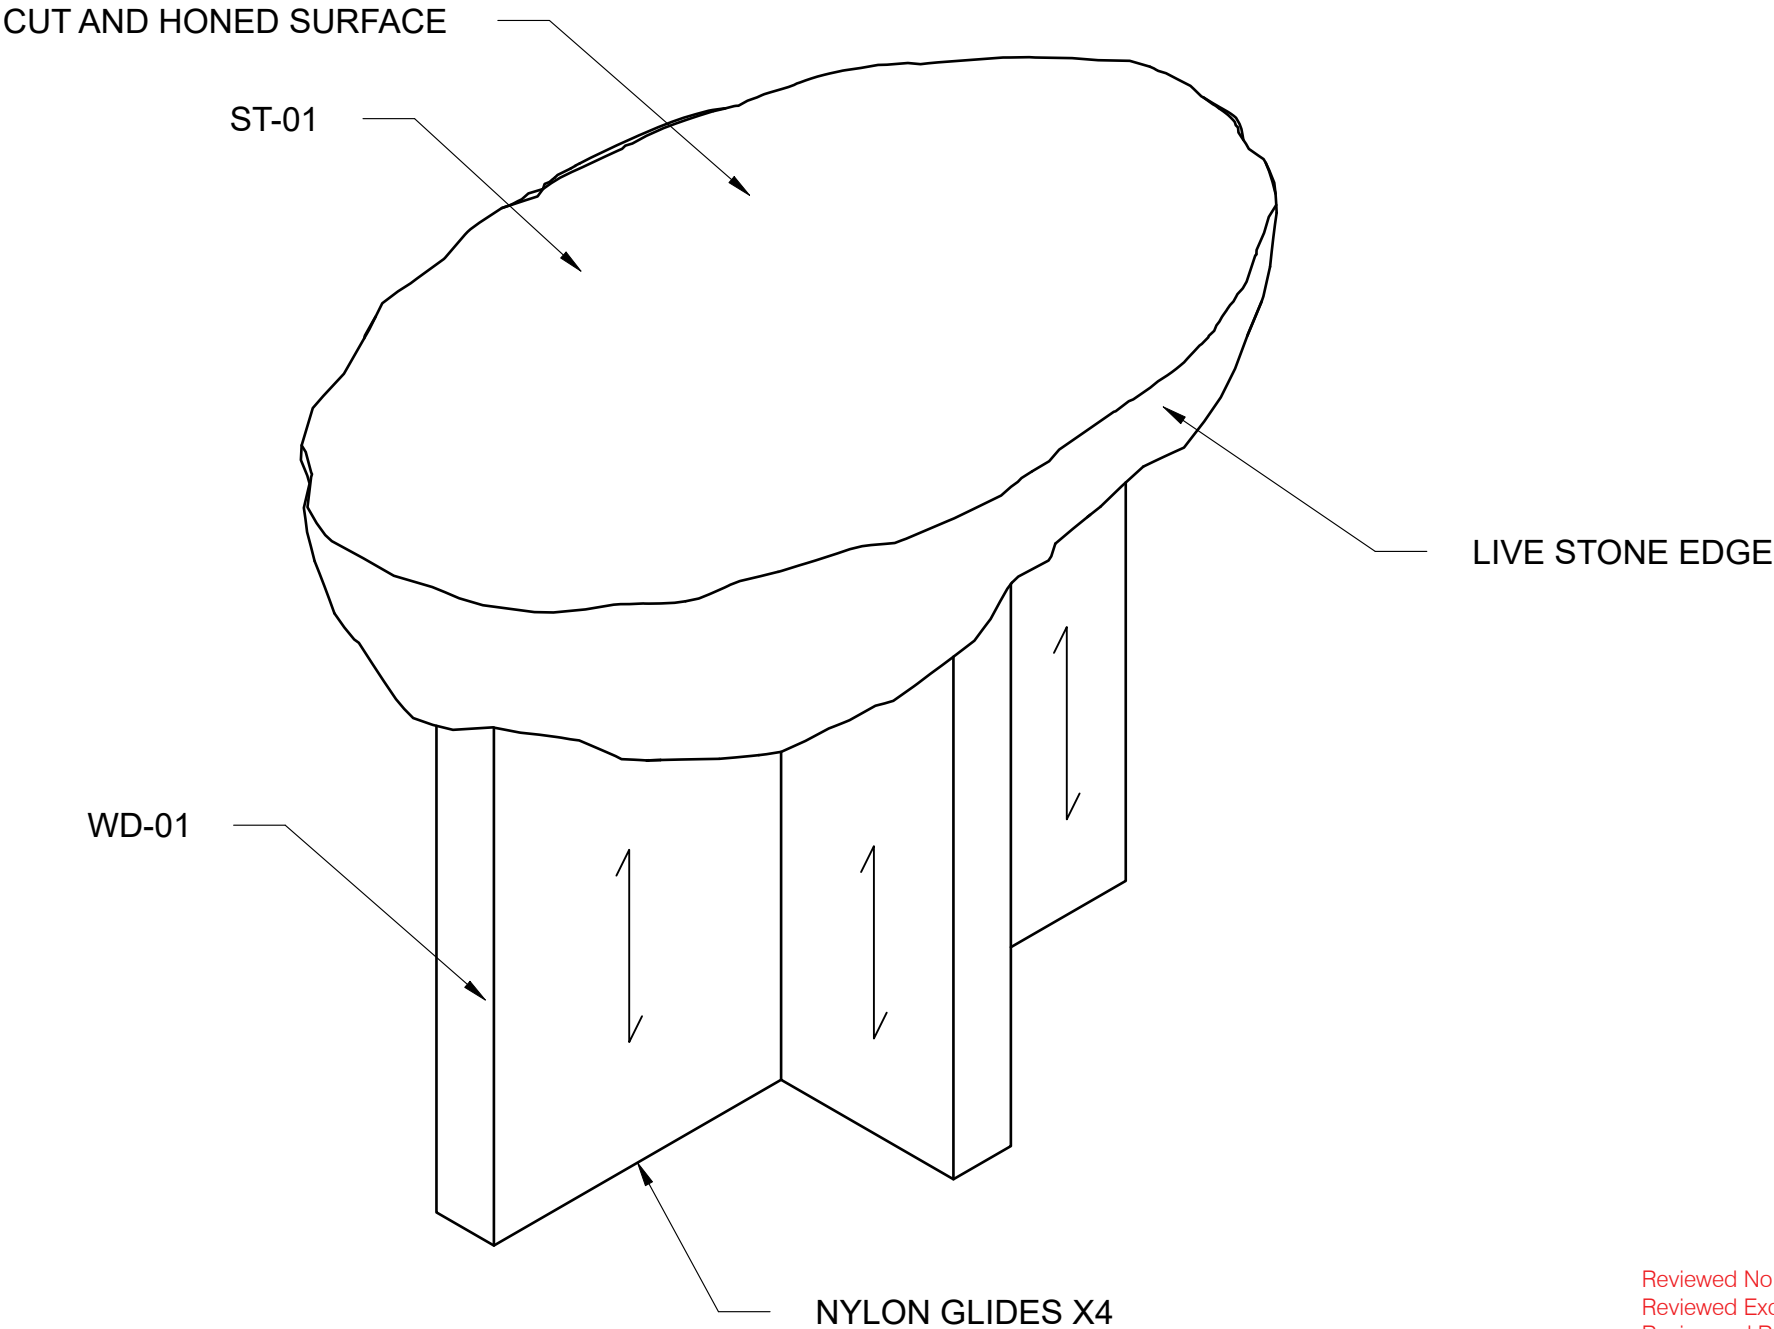

PENETRATING STONE SEALANT

Reviewed No Exceptions Noted ()
Reviewed Exceptions Noted (X)
Revise and Resubmit ()
Rejected ()


By XAVIER ESCRIBU Date 3/28/2025

ISSUED FOR:	DATE:	BY:
DATE ISSUED	03/24/2025	MK


PROJECT TITLE:
WALLER CREEK
ITEM NUMBER:
GR-IF-161
DESCRIPTION:
BEDSID TABLE
SPECIFICATIONS:
MATERIAL: WD-01 EUROPEAN OAK ST-01 PORTUGAL BEIGE LIMESTONE
FINISH: WOOD: BONA NATURALE MATTE SEALANT STONE: MATTE ATER RESISTANT STONE SEALANT
NOTES: -
JOB NO:
320C
DRAWN BY:
MK/DZ
DATE DRAWN:
3/24/2025
SCALE:
AS NOTED

SHEET:
01


TOP VIEW
俯视图

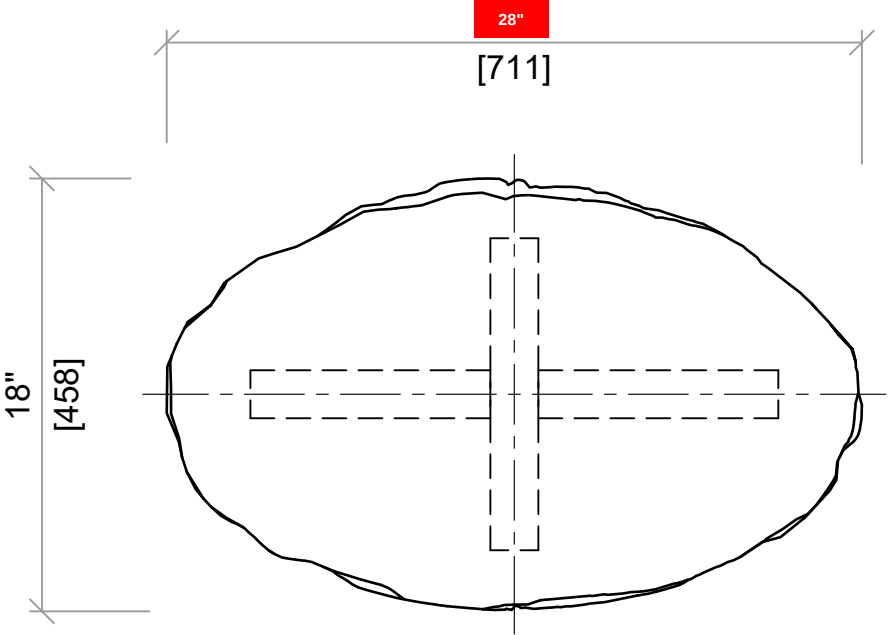

PLAN VIEW
1-1 section
平面剖面图

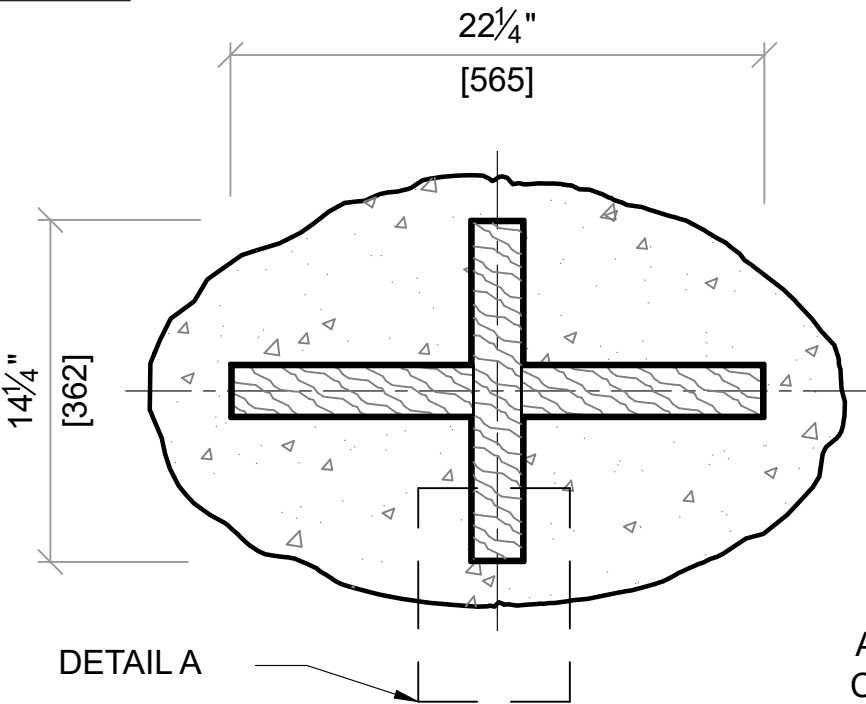


DETAIL A

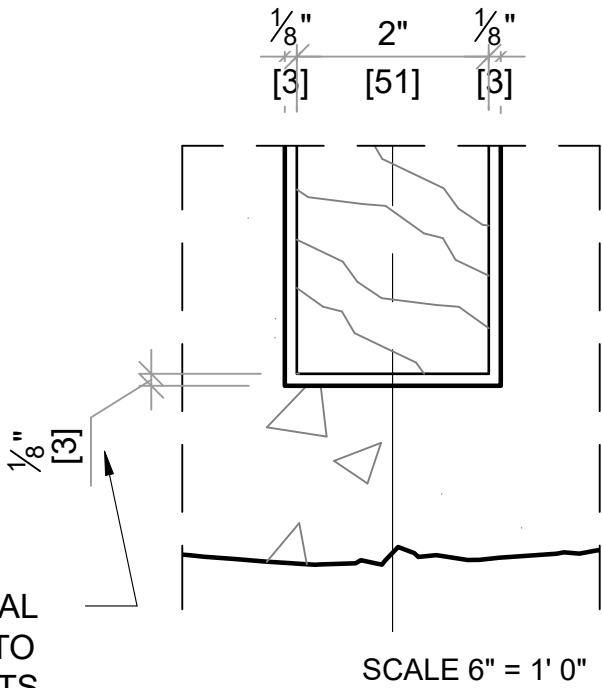


ADDITIONAL
CUT-OUT TO
ENSURE FITS


FRONT VIEW
正面图

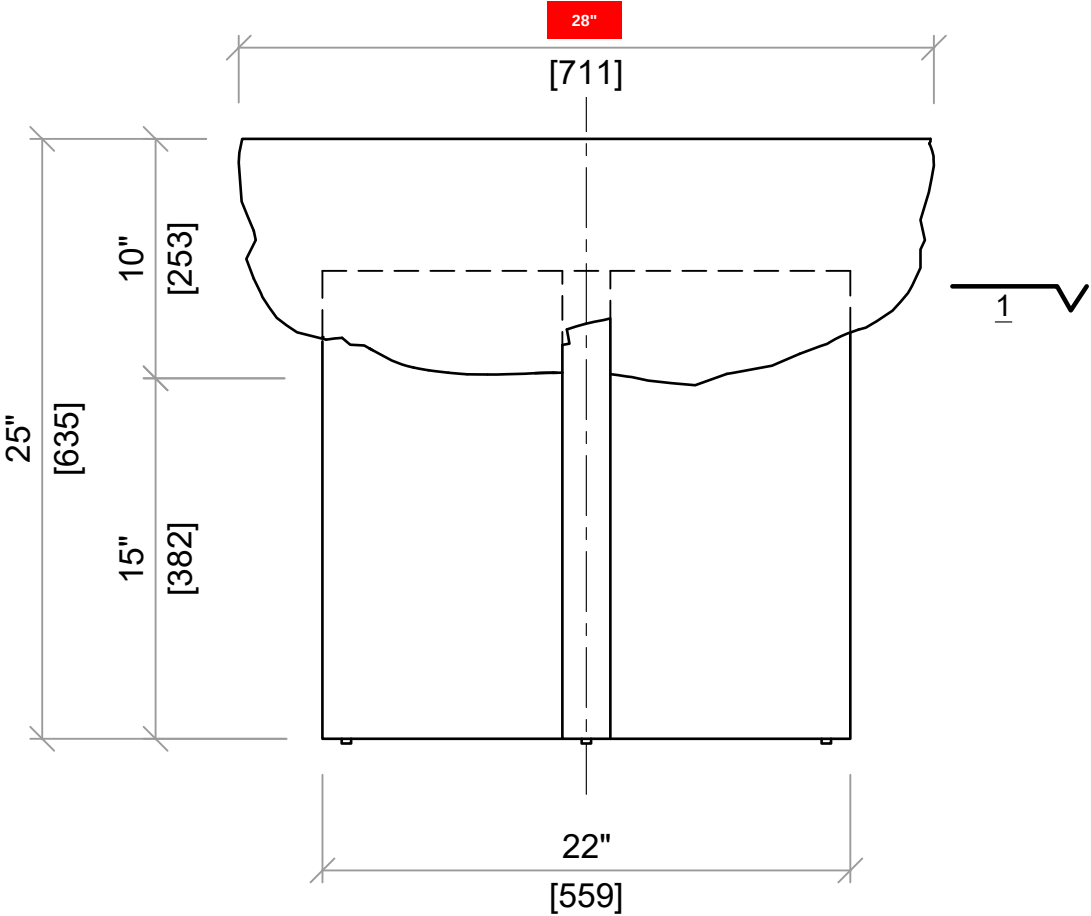

SIDE VIEW
侧面图

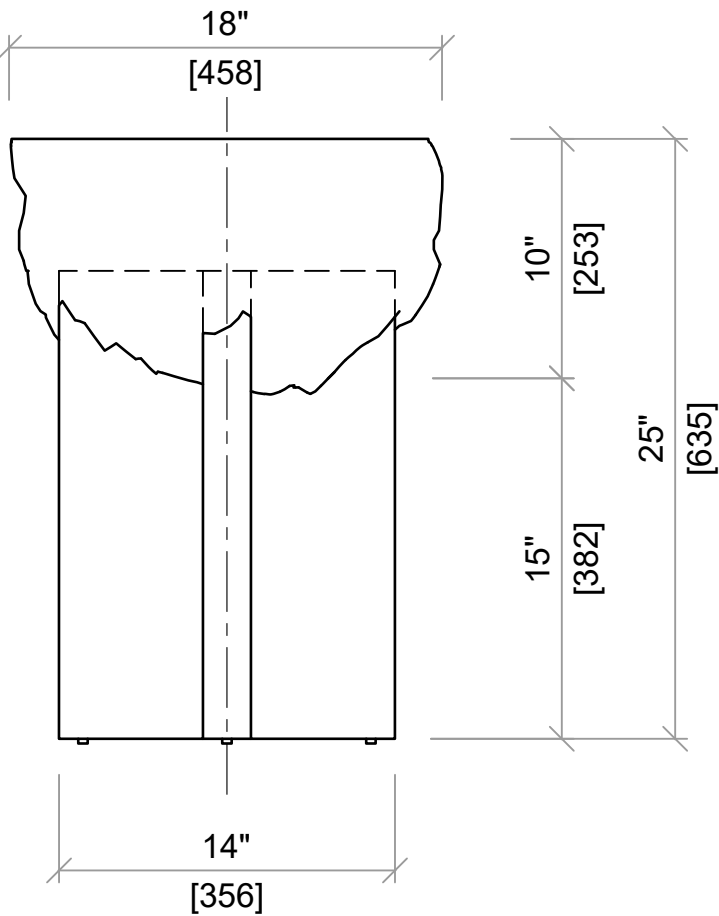

SECTION VIEW
侧面剖面图

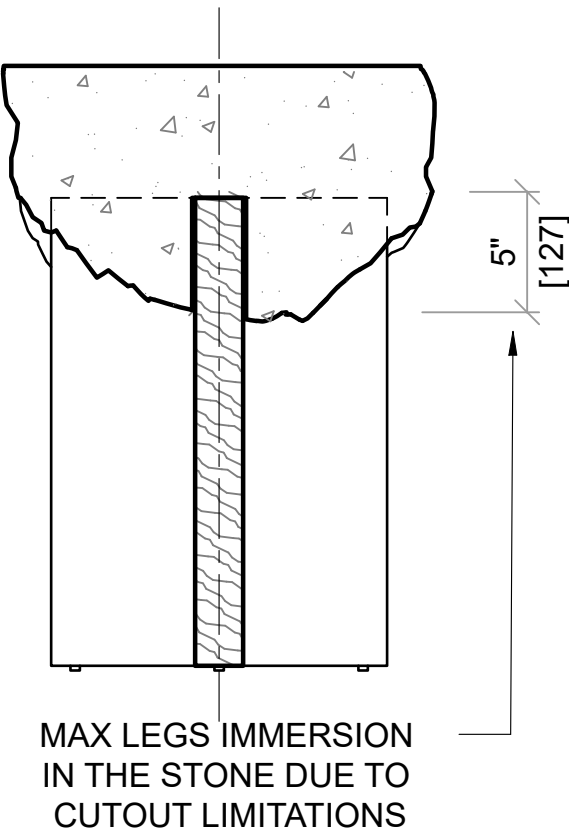

ISSUED FOR:	DATE:	BY:
DATE ISSUED	03/24/2025	MK

PROJECT TITLE:
WALLER CREEK

ITEM NUMBER:
GR-IF-161


DESCRIPTION:
BEDSIDE TABLE

SPECIFICATIONS:
MATERIAL:
WD-01 EUROPEAN OAK
ST-01 PORTUGAL BEIGE
LIMESTONE
FINISH:
WOOD: BONA NATURALE MATTE
SEALANT
STONE: MATTE ATER RESISTANT
STONE SEALANT


NOTES:

JOB NO:	320C
DRAWN BY:	MK/DZ
DATE DRAWN:	3/24/2025
SCALE:	AS NOTED
SHEET:	

TOP VIEW

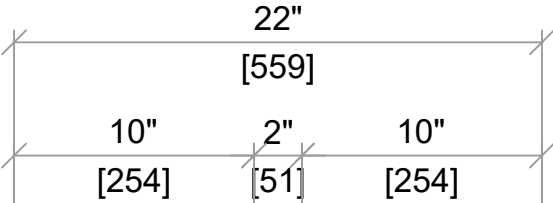


LEGS, MORTISE AND TENON

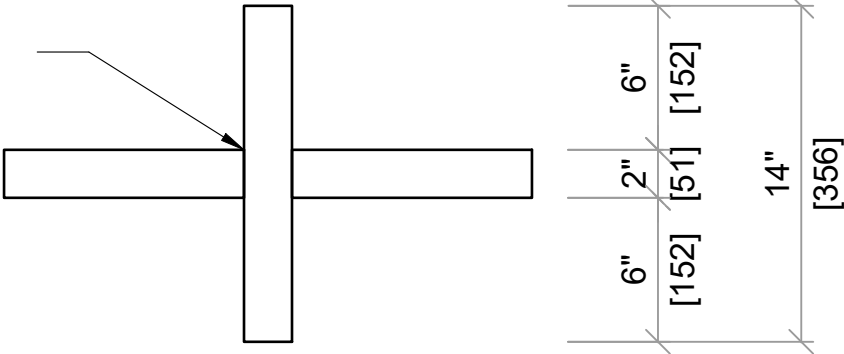


桌腿图纸

FRONT VIEW

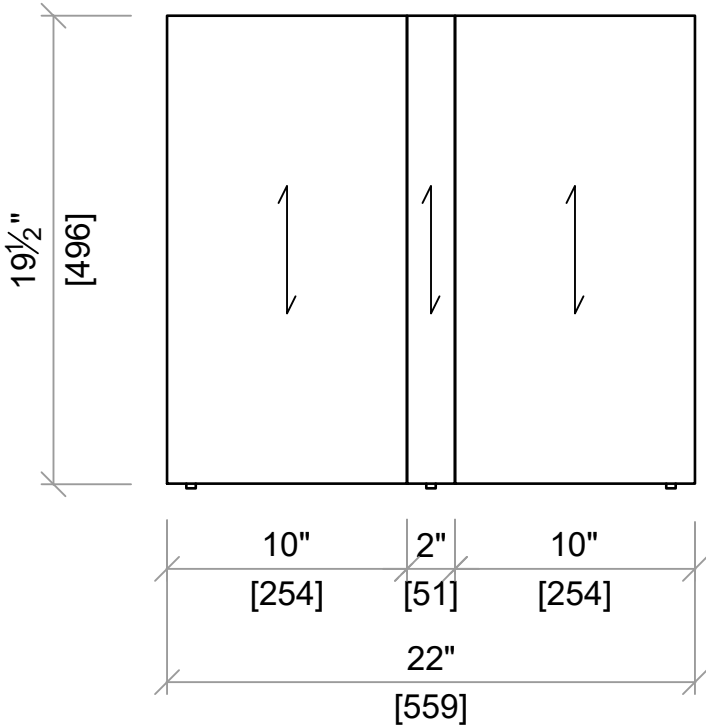

SIDE VIEW

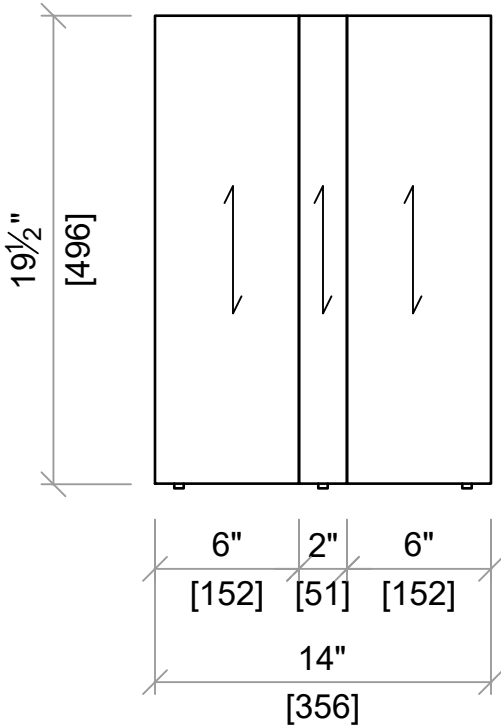

SCALE 1 1/2" = 1' 0"

ISSUED FOR:	DATE:	BY:
DATE ISSUED	03/24/2025	MK

PROJECT TITLE:
WALLER CREEK

ITEM NUMBER:
GR-IF-161

DESCRIPTION:
BEDSIDE TABLE

SPECIFICATIONS:
MATERIAL:
WD-01 EUROPEAN OAK
ST-01 PORTUGAL BEIGE
LIMESTONE


FINISH:
WOOD: BONA NATURALE MATTE
SEALANT
STONE: MATTE ATER RESISTANT
STONE SEALANT

NOTES:
-

JOB NO:	320C
DRAWN BY:	MK/DZ
DATE DRAWN:	3/24/2025
SCALE:	AS NOTED

SHEET:
03

GR - -IF- 363
石头：葡萄牙米黄
数量：10个
整个石头都要做防水

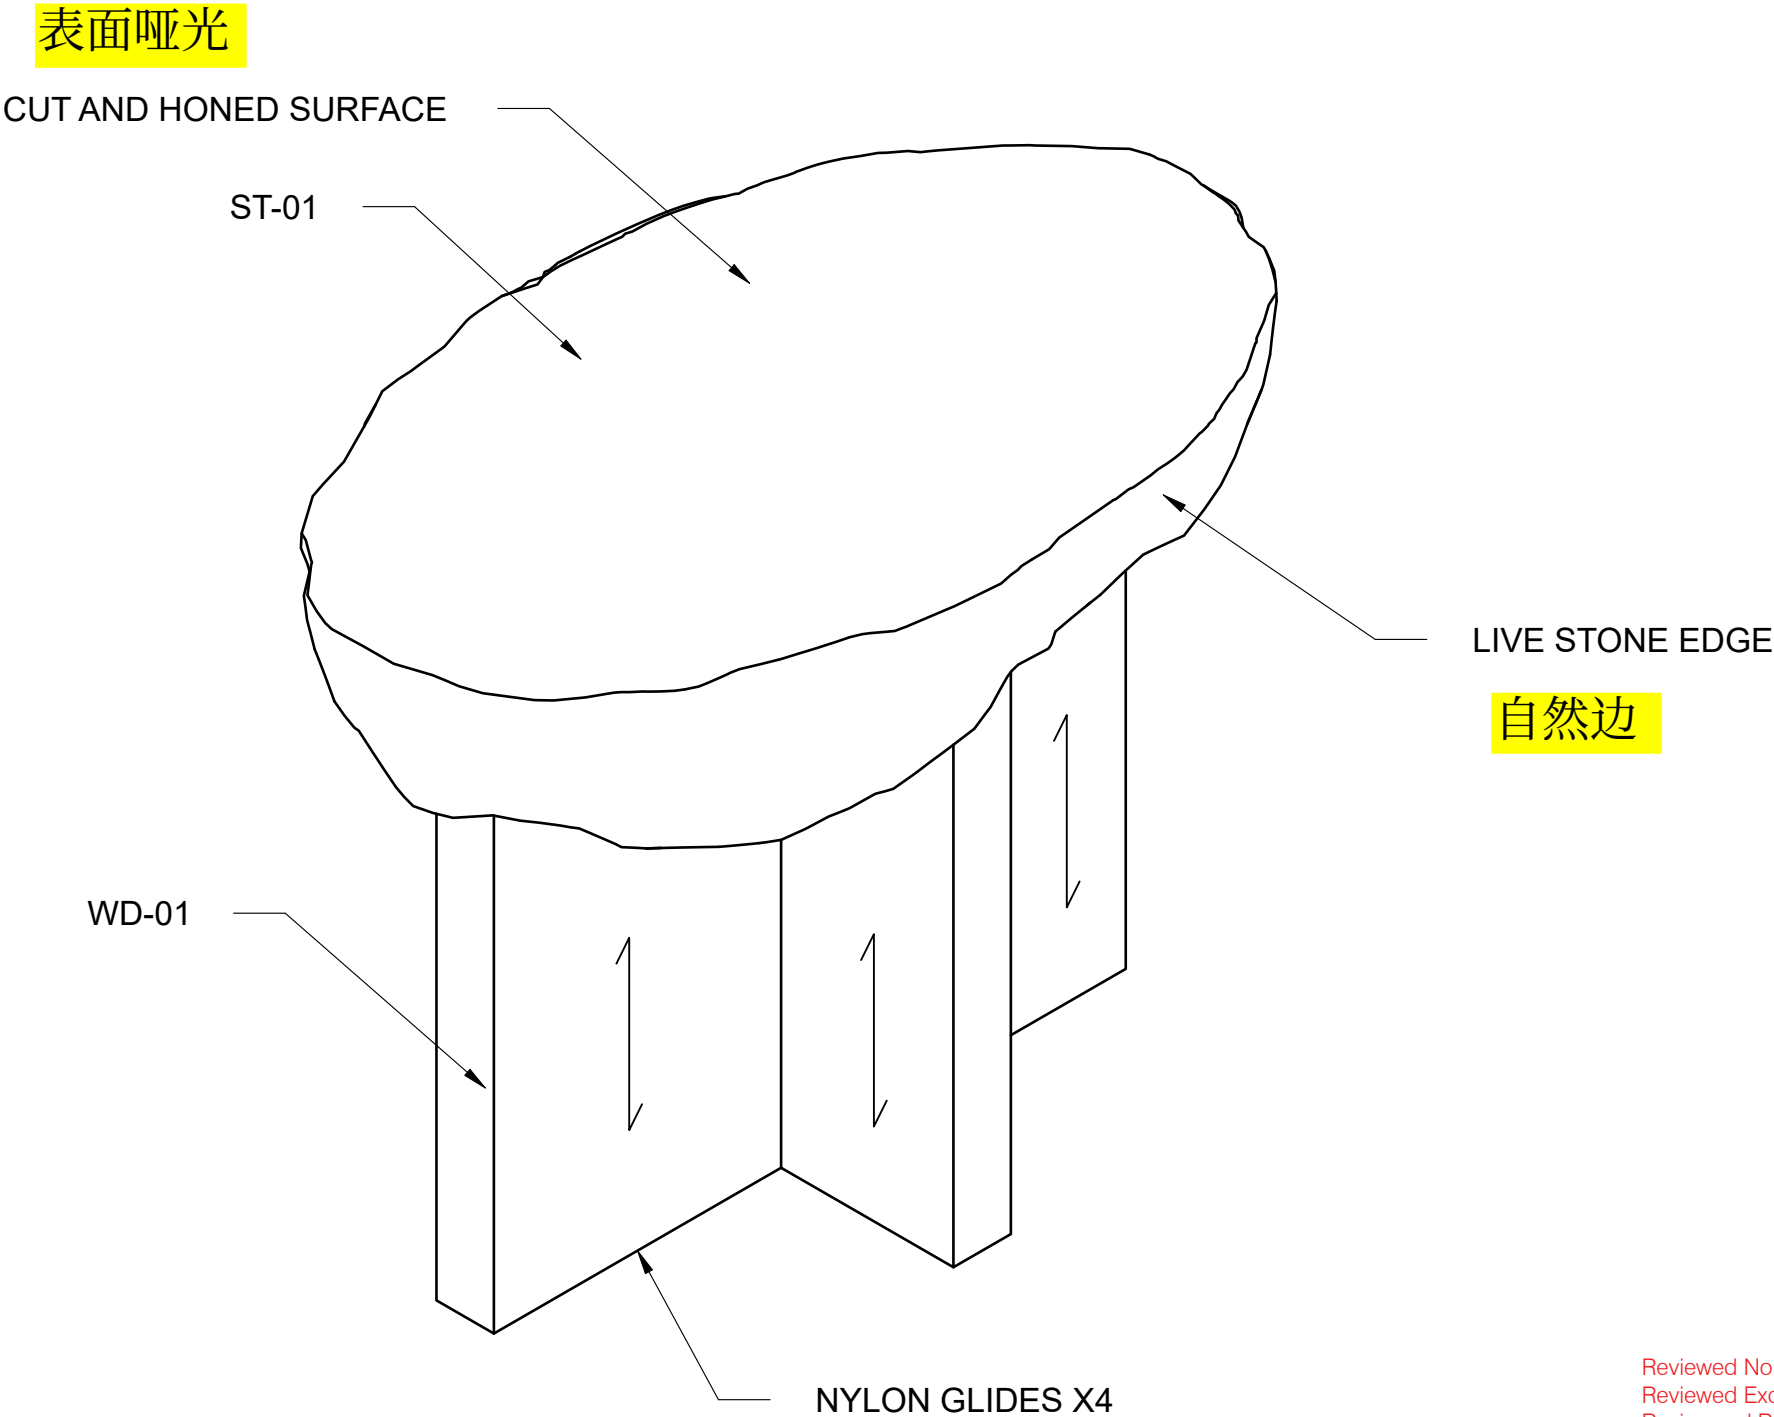

PENETRATING STONE SEALANT

Reviewed No Exceptions Noted ()
Reviewed Exceptions Noted (X)
Revise and Resubmit ()
Rejected ()


By XAVIER ESCRIBU Date 5/30/2025

ISSUED FOR:	DATE:	BY:
DATE ISSUED	03/24/2025	MK

PROJECT TITLE:		
WALLER CREEK		
ITEM NUMBER:		
GR-IF-363		
DESCRIPTION:		
BEDSID TABLE		
SPECIFICATIONS:		
MATERIAL: WD-01 EUROPEAN OAK ST-01 PORTUGAL BEIGE LIMESTONE		
FINISH: WOOD: BONA NATURALE MATTE SEALANT STONE: MATTEATER RESISTANT STONE SEALANT		
NOTES: -		
JOB NO:	320C	
DRAWN BY:	MK/DZ	
DATE DRAWN:	3/24/2025	
SCALE:	AS NOTED	
SHEET:	01	


TOP VIEW

俯视图

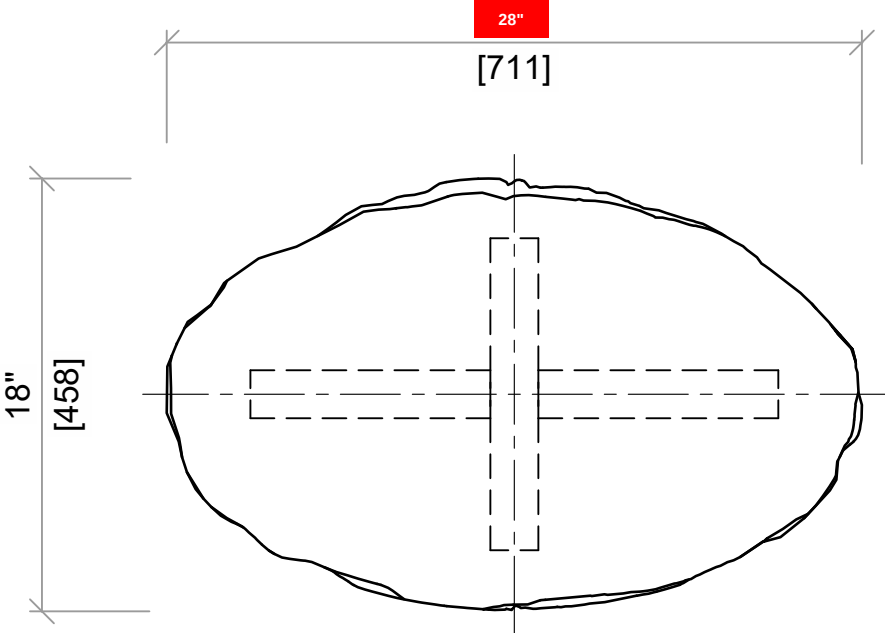


PLAN VIEW
1-1 section

平面剖面图

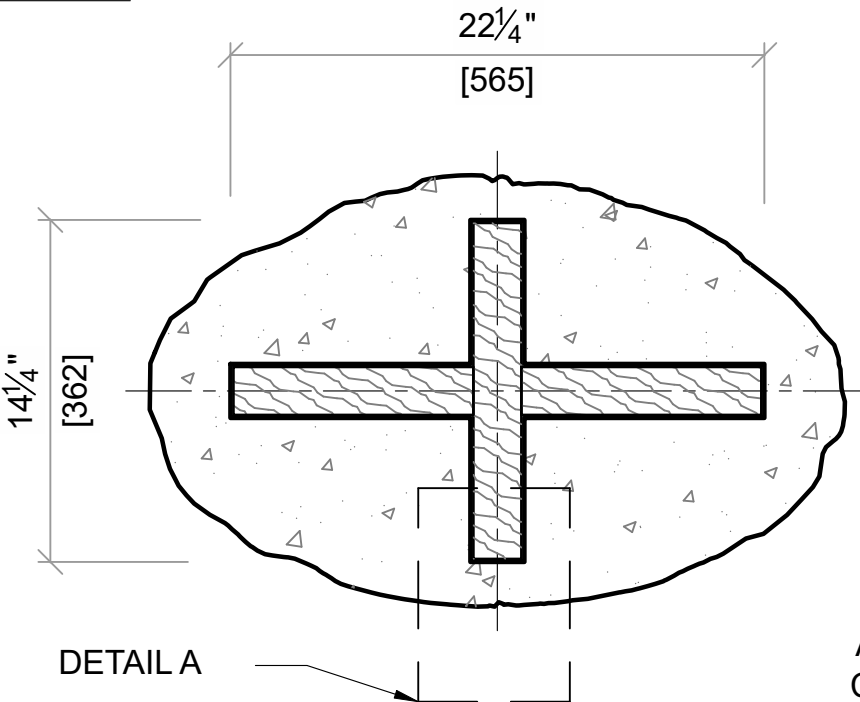


DETAIL A

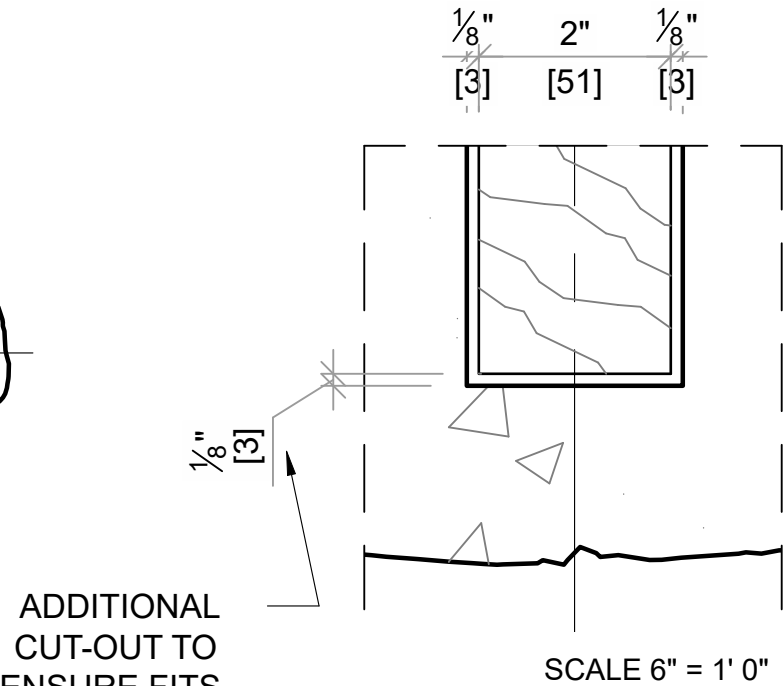

ADDITIONAL
CUT-OUT TO
ENSURE FITS


FRONT VIEW

正面图

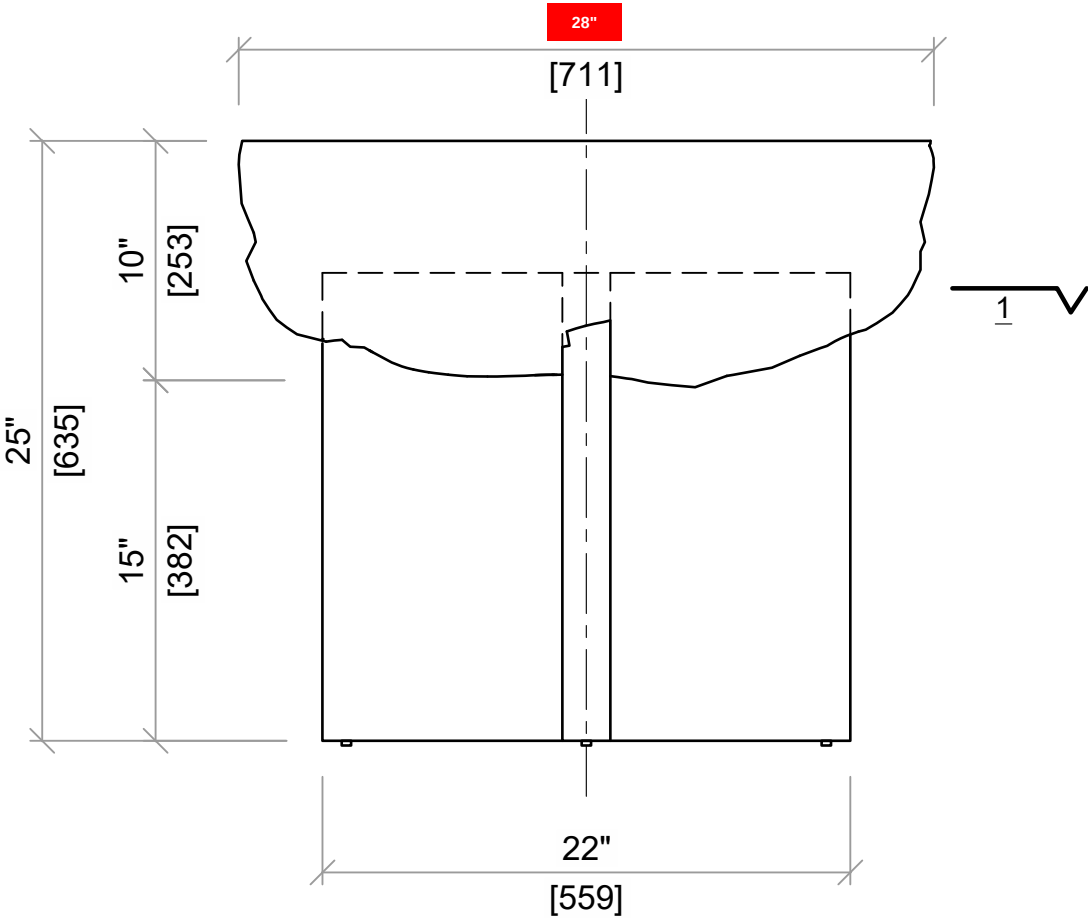


SIDE VIEW

侧面图

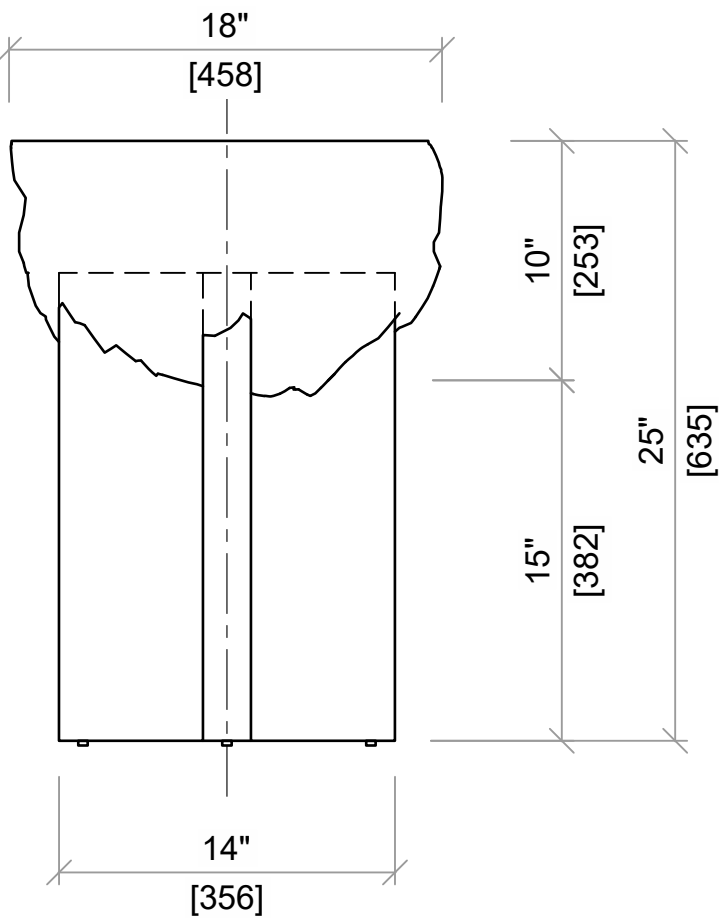

SECTION VIEW

侧面剖面图

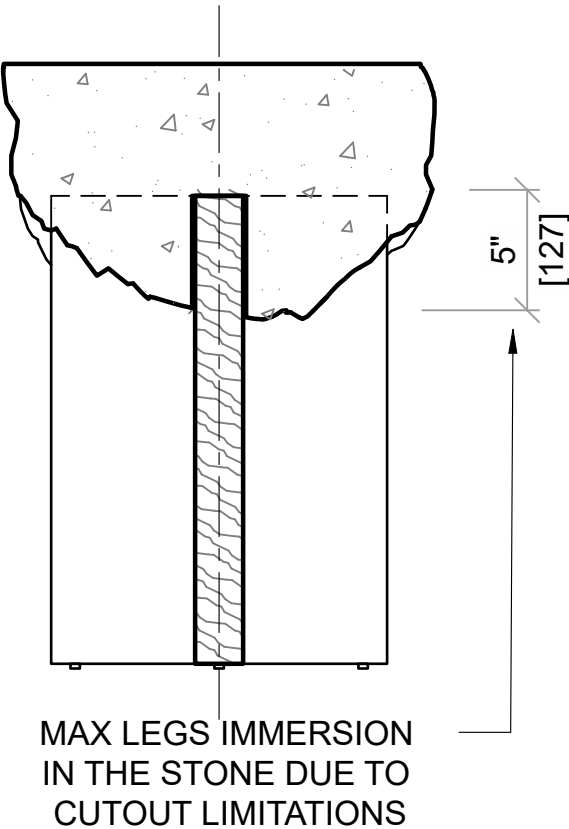

SCALE 1 1/2" = 1' 0"

ISSUED FOR:	DATE:	BY:
DATE ISSUED	03/24/2025	MK

PROJECT TITLE:

WALLER CREEK

ITEM NUMBER:

GR-IF-363

DESCRIPTION:

BEDSIDE TABLE

SPECIFICATIONS:

MATERIAL:
WD-01 EUROPEAN OAK
ST-01 PORTUGAL BEIGE
LIMESTONE

FINISH:
WOOD: BONA NATURALE MATTE
SEALANT
STONE: MATTE ATER RESISTANT
STONE SEALANT

NOTES:

JOB NO: 320C


DRAWN BY: MK/DZ

DATE DRAWN: 3/24/2025


SCALE: AS NOTED

SHEET:

TOP VIEW

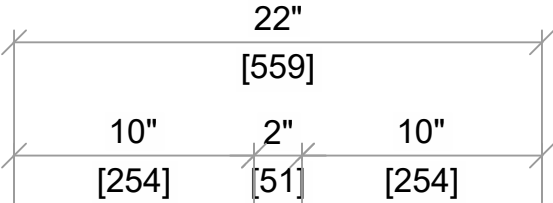


LEGS, MORTISE AND TENON

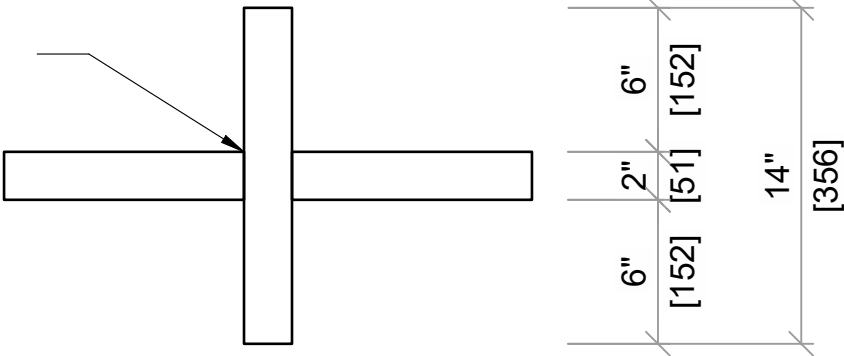


桌腿图纸

FRONT VIEW

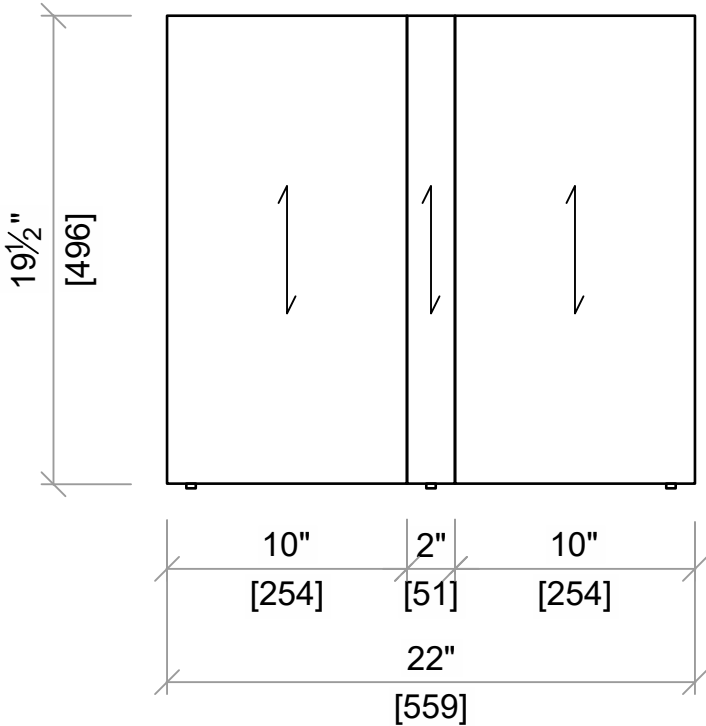

SIDE VIEW

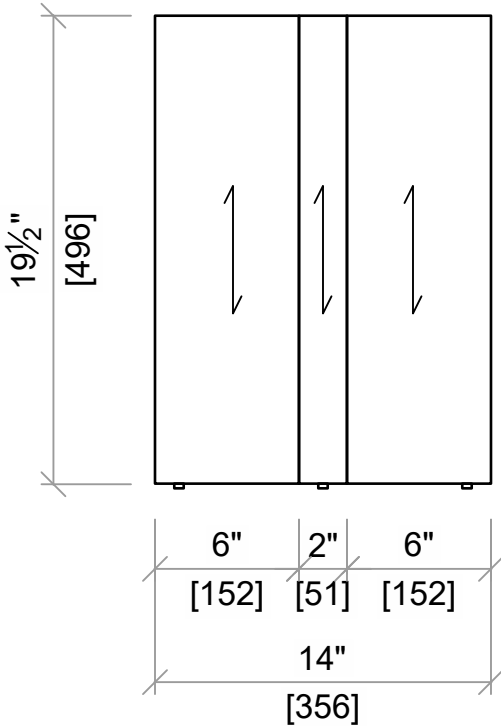

SCALE 1 1/2" = 1' 0"

ISSUED FOR:	DATE:	BY:
DATE ISSUED	03/24/2025	MK

PROJECT TITLE:
WALLER CREEK

ITEM NUMBER:
GR-IF-363

DESCRIPTION:
BEDSIDE TABLE

SPECIFICATIONS:
MATERIAL:
WD-01 EUROPEAN OAK
ST-01 PORTUGAL BEIGE
LIMESTONE

FINISH:
WOOD: BONA NATURALE MATTE
SEALANT
STONE: MATTE ATER RESISTANT
STONE SEALANT

NOTES:
-

JOB NO:	320C
DRAWN BY:	MK/DZ
DATE DRAWN:	3/24/2025
SCALE:	AS NOTED

SHEET:
03